

646.40 DURABLE 100 mm WHITE LINE  
 (ALL LINES WILL INCLUDE EDGE LINE BREAKS AND RADIUS FOR TOWN HIGHWAYS)

ARLINGTON:  
 STA. 10+795.480 - STA. 11+200.0 LT & RT

646.41 DURABLE 100 mm YELLOW LINE  
 (ALL LINES WILL INCLUDE C/L BREAKS FOR TOWN HIGHWAYS) S=SOLID, D=DASHED

ARLINGTON: LT C RT  
 STA. 10+795.480 - STA. 11+200.0 S - S

646.50 DURABLE LETTER OR SYMBOL

ARLINGTON:  
 STA. 10+896.9 LT, "A,H,E,A,D" (5 EA)  
 STA. 10+909.1 LT, "S,T,O,P" (4 EA)


675.50 REMOVING SIGNS  
 AS SHOWN - 3

646.60 TEMPORARY 100 mm WHITE LINE  
 (ALL LINES WILL INCLUDE EDGE LINE BREAKS AND RADIUS FOR TOWN HIGHWAYS)

ARLINGTON:  
 STA. 10+795.480 - STA. 10+816.0 LT & RT

646.61 TEMPORARY 100 mm YELLOW LINE  
 (ALL LINES WILL INCLUDE C/L BREAKS FOR TOWN HIGHWAYS) S=SOLID, D=DASHED

ARLINGTON: LT C RT  
 STA. 10+795.480 - STA. 10+816.0 S - S

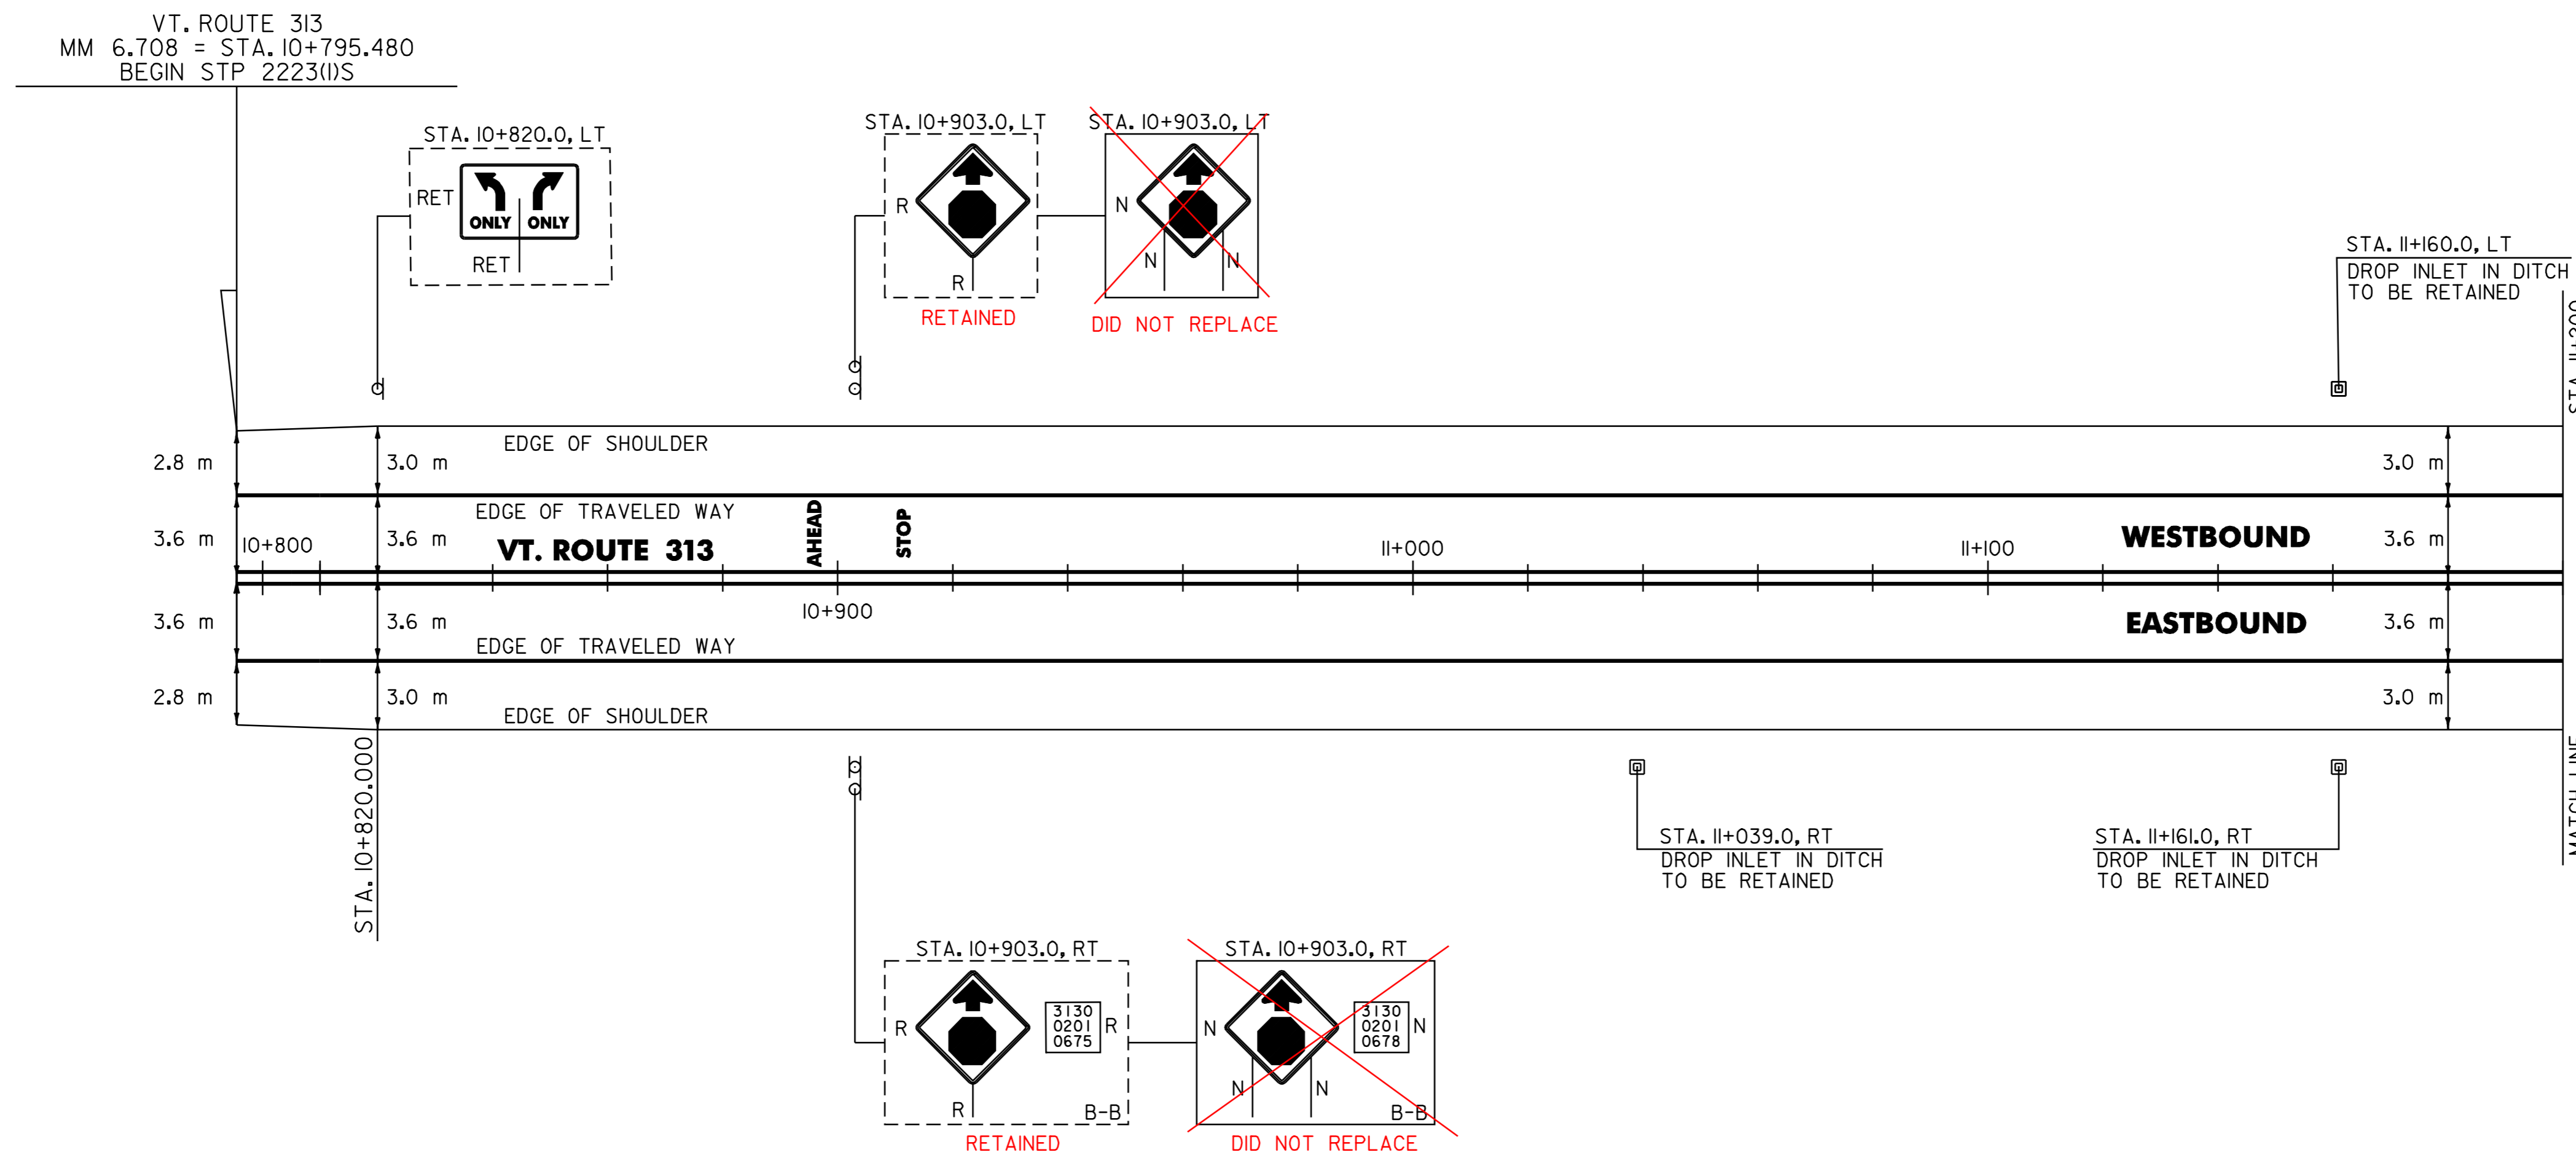

DATUM	
VERTICAL	N/A
HORIZONTAL	N/A

SIGN LEGEND  
 R= REMOVE  
 S= SALVAGE  
 N= NEW  
 RET= RETAIN  
 B-B= BACK TO BACK  
 EXISTING= -----  
 NEW= \_\_\_\_\_

## PAVING PROJECT LAYOUT # 1

SURVEYED BY	N/A	DATE	N/A
DRAWN BY	C.A.K.	DATE	2/01
SQUAD LEADER	T.P.K.		
DESIGN FILE NO.	/pave/99b198/pb198.dgn		
IPARM FILE	pb198101.i	DATE PLOTTED	APR-2007 10:4
PROJ. NAME	ARLINGTON - SUNDERLAND		
PROJ. NO.	STP 2223(I)S		
SHEET	8 OF 16	SHEETS	