

646.40 DURABLE 100 mm WHITE LINE
 (ALL LINES WILL INCLUDE EDGE LINE BREAKS AND RADIUS FOR TOWN HIGHWAYS)


ARLINGTON:
 STA. 11+740.0 - STA. 12+280.0 LT & RT
 STA. 11+740.0 - STA. 11+760.0 LT, DOTTED LINE

646.41 DURABLE 100 mm YELLOW LINE
 (ALL LINES WILL INCLUDE C/L BREAKS FOR TOWN HIGHWAYS) S=SOLID, D=DASHED

ARLINGTON: LT CL RT
 STA. 11+740.0 - STA. 12+038.0 S - S
 STA. 12+038.0 - STA. 12+102.0 S - D
 STA. 12+102.0 - STA. 12+280.0 - D -

675.5 REMOVING SIGNS

AS SHOWN - I

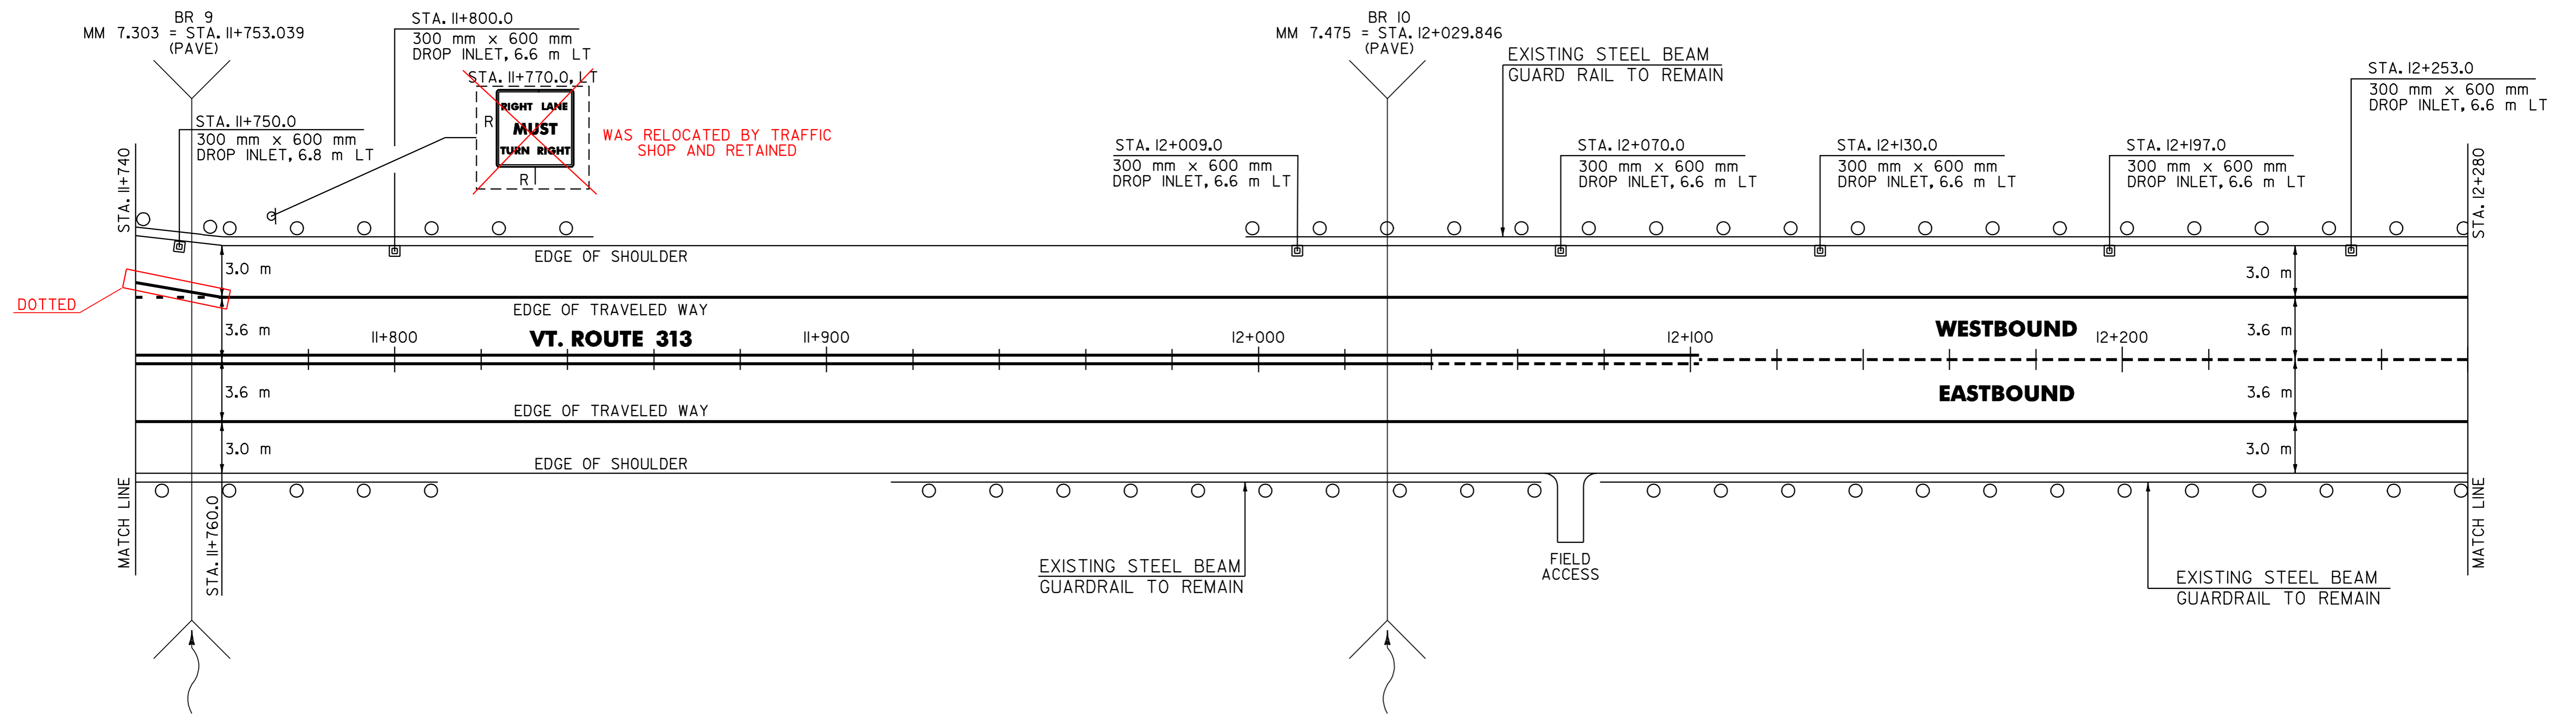

604.42 CHANGE ELEVATION OF DI, CB OR MH

ARLINGTON:
 STA. 11+750.0 LT
 STA. 11+800.0 LT
 STA. 12+009.0 LT
 STA. 12+070.0 LT
 STA. 12+130.0 LT
 STA. 12+197.0 LT
 STA. 12+253.0 LT

616.35 TREATED TIMBER CURB

ARLINGTON:
 STA. 11+740.0 - STA. 11+796.0 LT (56 m)

621.20 STEEL BEAM GUARDRAIL

ARLINGTON:
 STA. 11+740.0 - STA. 11+800.3 RT (60.3 m)
 STA. 11+740.0 - STA. 11+833.6 LT (93.6 m)

621.505 MANUFACTURED TERMINAL SECTION

ARLINGTON:
 STA. 11+800.3 RT
 STA. 11+833.6 LT

621.80 REMOVAL AND DISPOSAL OF GUARDRAIL

ARLINGTON:
 STA. 11+740.0 - STA. 11+810.0 RT (70 m)
 STA. 11+740.0 - STA. 11+844.0 LT (104 m)

SIGN LEGEND
 R= REMOVE
 S= SALVAGE
 N= NEW
 RET= RETAIN
 B-B= BACK TO BACK
 EXISTING= - - - - -
 NEW= _____

PAVING PROJECT LAYOUT # 3

SURVEYED BY N/A DATE N/A
 DRAWN BY C.A.K. DATE 2/01
 SQUAD LEADER T.P.K.
 DESIGN FILE NO. /pave/99b198/pb198.dgn
 IPARM FILE pb198103.i DATE PLOTTED APR-2007 10:4
 PROJ. NAME ARLINGTON - SUNDERLAND
 PROJ. NO. STP 2223(I)S
 SHEET 10 OF 16 SHEETS

DATUM
 VERTICAL N/A
 HORIZONTAL N/A