




FILE NAME: s:\projects\2004\contract\11\cover.dgn
 DATE/TIME: 2/23/2004 12:22:58
 DESIGNED BY: T. KARIS
 CHECKED BY: D. EMERICH
 ESTIMATED BY: D. EMERICH
 CHECKED BY: D. GOZALKOWSKI
 DRAFTER BY: D. GOZALKOWSKI
 CHECKED BY: I. BURTNICK
 DATE: 2/04

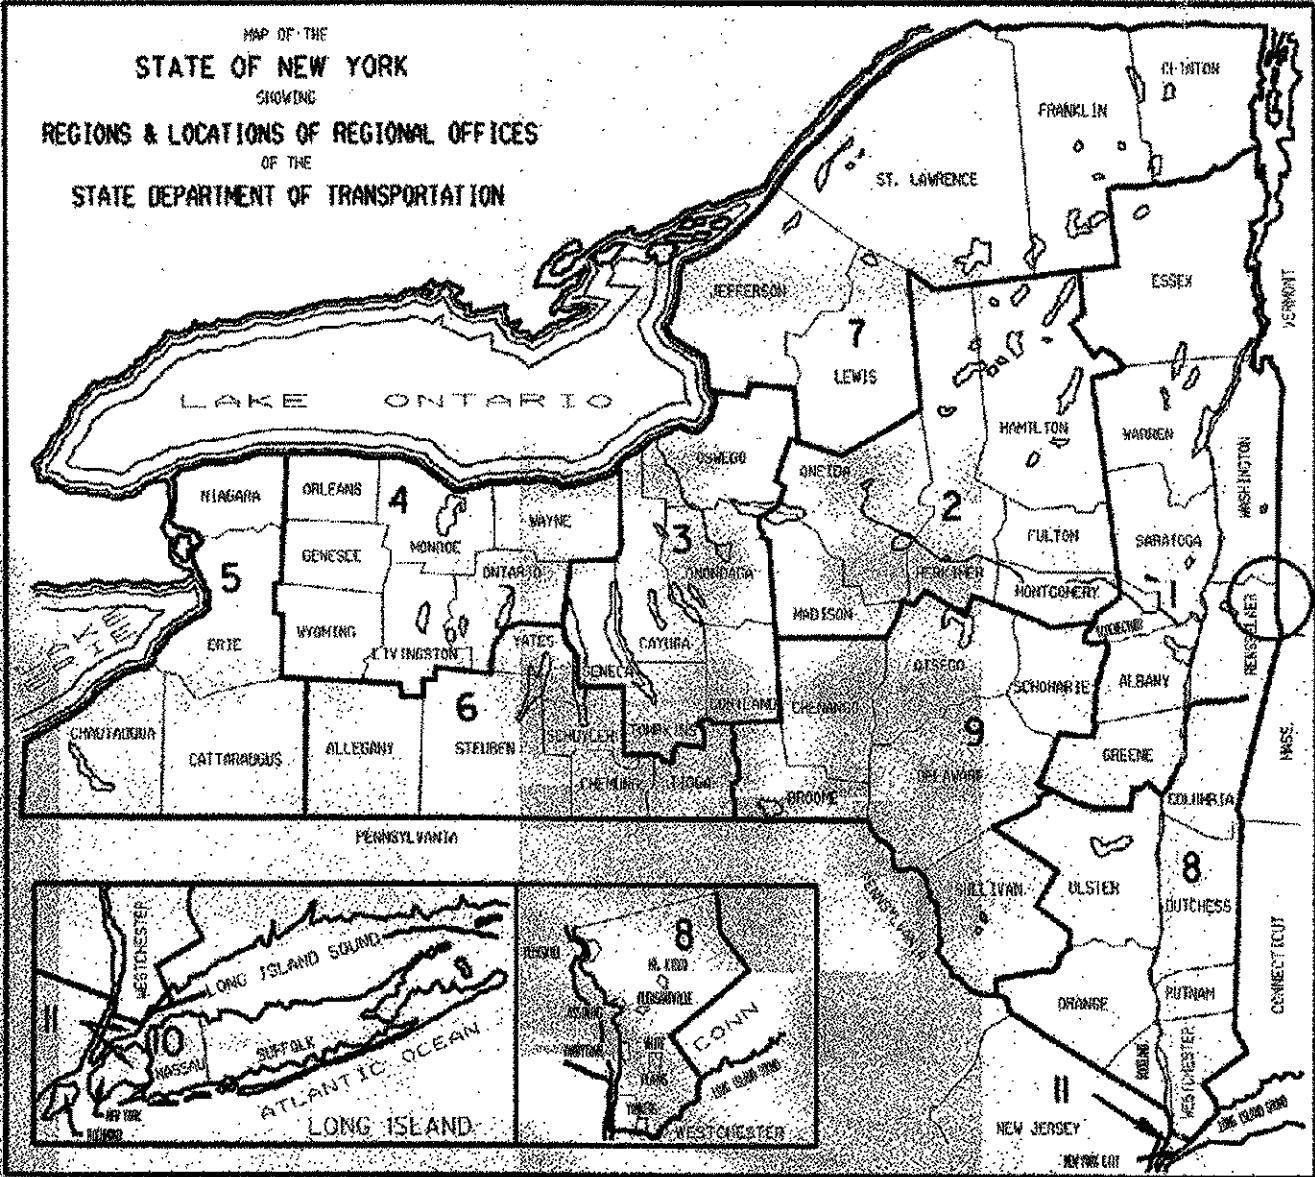

STATE OF VERMONT
AGENCY OF TRANSPORTATION

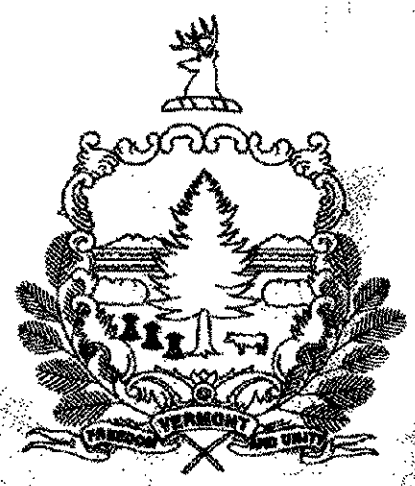

STATE OF NEW YORK
DEPARTMENT OF TRANSPORTATION
OFFICE OF ENGINEERING

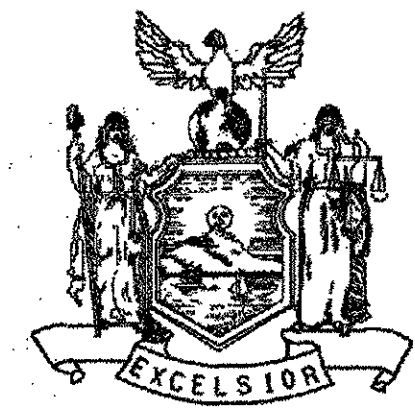

NEW CONSTRUCTION OF THE BENNINGTON CONNECTOR
IN THE TOWN OF HOOSICK
S.H. 98-2
RENSELAER COUNTY, NEW YORK
D.P.I. 0146(1) C/1

PROJECT LOCATION
 THE SECTION OF THE PROPOSED BENNINGTON CONNECTOR TO BE CONSTRUCTED UNDER THIS CONTRACT IS LOCATED IN THE TOWN OF HOOSICK, RENSSELAER COUNTY, NEW YORK, APPROXIMATELY 2.0 KM WEST OF THE NEW YORK/VERMONT STATE LINE. THE PROPOSED PROJECT WILL BEGIN ON N.Y.S. ROUTE 7 AND WILL PROCEED IN A NORTHEASTERLY DIRECTION CONNECTING N.Y.S. ROUTE 7 WITH THE EXISTING BENNINGTON BYPASS PREVIOUSLY CONSTRUCTED BY OTHERS. IT WILL PROVIDE ONE WESTBOUND THROUGH LANE, ONE EASTBOUND THROUGH LANE AND AN INTERSECTION PROVIDING ACCESS TO N.Y.S. ROUTE 7 AND VERMONT ROUTE 279.

CONNECTOR DESIGN YEAR (2020)
TRAFFIC DATA

ESTIMATED TRAFFIC		
AADT	DHV	DDHV
6600	840	435

DESIGN SPEED: 100 km/h
PERCENT TRUCKS: 7%

CONTRACTOR'S NAME _____
 AWARD DATE _____
 COMPLETION DATE _____
 FINAL ACCEPTANCE DATE _____
 REGIONAL DIRECTOR _____
 ENGINEER IN CHARGE _____
 FINAL COST TOTAL _____
 FISCAL SHARE _____ COST(S) _____

RECORD PLANS

CONTRACTOR: RIFENBURG CONSTRUCTION, INC.
TROY, NY

RESIDENT ENGINEER: RON LEMAIRE

CONSTRUCTION BEGAN: JULY 26, 2004

CONSTRUCTION COMPLETED: JULY 7, 2005


RECORD PLANS BY: RON LEMAIRE & JUDY GILMORE

I HEREBY CERTIFY THAT ALL THE CONSTRUCTION REQUIRED BY THIS SET OF DRAWINGS HAS BEEN ACCOMPLISHED AS INDICATED HEREIN.


BY: *[Signature]*, RESIDENT ENGINEER
DATE: 07/24/2007

NOTE: ANY FURTHER INFORMATION CONCERNING FINAL QUANTITIES, AMOUNTS OR OTHER DETAILS RELATIVE TO THIS PROJECT MAY BE FOUND AT CENTRAL FILES AND IN THE ELECTRONIC ARCHIVES.

DATUM
 VERTICAL NAVD 88
 HORIZONTAL NAD 83 (1992)

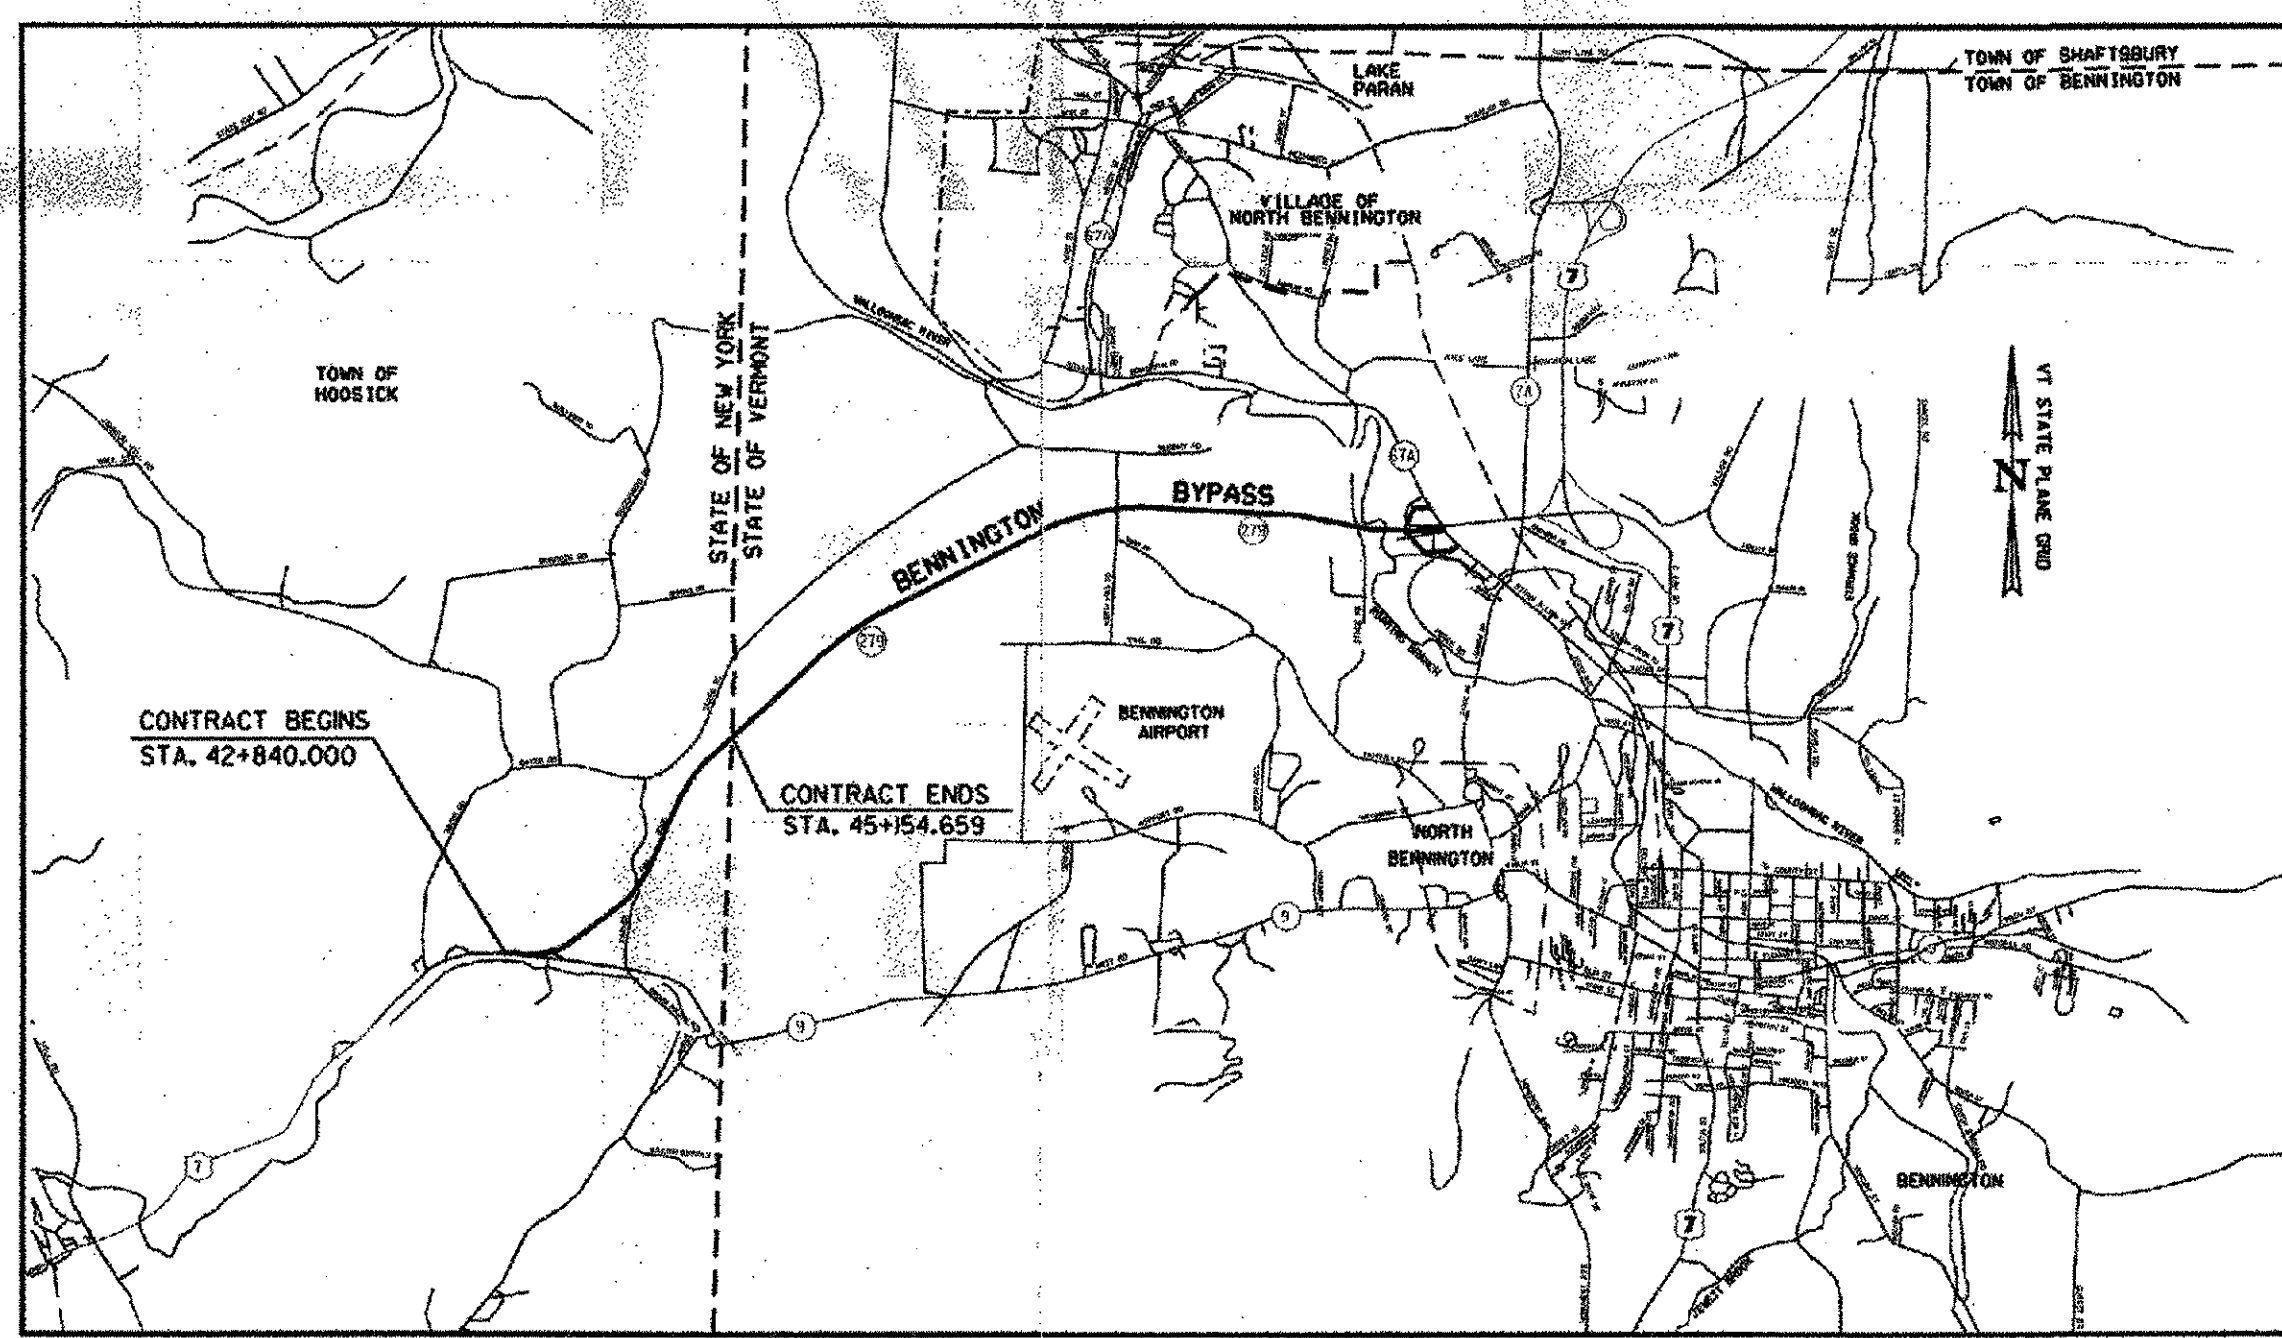

PROJECT LOCATION

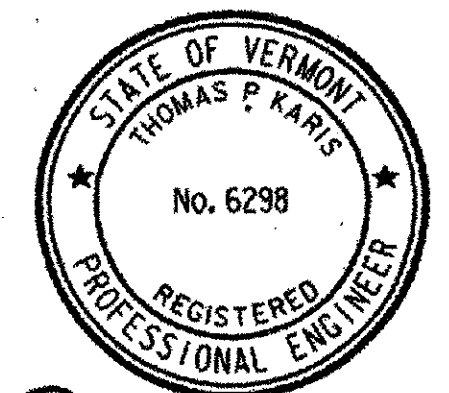

PREPARED AND RECOMMENDED BY
[Signature] 2/23/04
 THOMAS P. KARIS
 CLOUGH, HARBOUR & ASSOCIATES LLP
 ENGINEERS, SURVEYORS, PLANNERS & LANDSCAPE ARCHITECTS
 VT, P.E. No. 6298



PREPARED AND RECOMMENDED BY
[Signature] 2/23/04
 THOMAS P. KARIS
 CLOUGH, HARBOUR & ASSOCIATES LLP
 ENGINEERS, SURVEYORS, PLANNERS & LANDSCAPE ARCHITECTS
 N.Y.S. P.E. No. 068357

REQUIREMENTS FOR NEW YORK STATE

NYS DOT STANDARD SHEETS
 M203-1, M203-2, M203-4, M203-5, M209-1, M209-2, M209-3, M209-4, M209-5, M209-6, M209-7, M209-9, M403-1, M603-3R1, M604-5R1, M604-8R1, M606-3, M606-5R1, M606-6, M607-2, M609-2R1, M609-4R1, M611-1, M619-3R1, M619-4, M619-5, M625-1R1, M645-5I, M645-52, M645-55, M645-56, M645-70, M645-72, M645-76, M646-4, M646-5, M655-10R2, M655-11R1, M680-1, M680-2, M680-3, M680-4, M680-5, M680-6, M680-7, M680-8R2, M680-9, M680-10, M680-12, M680-13R2, M680-14R1, M680-15R1, M680-16, M680-17, M685-1, M685-2R1, M685-5R1

ALL WORK CONTEMPLATED UNDER THIS CONTRACT IS TO BE COVERED BY AND IN CONFORMITY WITH THE STANDARD SPECIFICATIONS (METRIC UNITS) OF JANUARY 2, 2002, EXCEPT AS MODIFIED ON THESE PLANS AND IN THE ITEMIZED PROPOSAL.

REQUIREMENTS FOR THE STATE OF VERMONT

THESE PLANS ARE SUBJECT TO SUCH ENGINEERING CHANGES AS MAY BE REQUIRED BY THE FEDERAL HIGHWAY ADMINISTRATION OR THE DIRECTOR OF PROGRAM DEVELOPMENT.

CONSTRUCTION IS TO BE CARRIED ON IN ACCORDANCE WITH THESE PLANS AND THE STANDARD SPECIFICATIONS FOR CONSTRUCTION DATED 2001, AS APPROVED BY THE FEDERAL HIGHWAY ADMINISTRATION ON JANUARY 4, 2001 FOR USE ON THIS PROJECT, INCLUDING ALL SUBSEQUENT REVISIONS AND SUCH REVISED SPECIFICATIONS AND SPECIAL PROVISIONS AS ARE INCORPORATED IN THESE PLANS.



APPROVED *[Signature]* DATE 3/10/04
 DIRECTOR OF PROGRAM DEVELOPMENT

NEW YORK STATE DEPARTMENT OF TRANSPORTATION

APPROVED *[Signature]* DATE March 15, 2004
 THOMAS C. WERNER, P.E. ACTING IN HIS CAPACITY AS REGIONAL DIRECTOR

CHA CLOUGH, HARBOUR & ASSOCIATES LLP
 ENGINEERS, SURVEYORS, PLANNERS & LANDSCAPE ARCHITECTS
 111 WINNERS CIRCLE ALBANY, NEW YORK 12208
 P.O. BOX 5269 518-453-4500

BENNINGTON CONNECTOR S.H. 98-2

P.I.N. 1306.60

WHITEHOUSE BRIDGE - VERMONT STATE LINE S.H. 1426

RENSELAER COUNTY

FED. ROAD REG. NO.	STATE	SHEET NO.	TOTAL SHEETS
	NY	1	92

FEDERAL AID PROJECT NO. 0146001

CAPITAL PROJECT IDENTIFICATION NO. 1306.60

INDEX AND LEGEND ON SHEET NO. 2