



FED. ROAD REG. NO.	STATE	FEDERAL AID PROJECT NO.	SHEET NO.	TOTAL SHEETS
I	N.Y.	0146001	22	92
BENNINGTON CONNECTOR		S.H. 98-2		
P.I.N. 1306.60				
WHITEHOUSE BRIDGE - VERMONT STATE LINE		S.H. 1426		
RENSSELAER COUNTY				


FILE NAME = u:\5116\project\contract\mpt\mpt.dgn  
 DATE/TIME = 2/23/2004  
 USER = 2225  
 IN CHARGE OF I. KARIS DESIGNED BY D. EMERICH CHECKED BY D. GOZALKOWSKI ESTIMATED BY D. EMERICH  
 DRAFTED BY D. GOZALKOWSKI CHECKED BY C. KAHLBAUGH DATE 2/04  
 I. BURTNICK

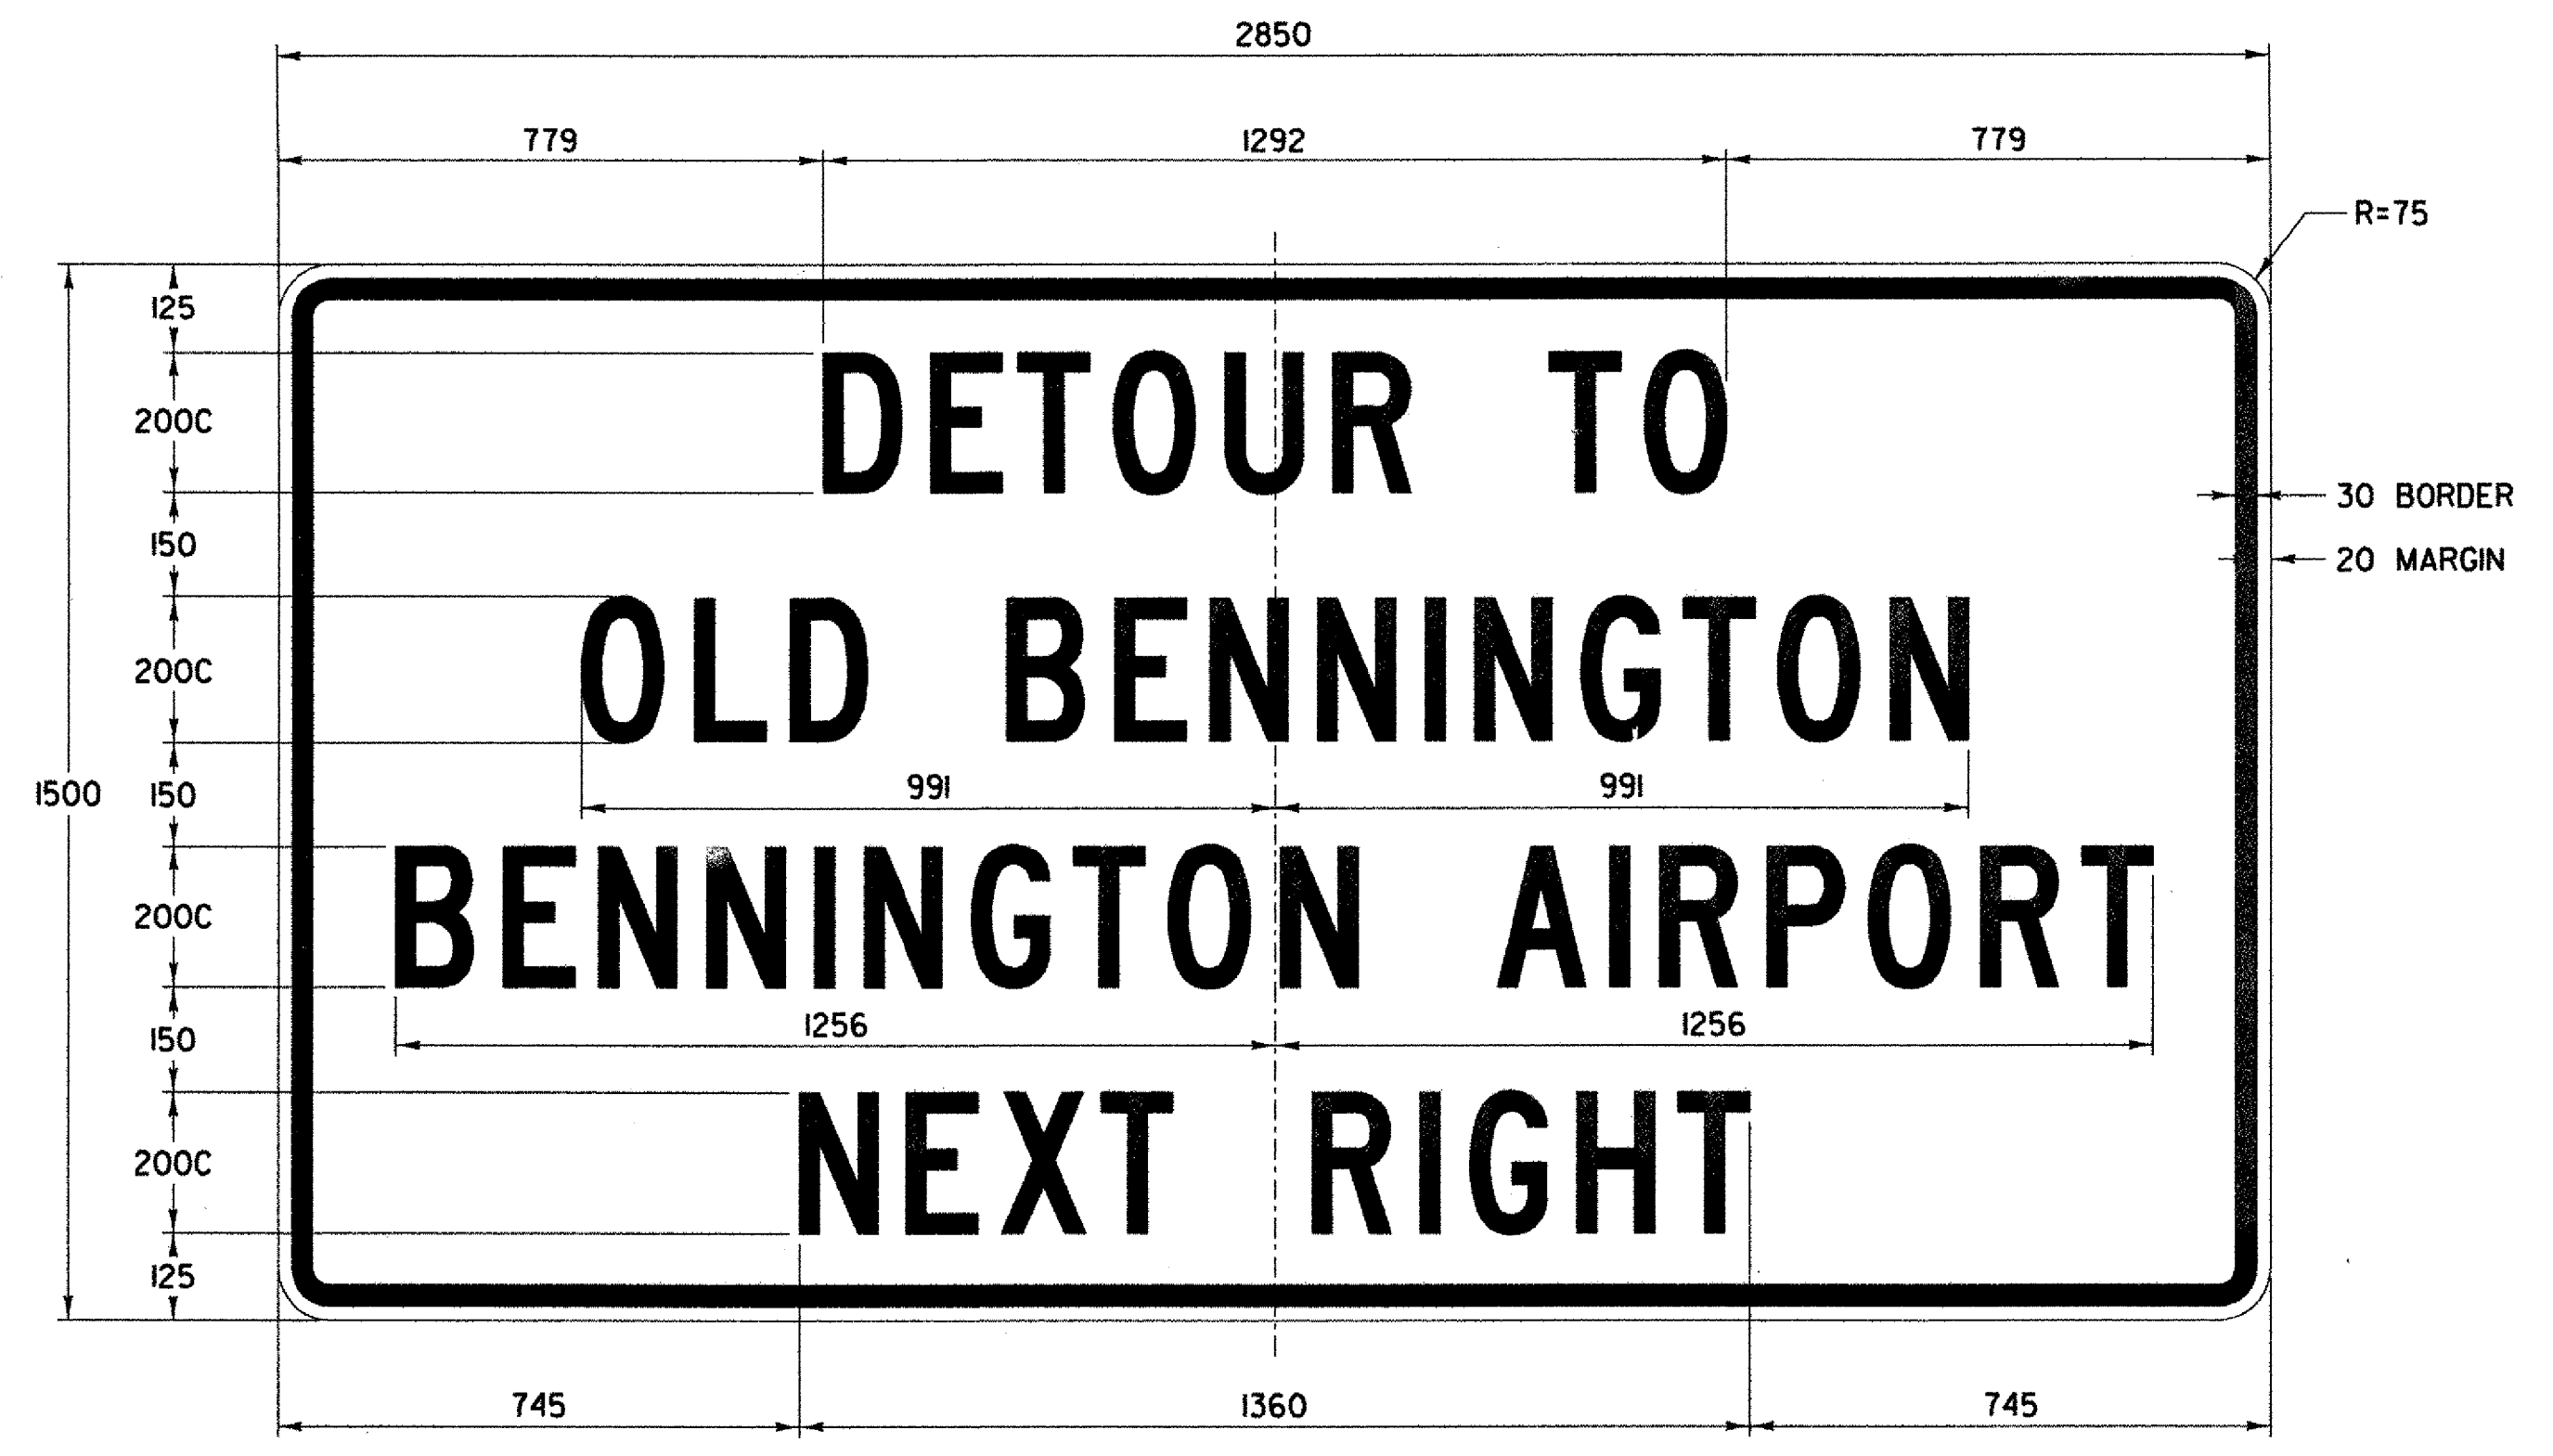


COLOR: BLACK BORDER & TEXT (REFLECTORIZED)  
ORANGE BACKGROUND (REFLECTORIZED)

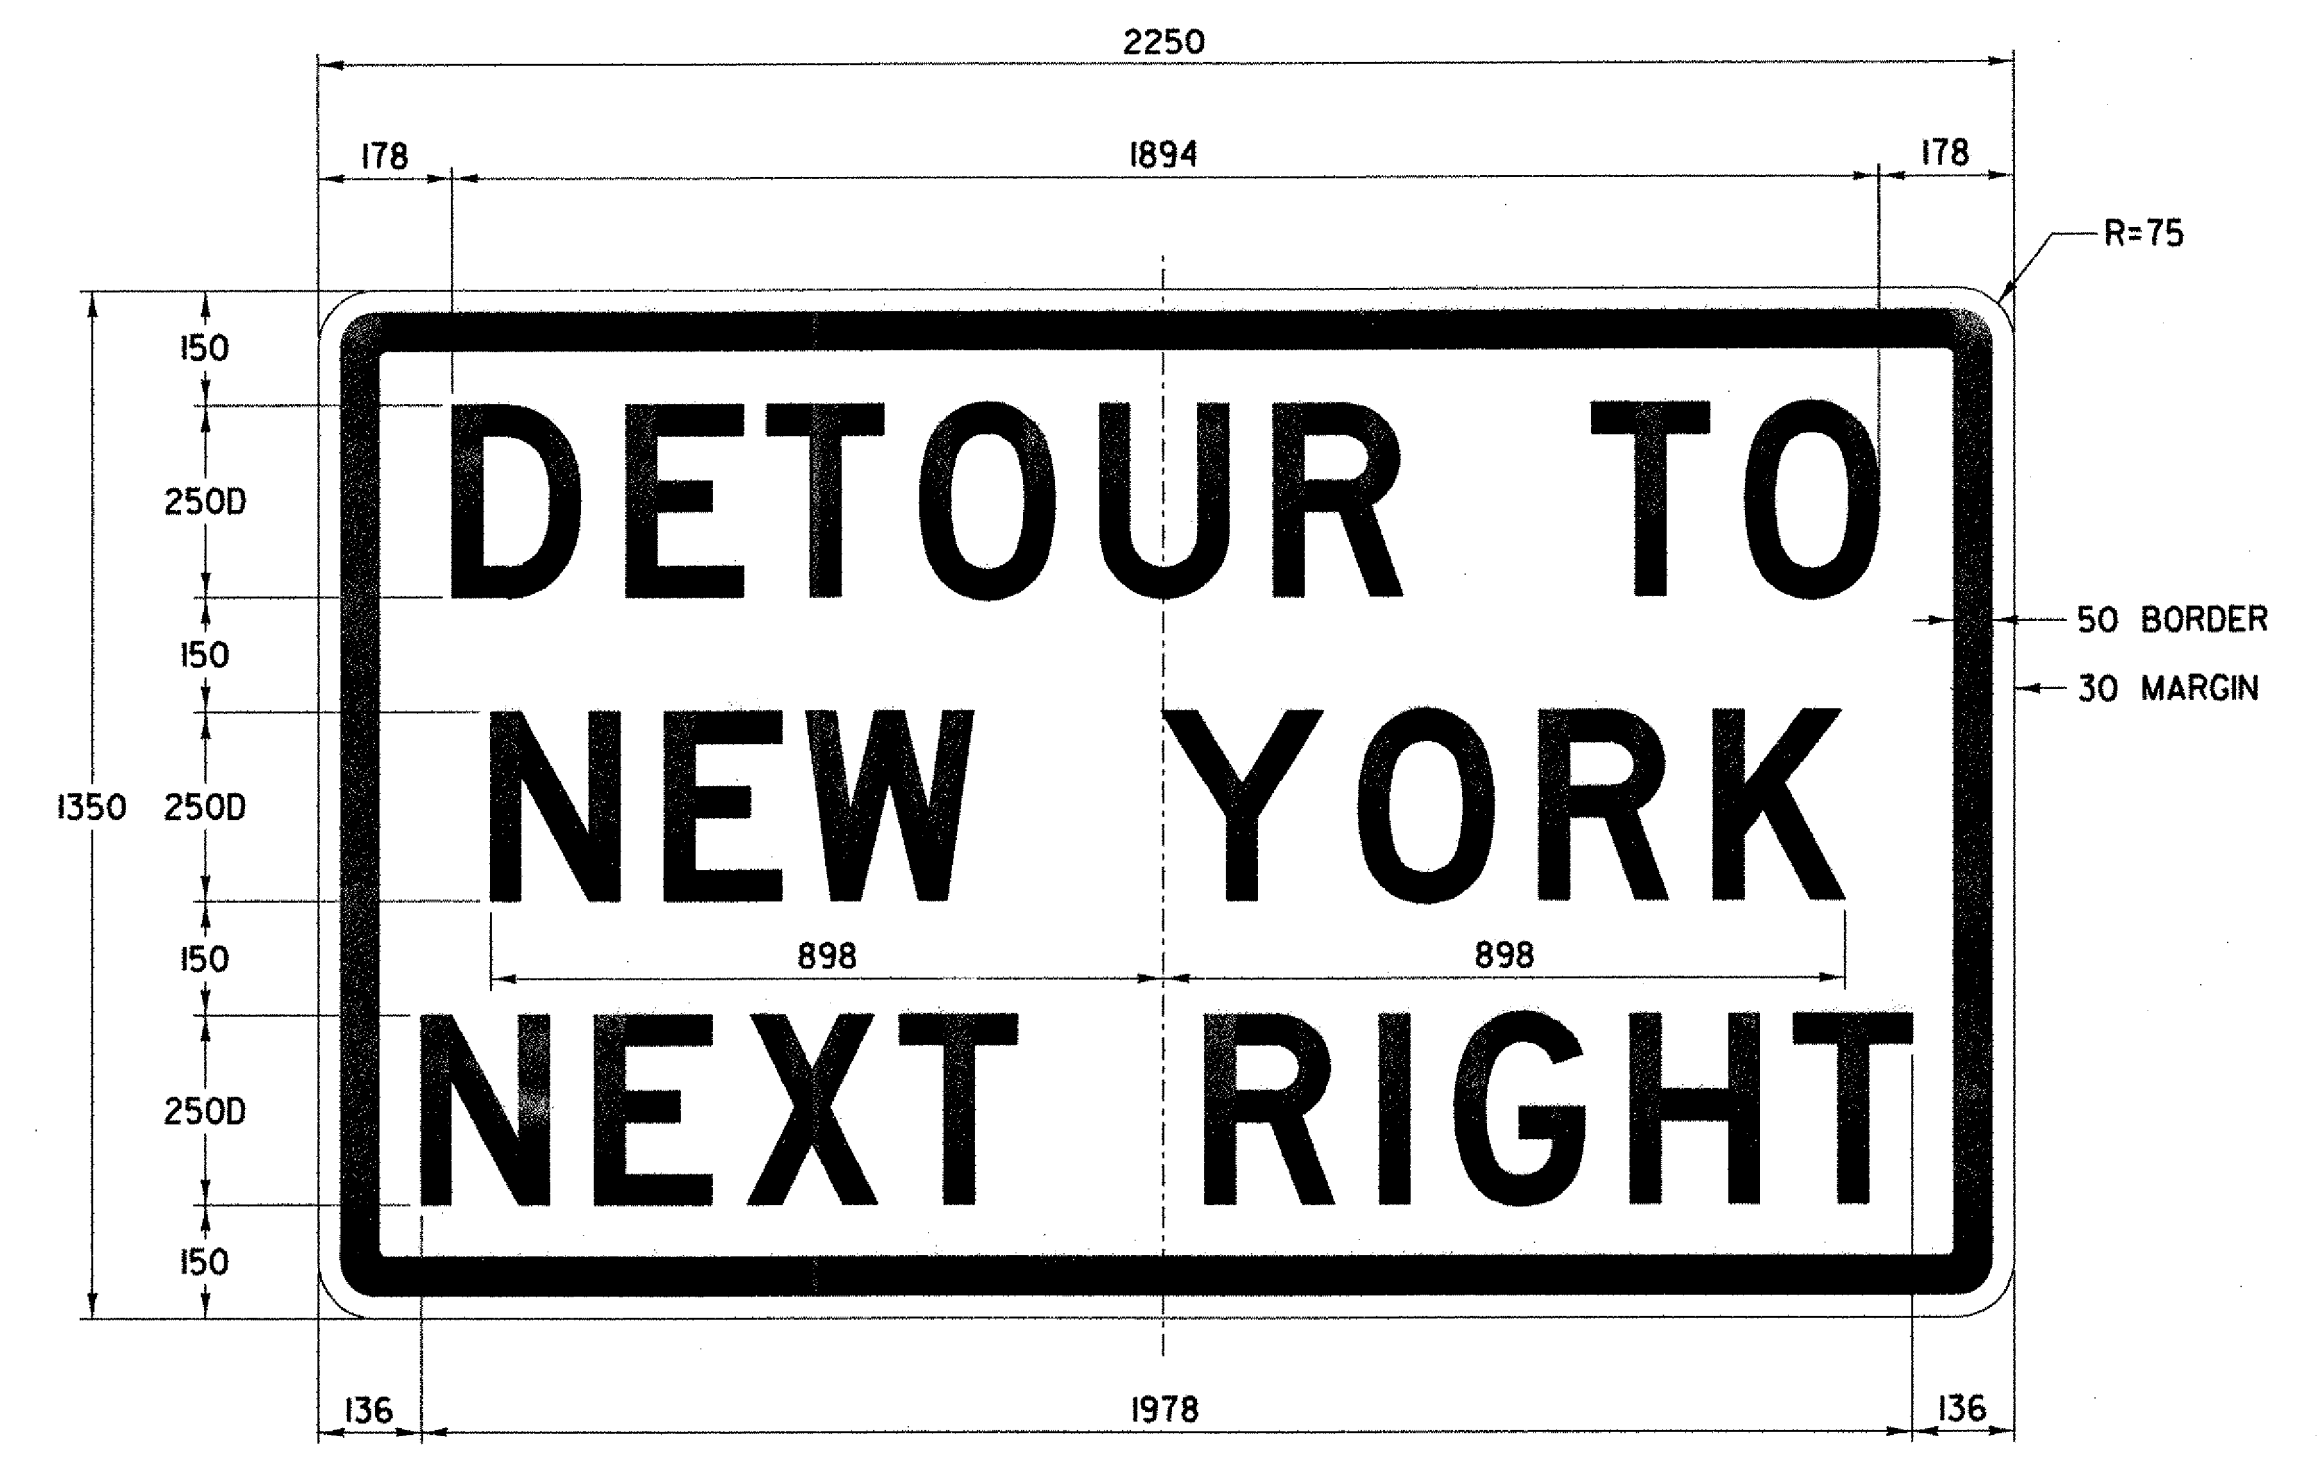

COLOR: BLACK BORDER & TEXT (REFLECTORIZED)  
ORANGE BACKGROUND (REFLECTORIZED)

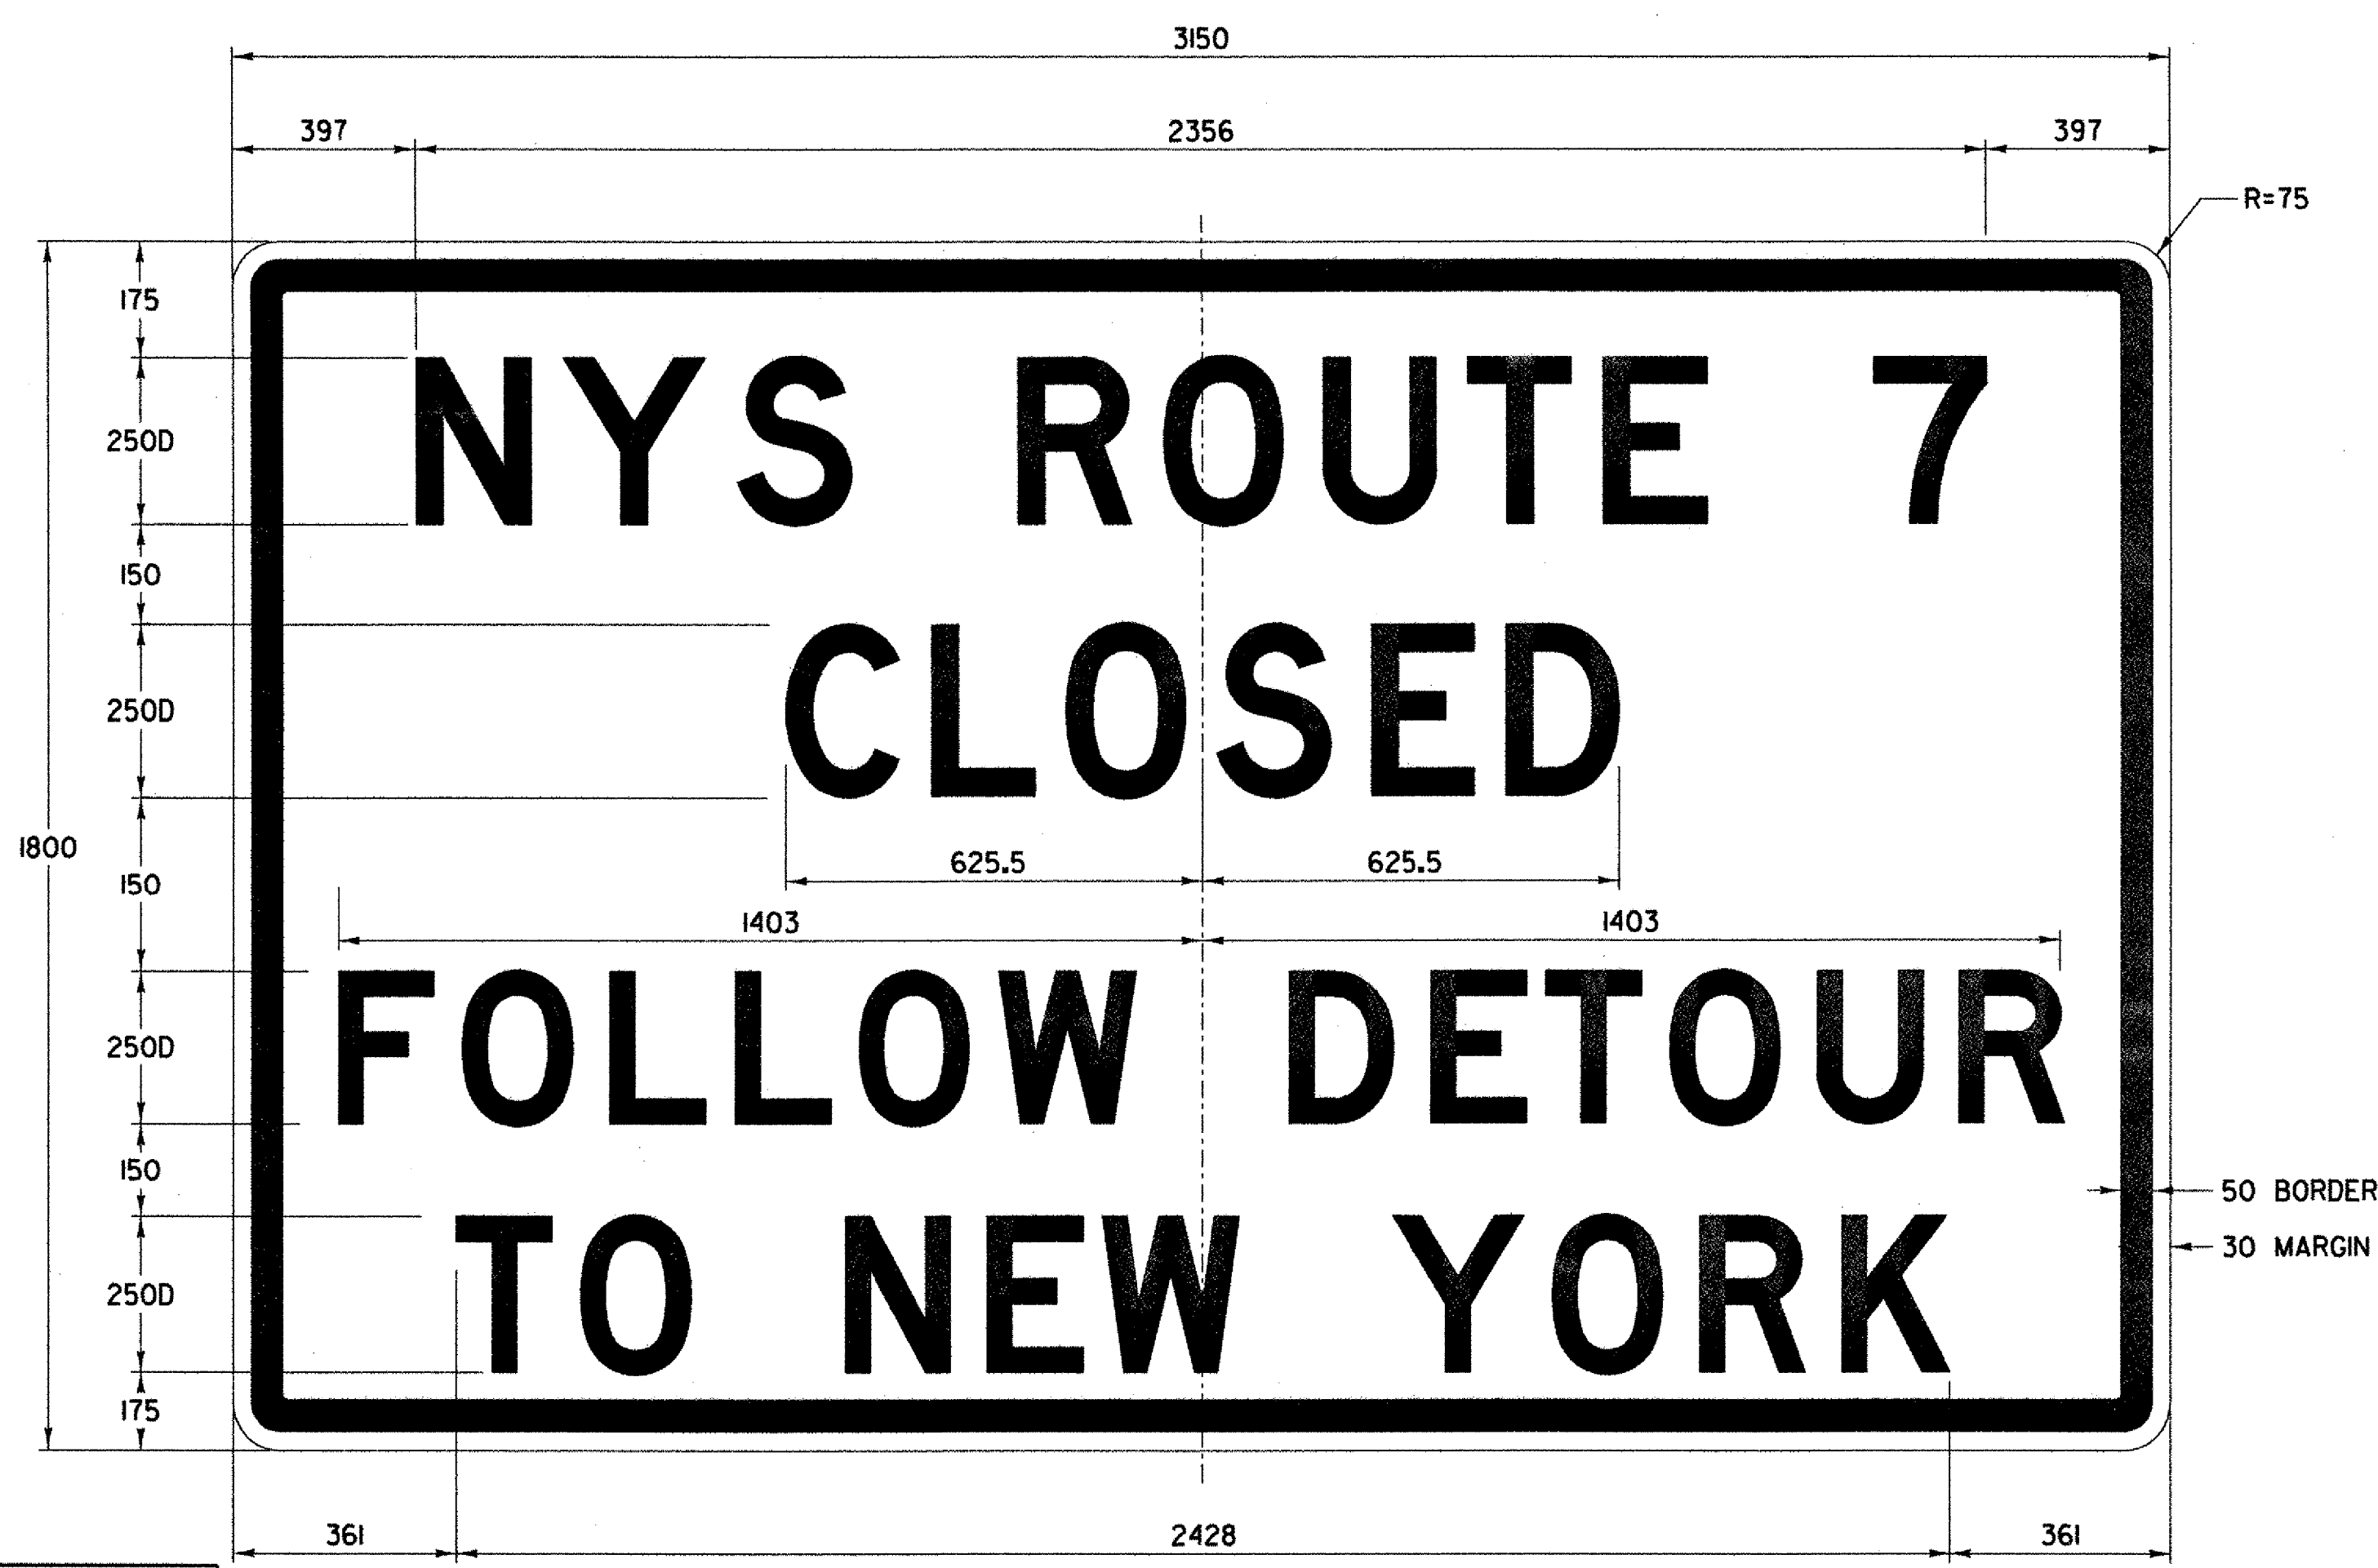

COLOR: BLACK BORDER & TEXT (REFLECTORIZED)  
ORANGE BACKGROUND (REFLECTORIZED)

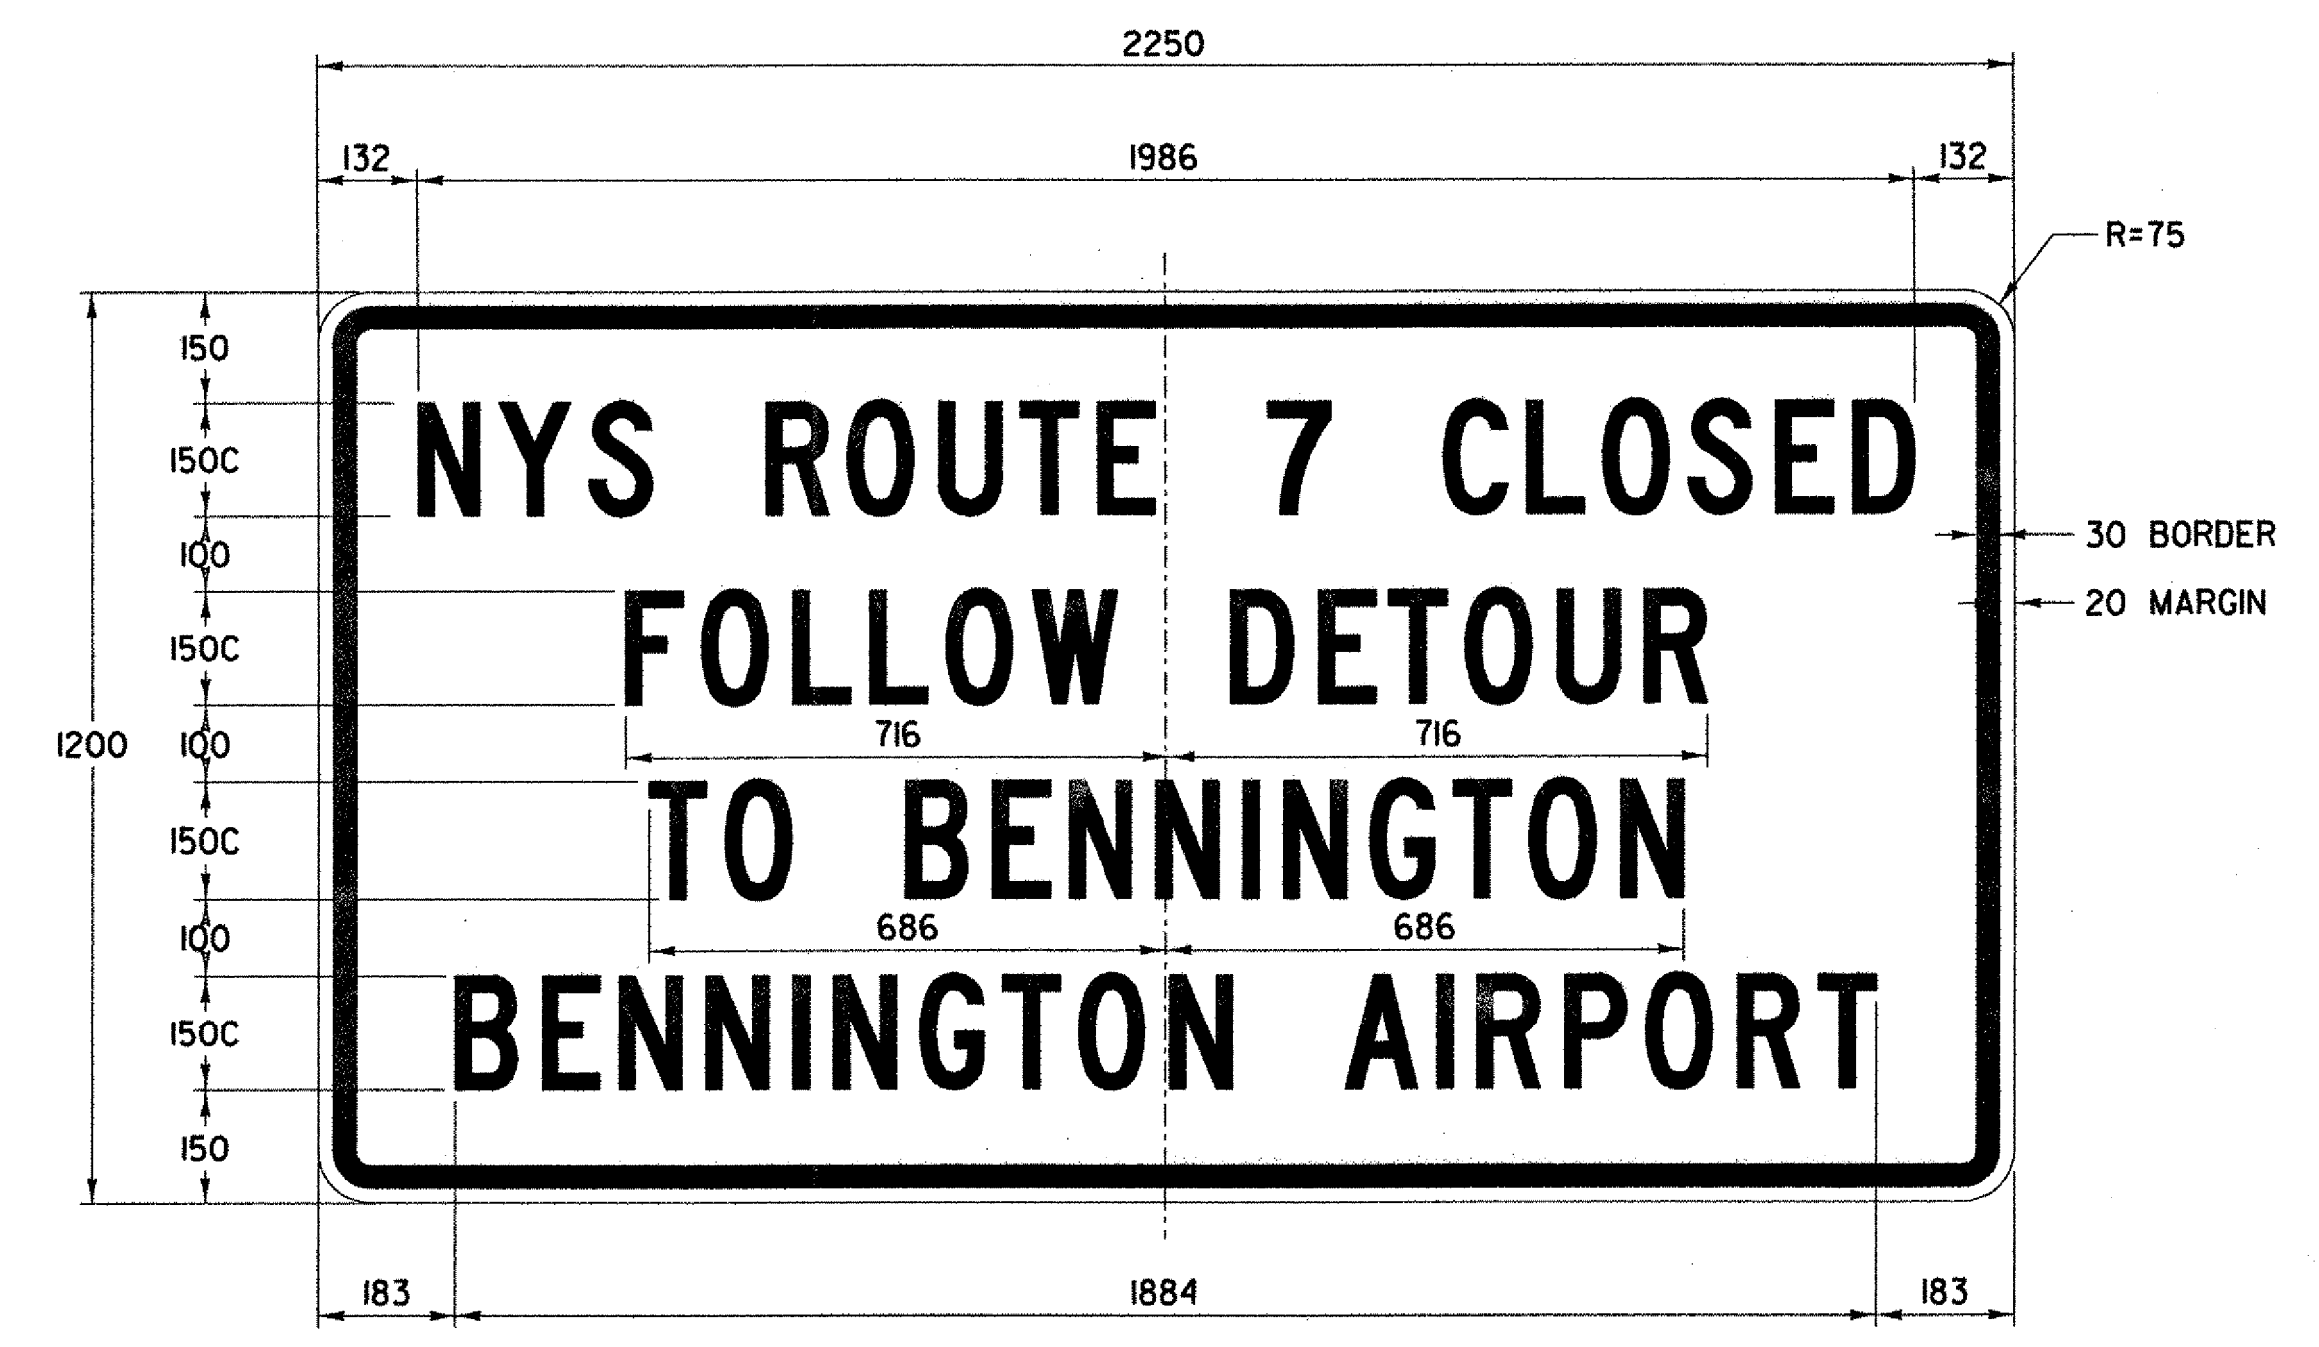

COLOR: BLACK BORDER & TEXT (REFLECTORIZED)  
ORANGE BACKGROUND (REFLECTORIZED)

DATUM	
VERTICAL	NAVD 88
HORIZONTAL	NAD 83 (1992)

DETOUR NOT USED

NOTE:  
ALL DIMENSIONS IN MILLIMETERS  
UNLESS OTHERWISE NOTED.

<b>MAINTENANCE AND PROTECTION OF TRAFFIC</b>	SURVEYED BY	C.H.A. & V.S.E.	DATE	12/93
	DESIGNED BY	D.W.E.	DATE	2/04
	DRAWN BY	C.A.K.	DATE	2/04
	CHECKED BY	T.P.K.	DATE	2/04
	DESIGN FILE NO.	NYTSD4.DGN		
PROJ. NAME	BENNINGTON - HOOSICK D.P.I. 0146(1) C/1			
PROJ. NO.	P.I.N. 1306.60			
SHEET	22 OF 92	DWG NO.	MPT-4	