
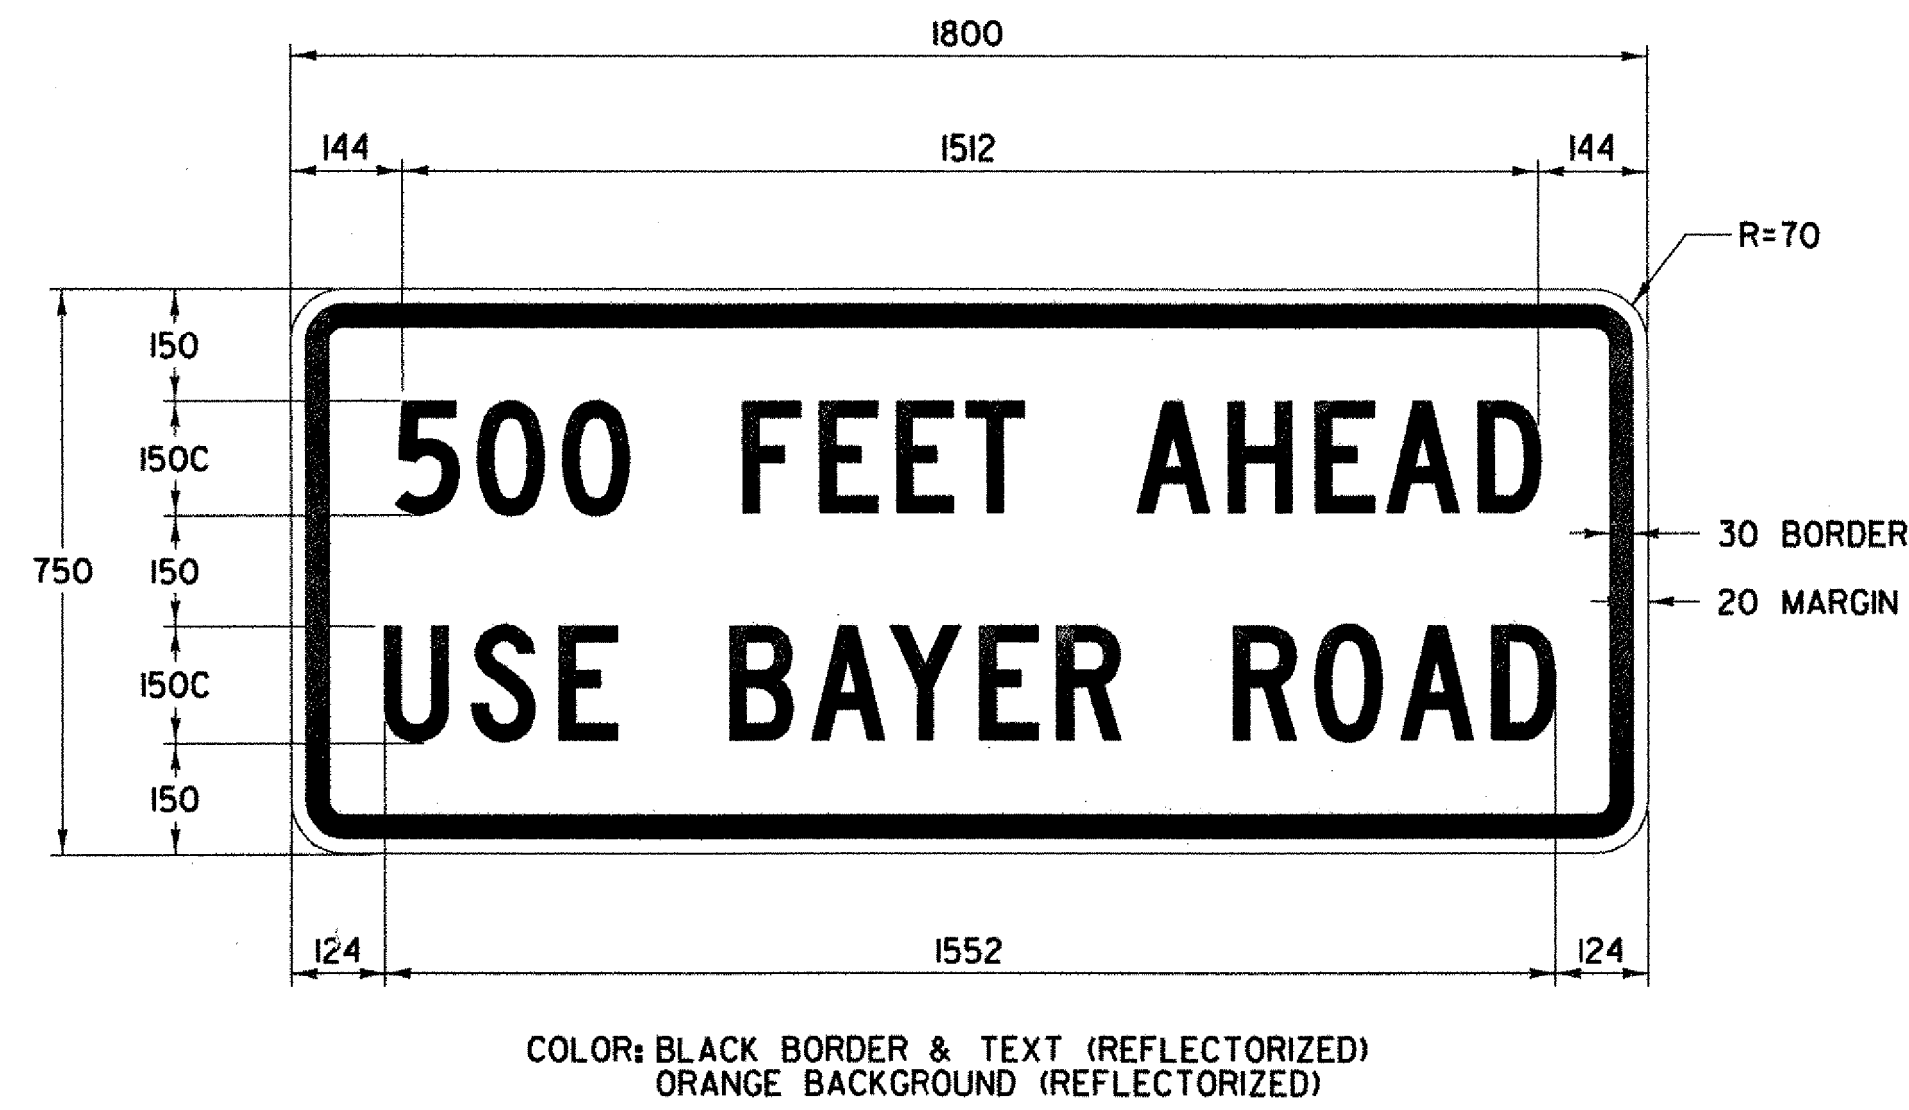
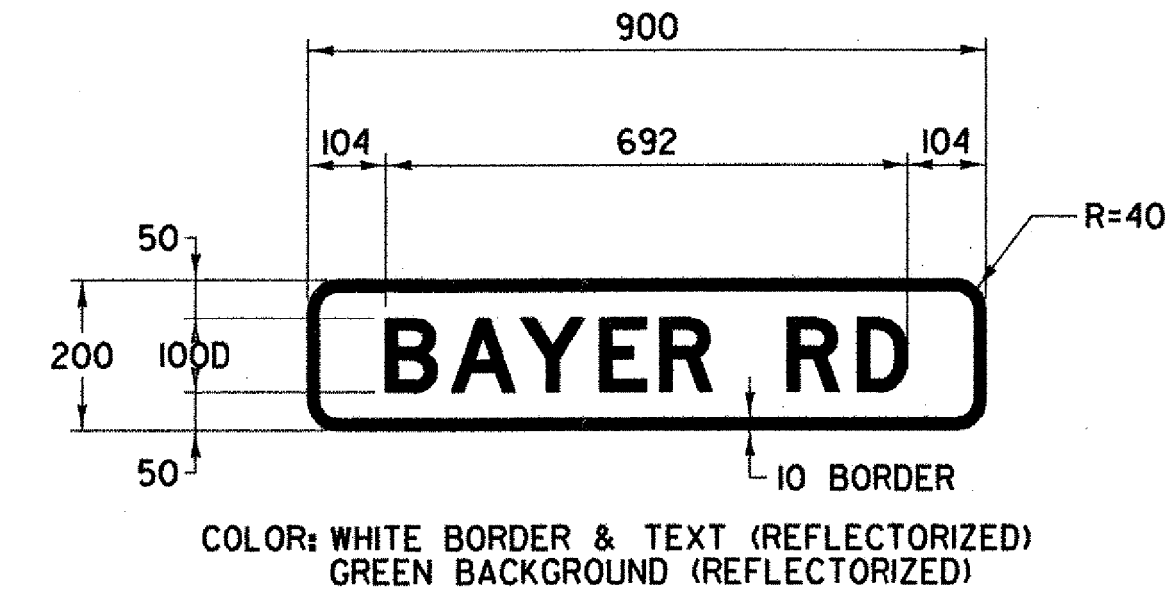


FED. ROAD REG. NO.	STATE	FEDERAL AID PROJECT NO.	SHEET NO.	TOTAL SHEETS
1	N.Y.	0146001	24	92
BENNINGTON CONNECTOR S.H. 98-2				
P.I.N. 1306.60				
WHITEHOUSE BRIDGE - VERMONT STATE LINE S.H. 1426				
RENSSELAER COUNTY				

FILE NAME = h:\5116\mtdo\contract1\mpt266.dgn  
 DATE/TIME = 2/23/2004  
 USER = 2225  
 IN CHARGE OF I. KARI DESIGNED BY D. EMERICH CHECKED BY D. EMERICH ESTIMATED BY D. EMERICH CHECKED BY D. EMERICH DRAFTED BY D. GOZALKOWSKI CHECKED BY D. GOZALKOWSKI DATED BY C. KAHLBAUGH CHECKED BY I. BURTNICK DATE 2/04

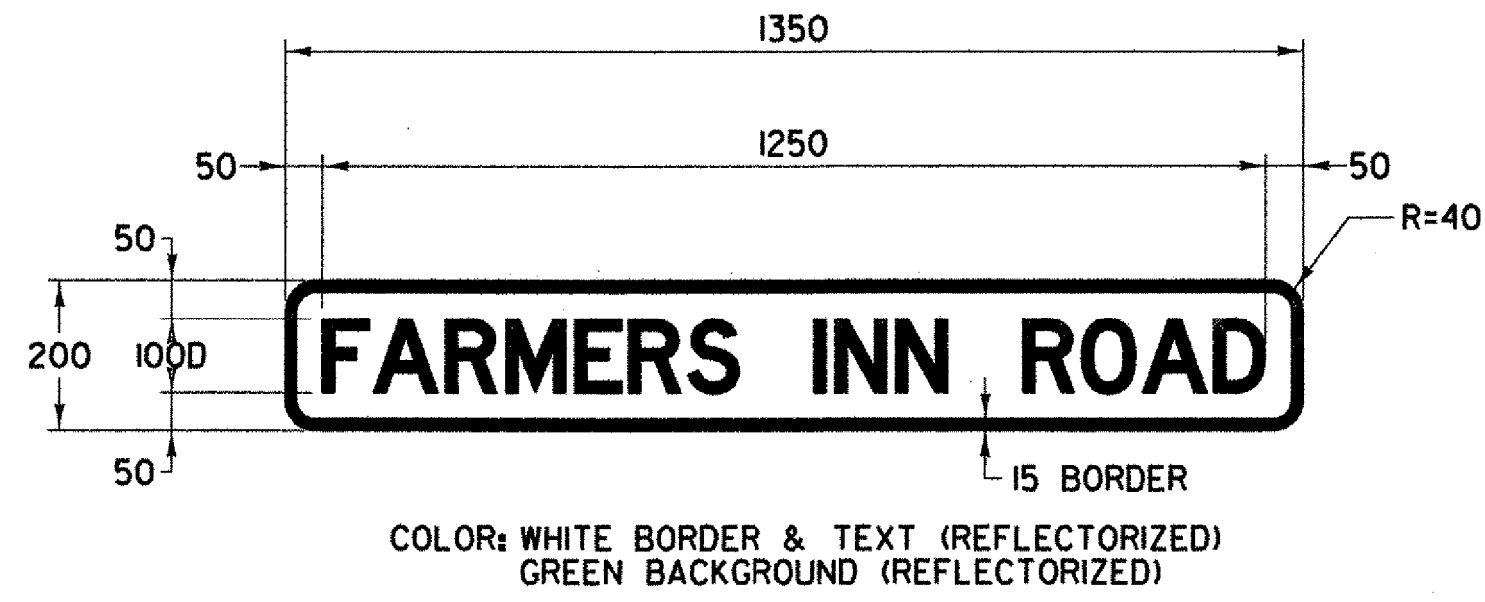

DETOUR NOT USED

DATUM	
VERTICAL	NAVD 88
HORIZONTAL	NAD 83 (1992)

NOTE:  
ALL DIMENSIONS IN MILLIMETERS  
UNLESS OTHERWISE NOTED.

<b>MAINTENANCE AND PROTECTION OF TRAFFIC</b>	SURVEYED BY <u>C.H.A. &amp; V.S.E.</u> DATE <u>12/93</u>
	DESIGNED BY <u>D.W.E.</u> DATE <u>2/04</u>
	DRAWN BY <u>C.A.K.</u> DATE <u>2/04</u>
	CHECKED BY <u>T.P.K.</u> DATE <u>2/04</u>
	DESIGN FILE NO. <u>NYTSD6.DGN</u>
PROJ. NAME <u>BENNINGTON - HOOSICK D.P.I. 0146(1) C/1</u>	
PROJ. NO. <u>P.I.N. 1306.60</u>	
SHEET 24 OF 92	DWG NO. MPT-6