


FED. ROAD REG. NO.	STATE	FEDERAL AID PROJECT NO.	SHEET NO.	TOTAL SHEETS
1	N.Y.	0146001	27	92
BENNINGTON CONNECTOR S.H. 98-2				
P.I.N. 1306.60				
WHITEHOUSE BRIDGE - VERMONT STATE LINE S.H. 1426				
RENSSELAER COUNTY				

FILE NAME: \\s11515\projects\contract\15115\15115.mxd
 DATE/TIME USER: 2/25/04 11:22:55
 IN CHARGE OF: I. KARS
 DESIGNED BY: D. EMERICH
 CHECKED BY: D. EMERICH
 ESTIMATED BY: D. GOZALKOWSKI
 DRAFTED BY: C. KAHLBAUGH
 CHECKED BY: C. KAHLBAUGH
 DATE: 2/04



SEE DWG. CSP-4

SEE DWG. CSP-5

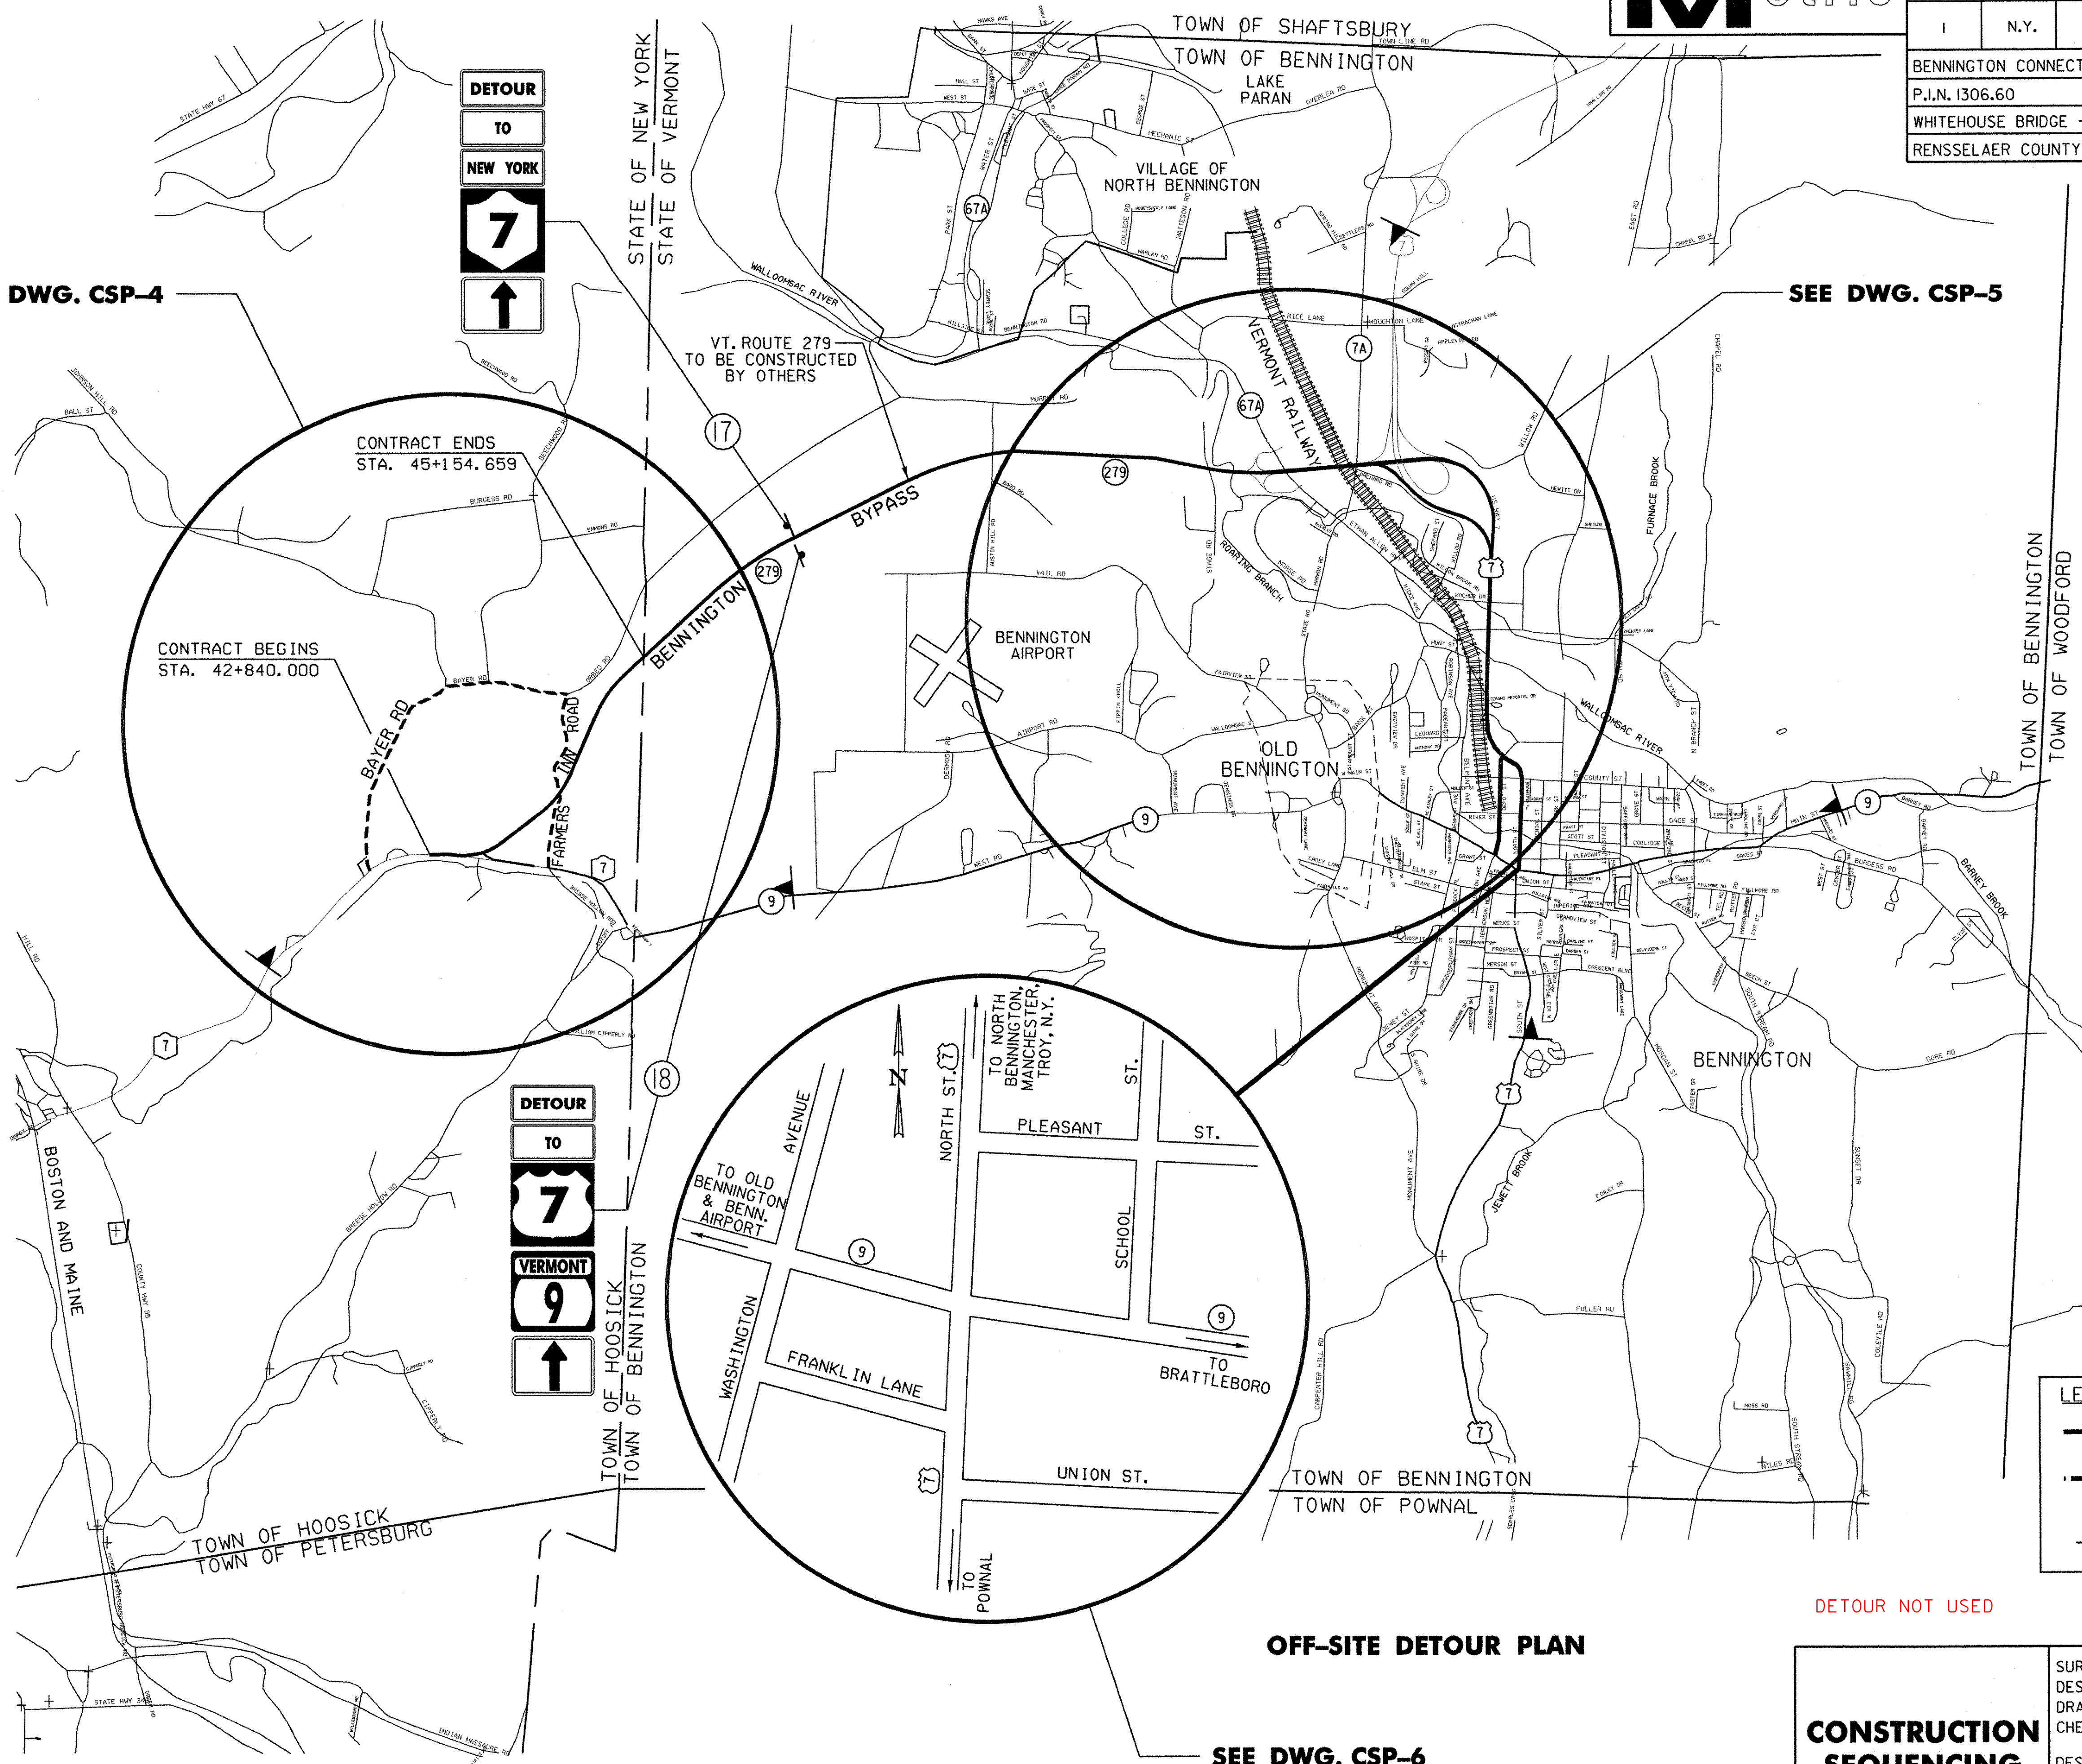

LEGEND


- DETOUR ROUTE
- PEDESTRIAN & BICYCLE DETOUR ROUTE
- VARIABLE MESSAGE SIGN

DETOUR NOT USED

ALL DIMENSIONS IN MILLIMETERS UNLESS SHOWN OTHERWISE

OFF-SITE DETOUR PLAN

SEE DWG. CSP-6

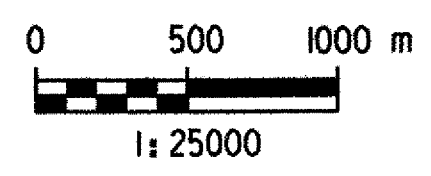

CONSTRUCTION SEQUENCING PLANS

SURVEYED BY	C.H.A. & V.S.E.	DATE	12/93
DESIGNED BY	D.W.E.	DATE	2/04
DRAWN BY	C.A.K.	DATE	2/04
CHECKED BY	T.P.K.	DATE	2/04
DESIGN FILE NO.	5116MPT.DGN		
PROJ. NAME	BENNINGTON - HOOSICK D.P.I. 0146(I) C/1		
PROJ. NO.	P.I.N. 1306.60		
SHEET	27 OF 92	DWG NO.	CSP-3

DATUM

VERTICAL	NAVD 88
HORIZONTAL	NAD 83 (1992)