


FED. ROAD REG. NO.	STATE	FEDERAL AID PROJECT NO.	SHEET NO.	TOTAL SHEETS
1	N.Y.	0146001	28	92
BENNINGTON CONNECTOR S.H. 98-2				
P.I.N. 1306.60				
WHITEHOUSE BRIDGE - VERMONT STATE LINE S.H. 1426				
RENSSELAER COUNTY				

FILE NAME = S:\1515\1515\contract\1515\1515.mxd
 DATE/TIME = 2/23/2004 10:22:55
 USER = 2225
 IN CHARGE OF T. KARIS
 DESIGNED BY D. EMERICH
 CHECKED BY D. EMERICH
 DRAFTED BY D. GOZALKOWSKI
 CHECKED BY D. GOZALKOWSKI
 DRAFTED BY C. KAHLBAUGH
 CHECKED BY I. BURTMICK
 DATE 2/04

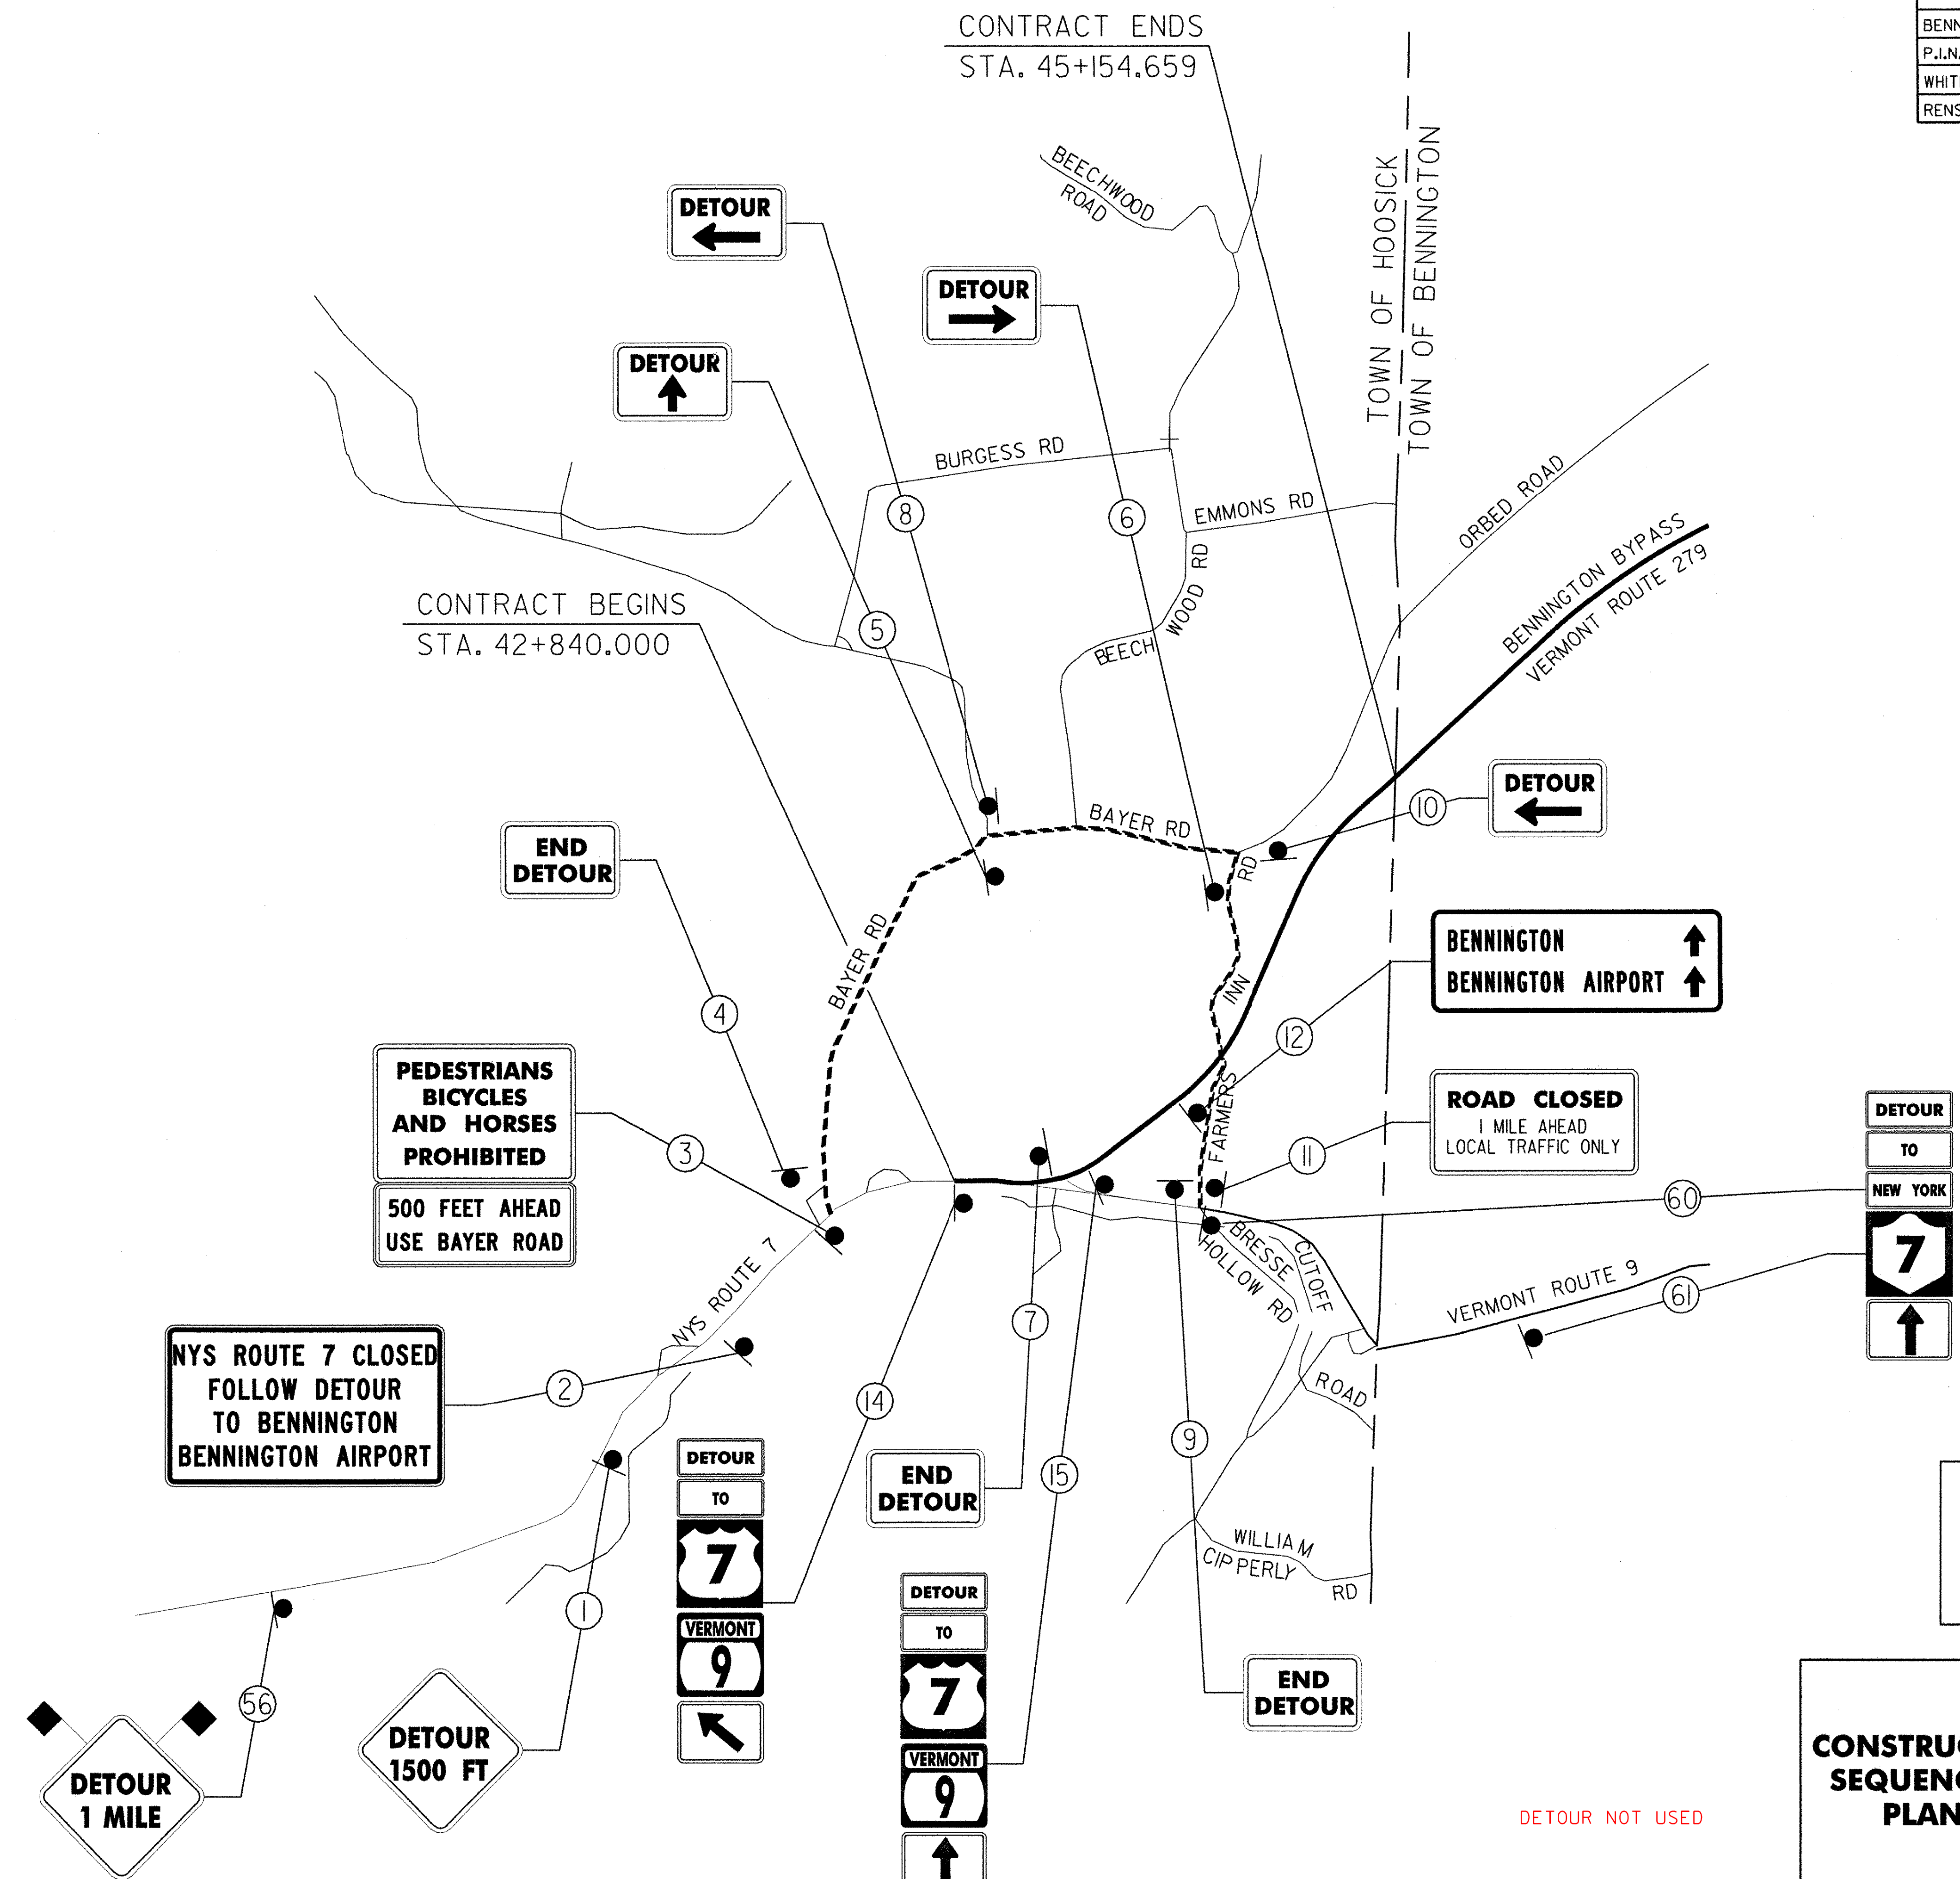

LEGEND

	DETOUR ROUTE
	PEDESTRIAN, BICYCLE & HORSES DETOUR ROUTE

CONSTRUCTION SEQUENCING PLANS

SURVEYED BY	C.H.A. & V.S.E.	DATE	12/93
DESIGNED BY	D.W.E.	DATE	2/04
DRAWN BY	C.A.K.	DATE	2/04
CHECKED BY	T.P.K.	DATE	2/04
DESIGN FILE NO.	5116MPT.DGN		
PROJ. NAME	BENNINGTON - HOOSICK D.P.I. 0146(1) C/1		
PROJ. NO.	P.I.N. 1306.60		
SHEET 28 OF 92	DWG NO. CSP-4		

DATUM

VERTICAL	NAVD 88
HORIZONTAL	NAD 83 (1992)

DETOUR NOT USED