


FED. ROAD REG. NO.	STATE	FEDERAL AID PROJECT NO.	SHEET NO.	TOTAL SHEETS
1	N.Y.	0146001	30	92

BENNINGTON CONNECTOR S.H. 98-2
 P.I.N. 1306.60
 WHITEHOUSE BRIDGE - VERMONT STATE LINE S.H. 1426
 RENSSELAER COUNTY

FILE NAME: \\s11515\project\contract\1516\mpt.dgn
 DATE/TIME: 2/23/2004 11:22:25
 IN CHARGE OF: T. KARIS
 DESIGNED BY: D. EMERICH
 CHECKED BY: D. EMERICH
 ESTIMATED BY: D. GOZALKOWSKI
 CHECKED BY: D. GOZALKOWSKI
 DRAFTED BY: C. KAHLBAUGH
 CHECKED BY: I. BURTNICK
 DATE: 2/04

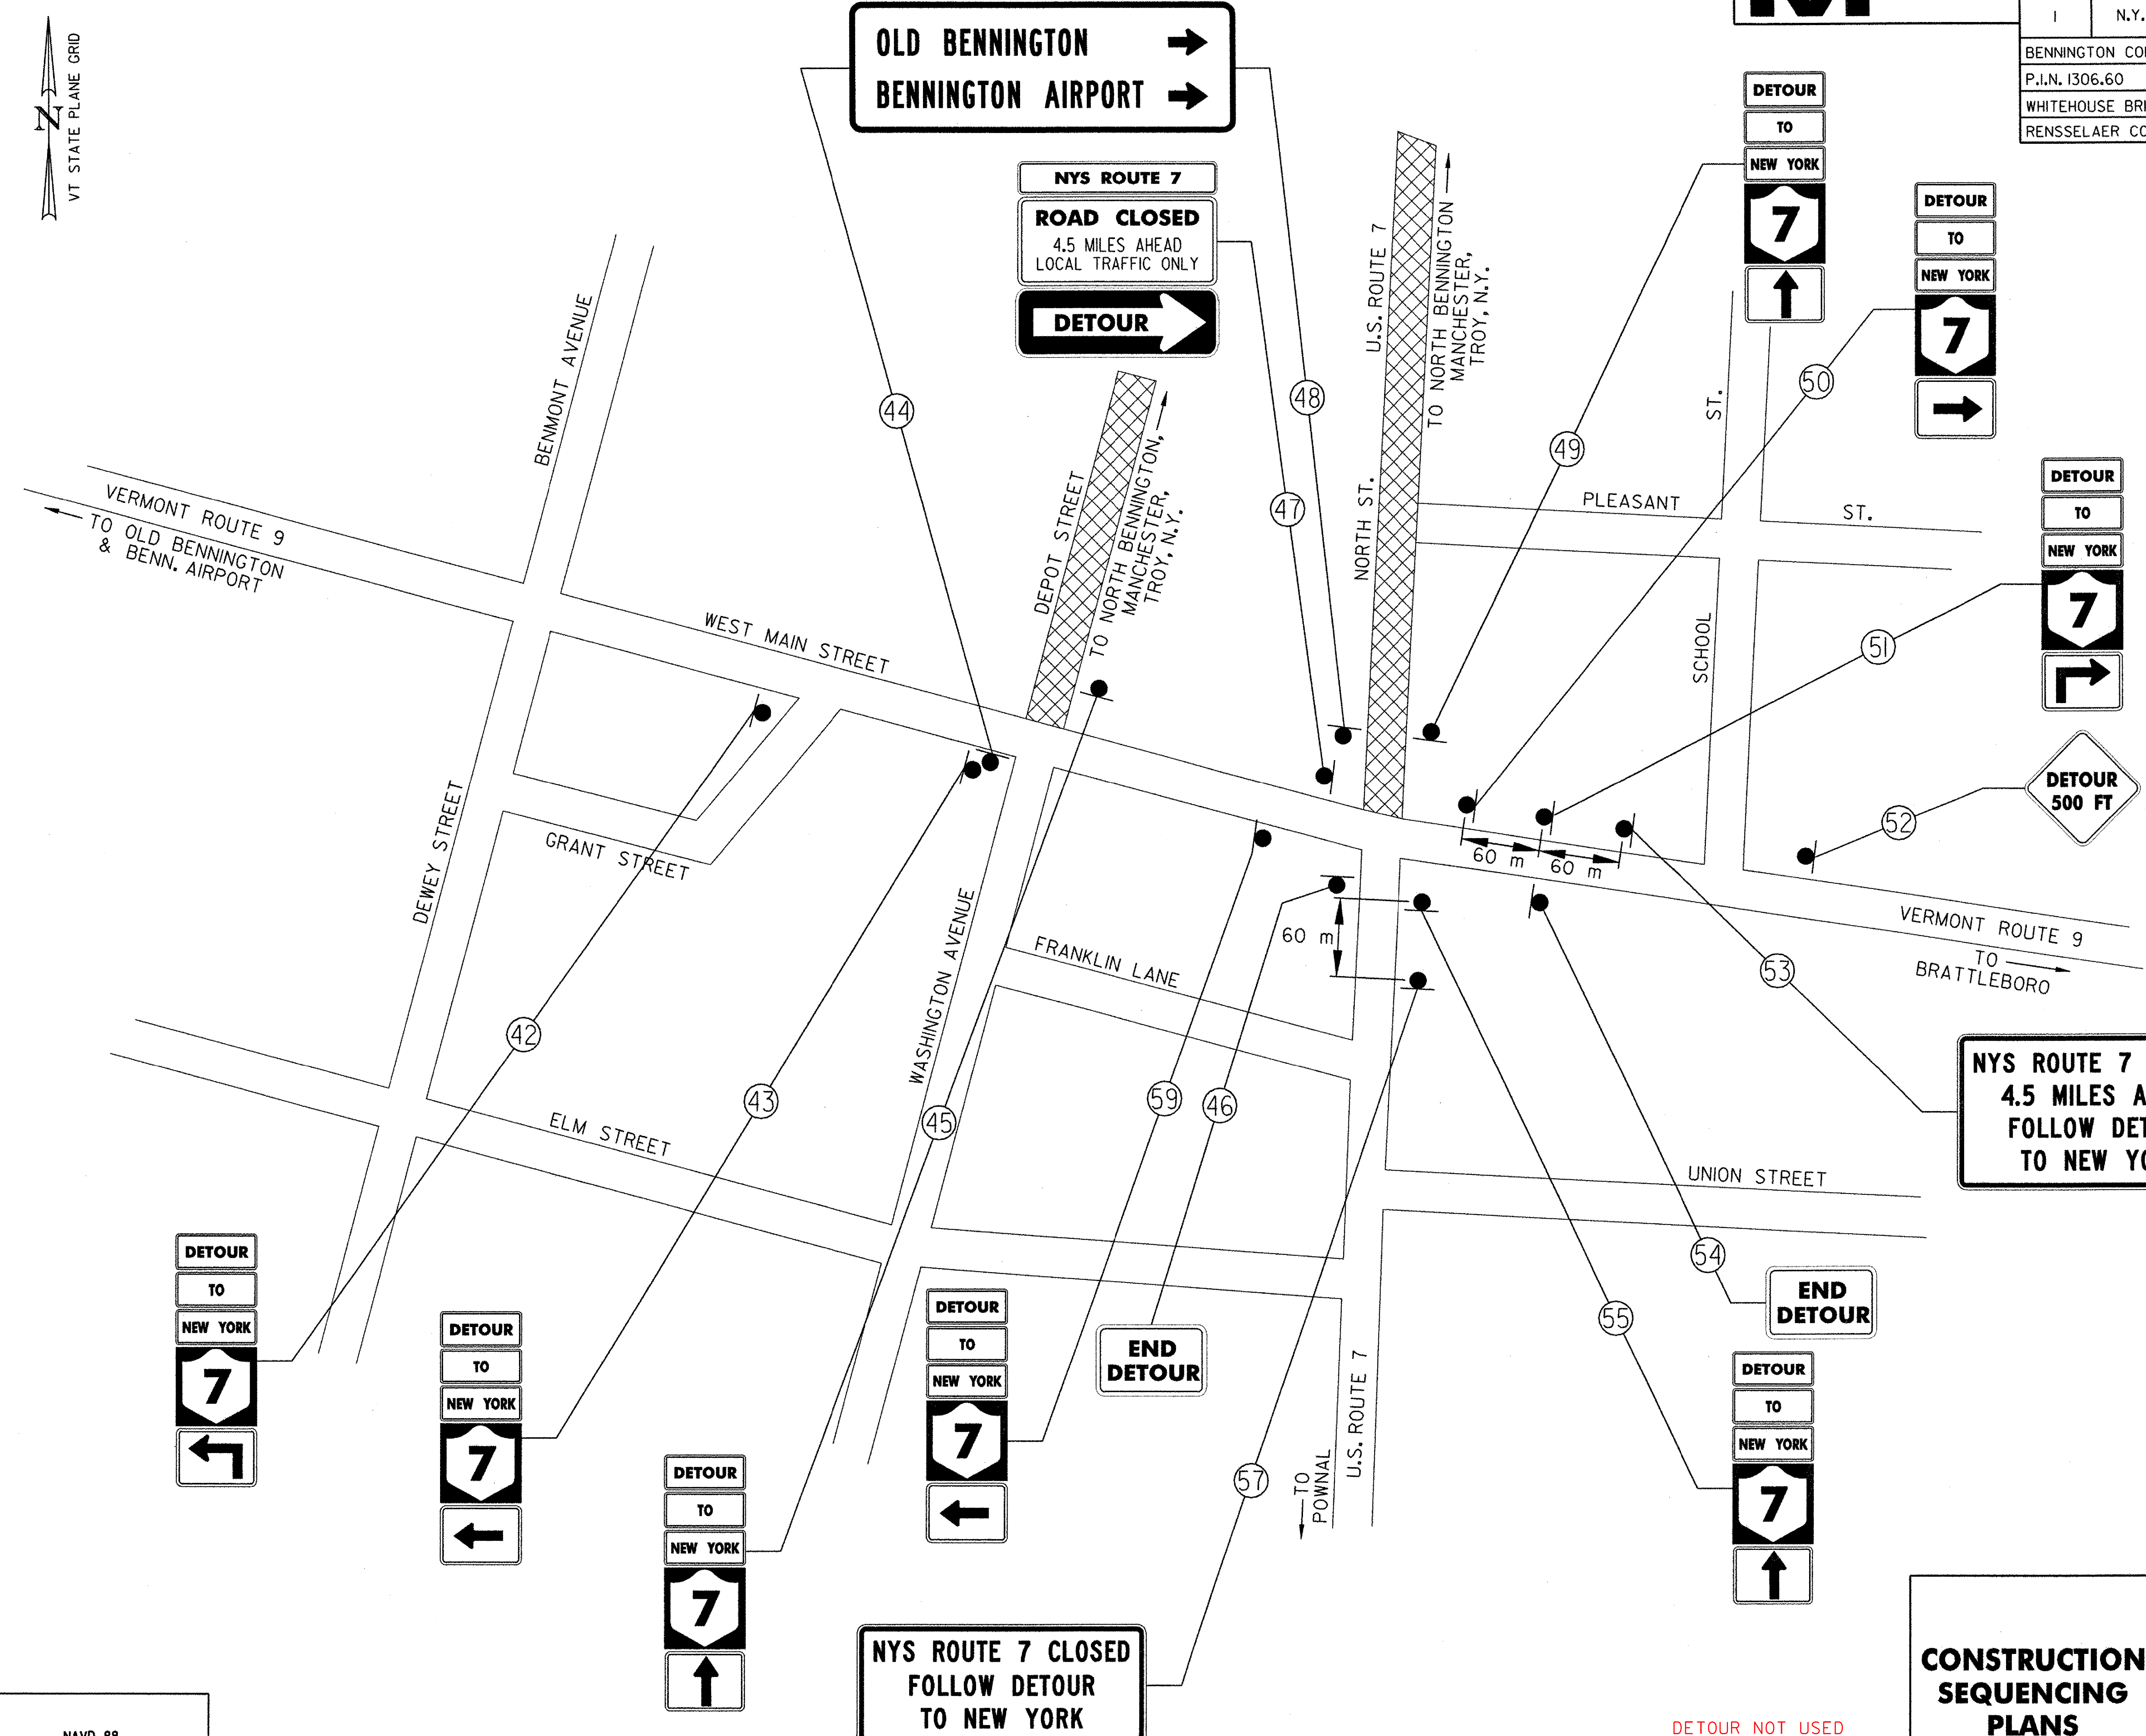

OLD BENNINGTON →
BENNINGTON AIRPORT →

NYS ROUTE 7
ROAD CLOSED
 4.5 MILES AHEAD
 LOCAL TRAFFIC ONLY
DETOUR →

DETOUR
 TO
NEW YORK
 7
 ↑

DETOUR
 TO
NEW YORK
 7
 →

DETOUR
 TO
NEW YORK
 7
 ↘

DETOUR
 500 FT

NYS ROUTE 7 CLOSED
 4.5 MILES AHEAD
 FOLLOW DETOUR
 TO NEW YORK

NYS ROUTE 7 CLOSED
 FOLLOW DETOUR
 TO NEW YORK

END
DETOUR

END
DETOUR

DETOUR
 TO
NEW YORK
 7
 ↙

DETOUR
 TO
NEW YORK
 7
 ↑

DETOUR
 TO
NEW YORK
 7
 ↑

DETOUR
 TO
NEW YORK
 7
 ←

DETOUR
 TO
NEW YORK
 7
 ↑

LEGEND
 DETOUR ROUTE

DETOUR NOT USED

DATUM

VERTICAL	NAVD 88
HORIZONTAL	NAD 83 (1992)

CONSTRUCTION SEQUENCING PLANS

SURVEYED BY	C.H.A. & V.S.E.	DATE	12/93
DESIGNED BY	D.W.E.	DATE	2/04
DRAWN BY	C.A.K.	DATE	2/04
CHECKED BY	T.P.K.	DATE	2/04
DESIGN FILE NO.	516MPT.DGN		
PROJ. NAME	BENNINGTON - HOOSICK D.P.I. 0146(1) C/1		
PROJ. NO.	P.I.N. 1306.60		
SHEET	30 OF 92	DWG NO.	CSP-6