


42+860

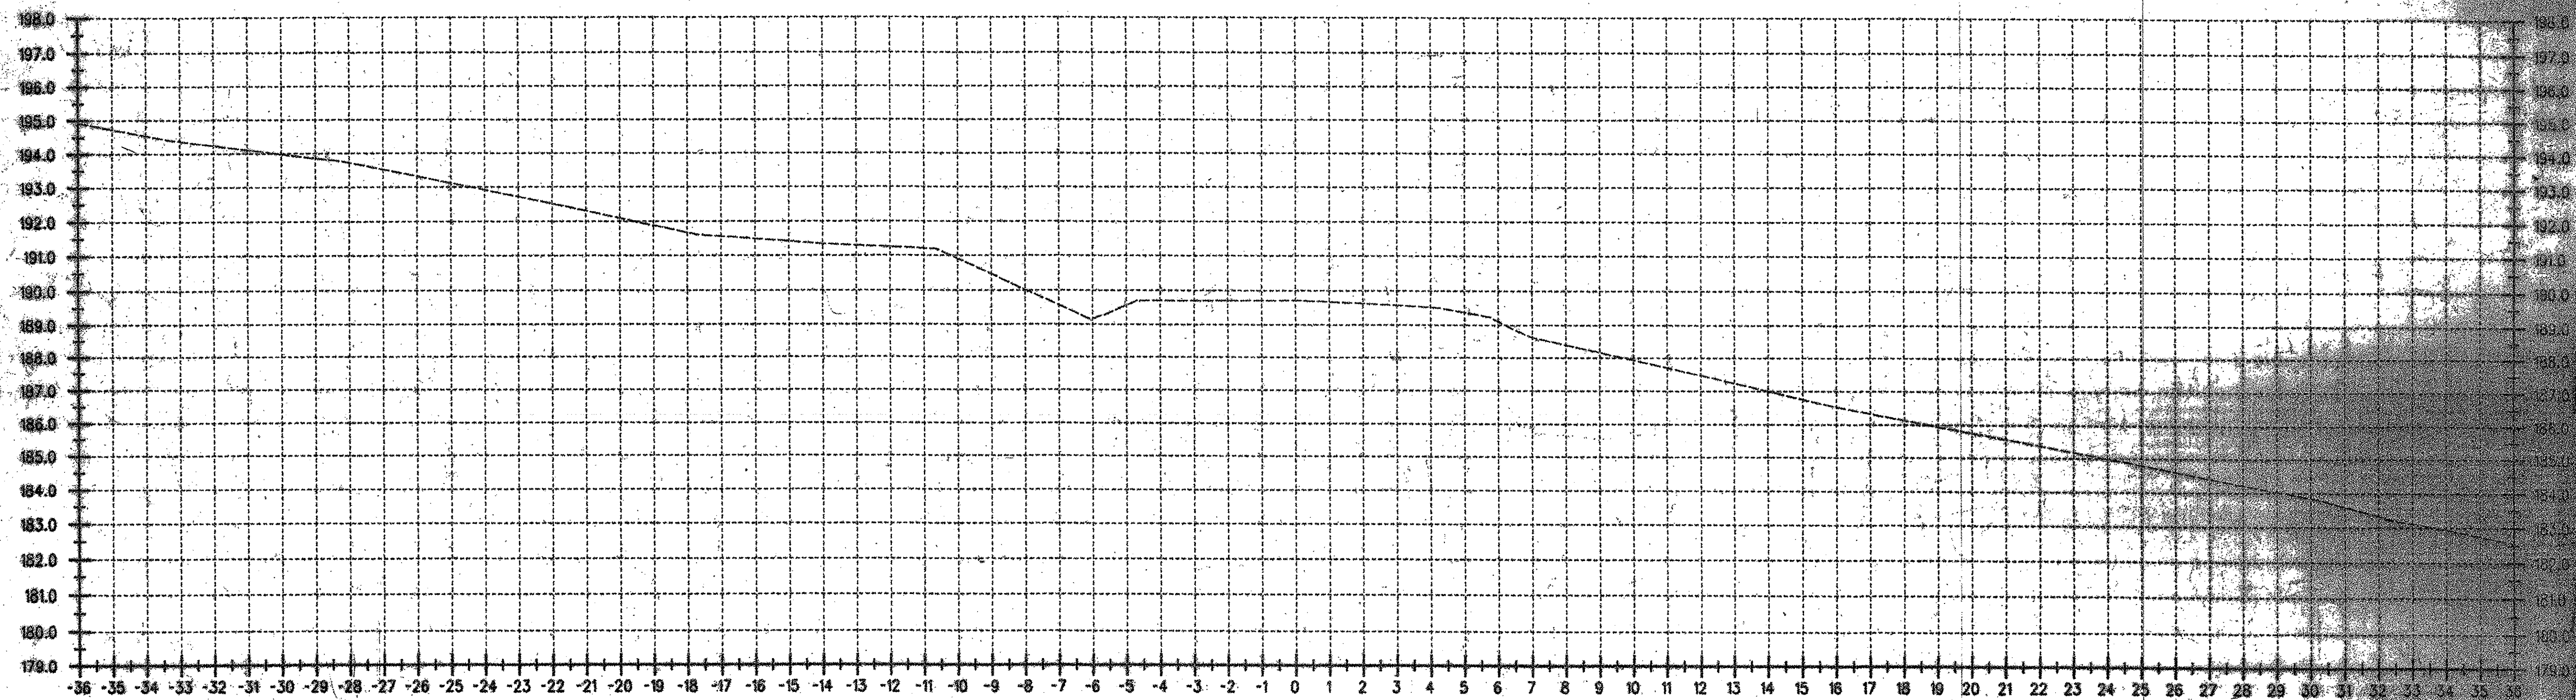

42+840

DATUM
 VERTICAL NAD 83
 HORIZONTAL NAD 83

ALL DIMENSIONS IN MILLIMETERS
 EXCEPT AS INDICATED

2 0 2 m
 H 1:100
 V 1:100

SURVEYED BY C.H.A. & V.S.E. DATE _____
 DRAWN BY J.S.L. DATE _____
 SQUAD LEADER T.P.K.
 DESIGN FILE NO. N/A
 PARM _____ DATE PLOTTED _____
 FILE _____
 PROJ. NAME BENNINGTON - HOOSICK
 D.P.I. 0145(1)
 PROJ. NO. P.I.N. 1506.P0.201
 SHEET 72 OF 122 SHEETS