



4.34m  
3.57  
42+980

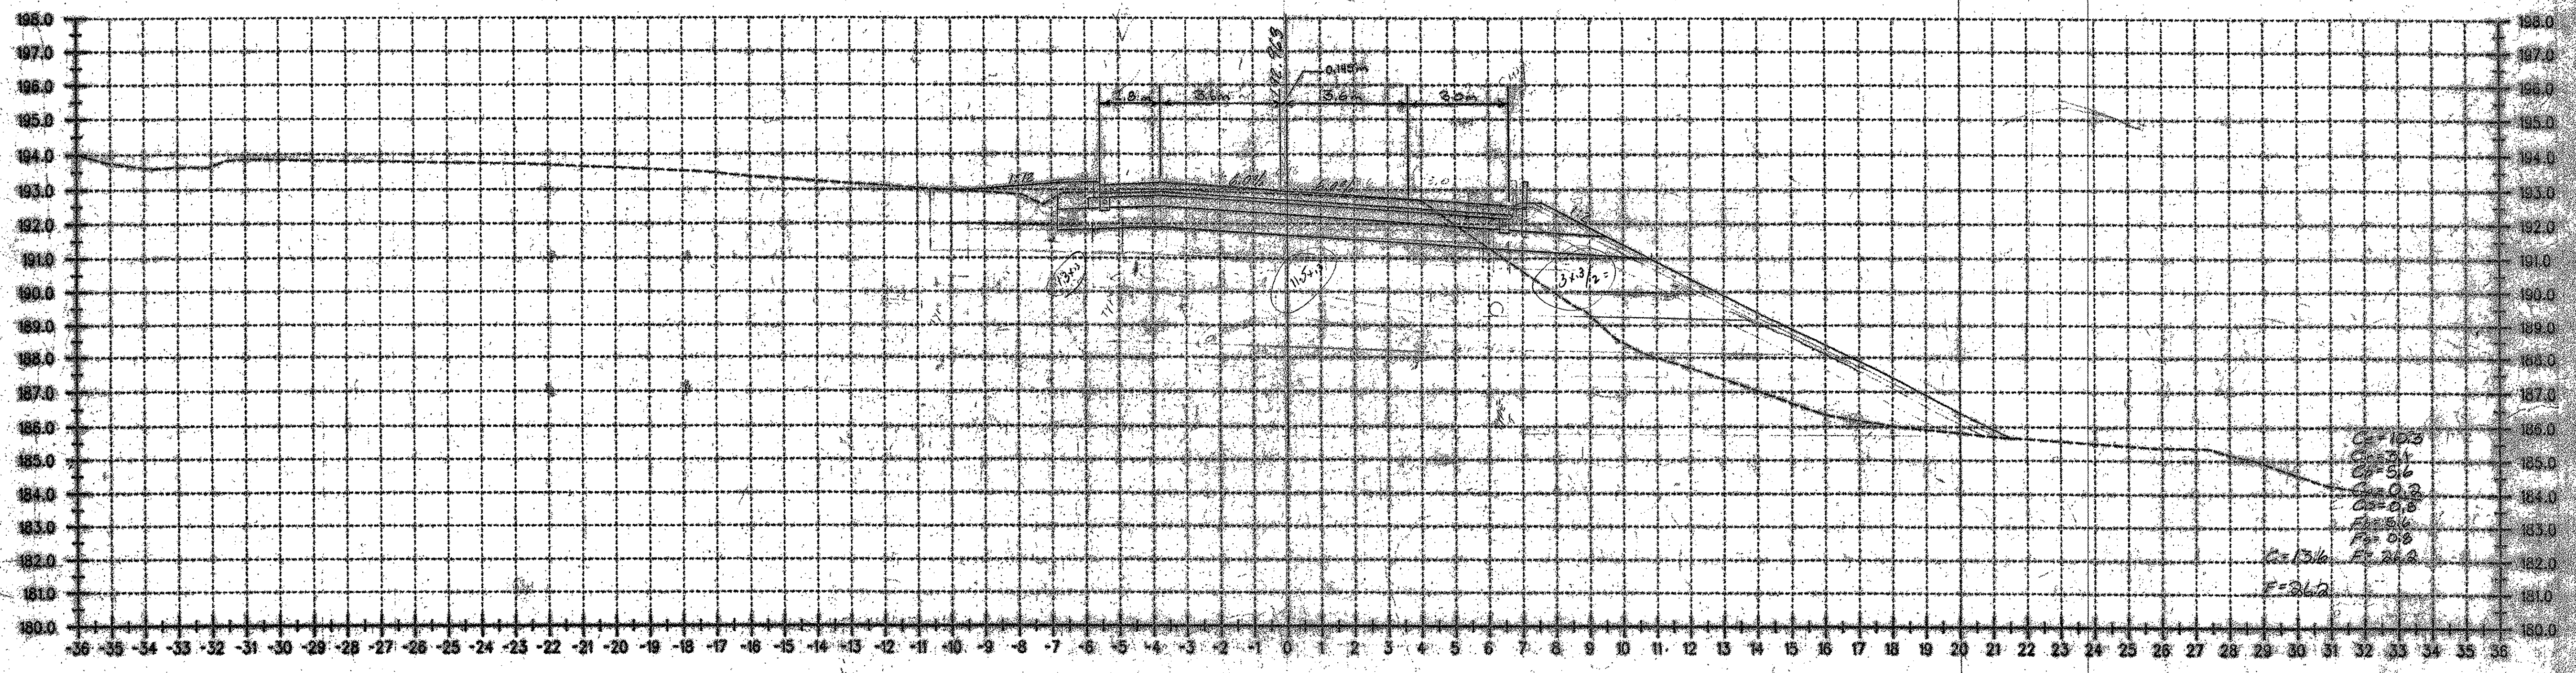

4.29m  
3.45  
42+960

DATUM  
VERTICAL: NAVD 88  
HORIZONTAL: NAD 83 (1983)

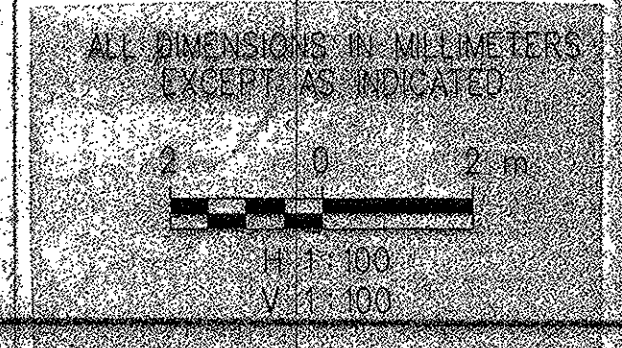

SURVEYED BY: C.H.A. & V.S.E. DATE: 10/13  
DRAWN BY: J.S.L. DATE: 11/02  
SQUAD LEADER: T.P.K.  
DESIGN FILE NO.: N/A  
FARM FILE: \_\_\_\_\_ DATE PLOTTED: \_\_\_\_\_  
PROJ. NAME: BENNINGTON + HOOSICK  
D.P.I. 0146(C)  
PROJ. NO. P.I.N. 1306.60.201  
SHEET 73 OF 98 SHEETS