



Handwritten notes:
 11/15/85
 P. 12/15/85
 11/15/85

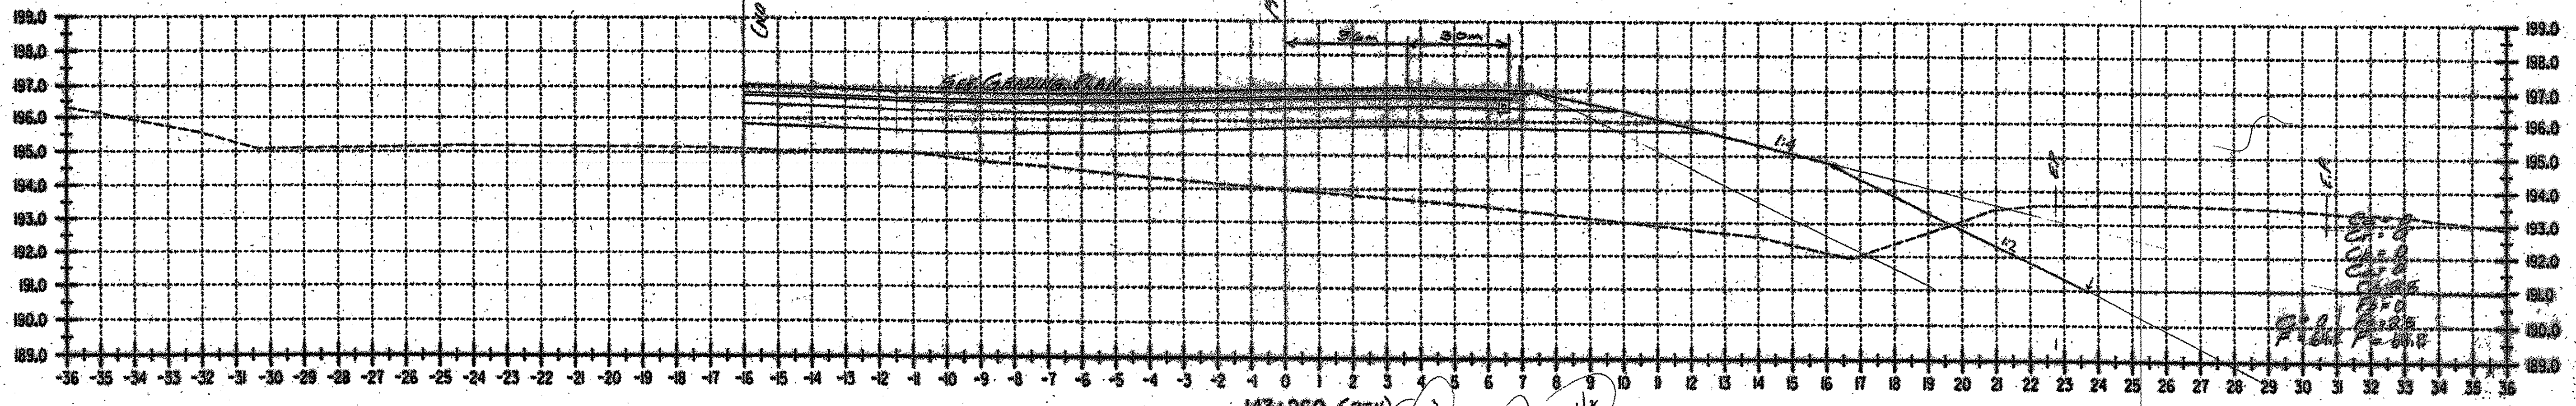

143+260 (CPH)
 20x1.5
 4.66
 7.65m
 3.3x1/2

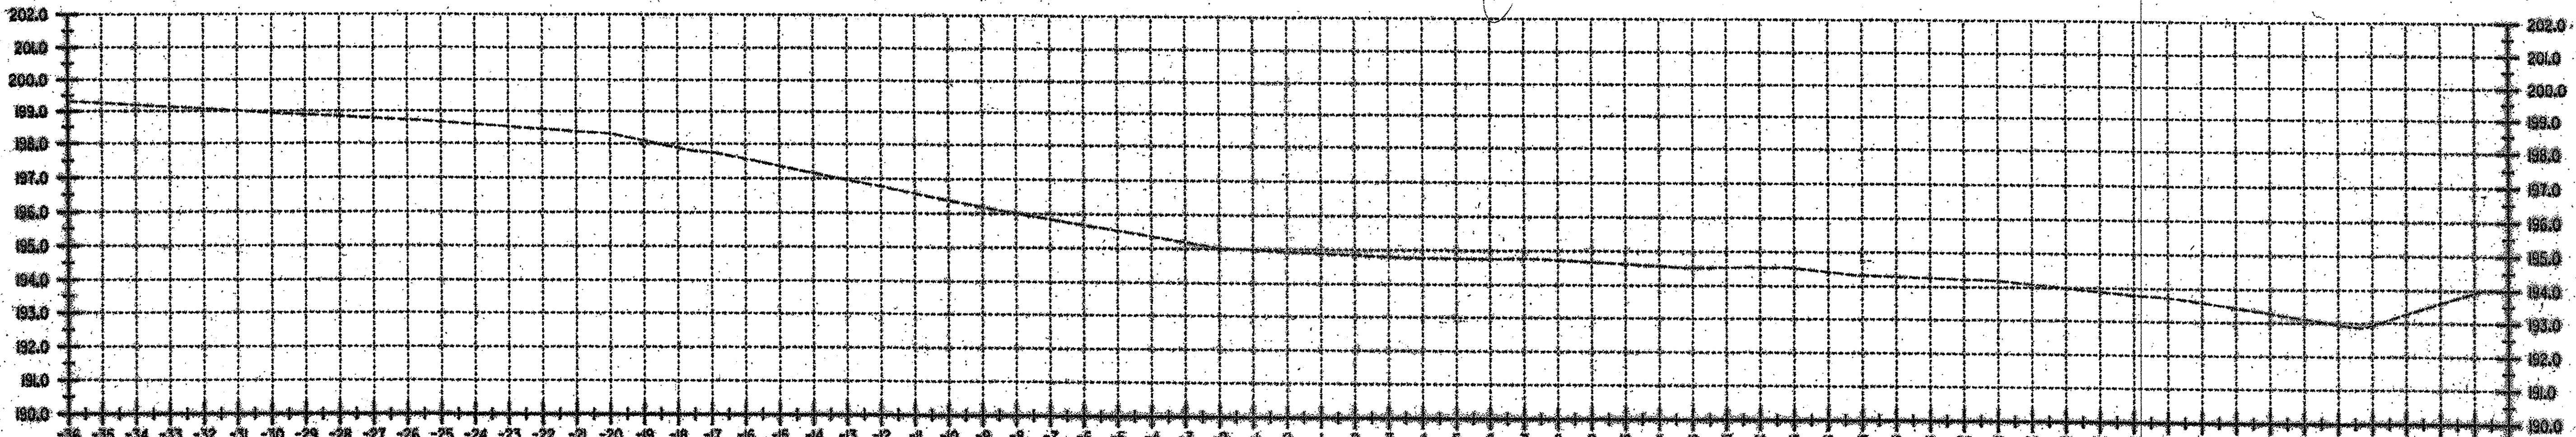

143+240

DATUM
 VERTICAL NAVD 88
 HORIZONTAL NAD 83 (1982)

ALL DIMENSIONS IN MILLIMETERS
 EXCEPT AS INDICATED
 2 0 2 m
 H 1:100
 V 1:100

SURVEYED BY CHAS. V. SE. DATE 11/85
 DRAWN BY J.S.L. DATE 11/85
 SQUAD LEADER T.P.K.
 DESIGN FILE NO. N/A
 PARM FILE _____ DATE PLOTTED _____
 PROJ. NAME BENNINGTON F. HOOSICK
D.P. 01460
 PROJ. NO. P.A.N. 1306.6010
 SHEET 62 OF 92 SHEETS