


CA0+005

9x3
2" (35)
1.5 x 1/2

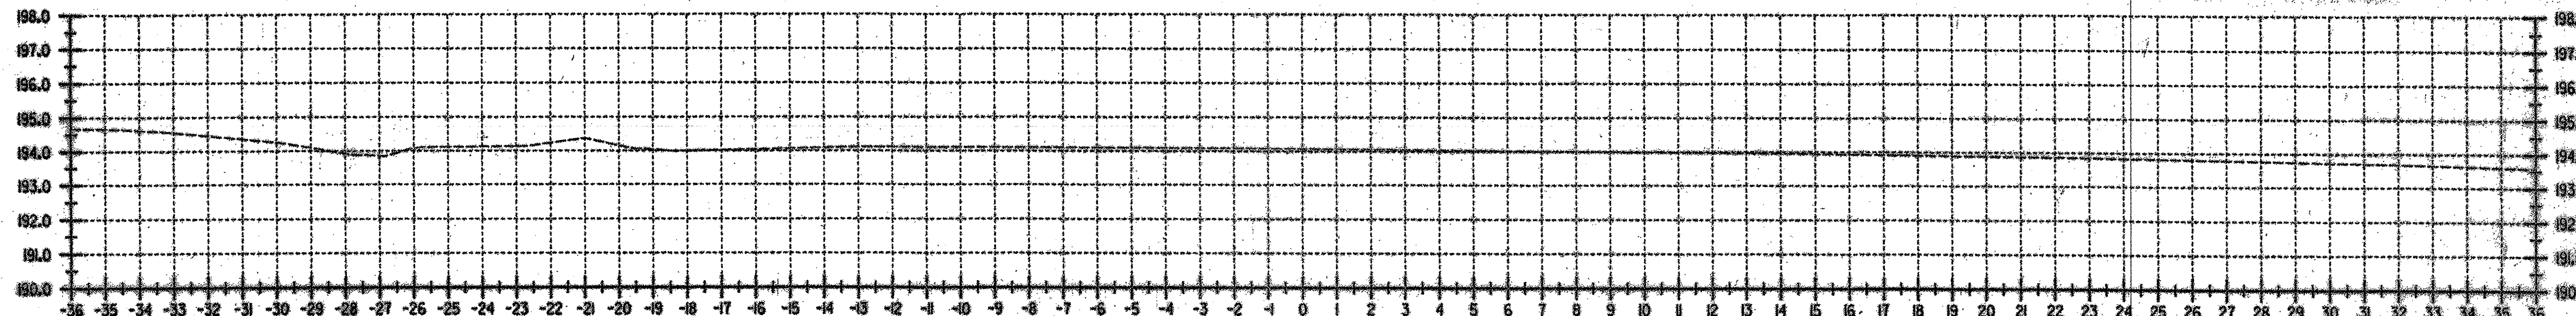

CA0+000

DATUM
 VERTICAL NAVD 88
 HORIZONTAL NAD 83 1992f

ALL DIMENSIONS IN MILLIMETERS
 EXCEPT AS INDICATED
 2 0 2 m
 H 1:100
 V 1:100

SURVEYED BY C.H.A. & V.S.E. DATE 10/14
 DRAWN BY J.S.L. DATE 11/03
 SQUAD LEADER T.P.K.
 DESIGN FILE NO. 75116/cohill.dgn
 FARM DATE
 FILE PLOTTED
 PROJ. NAME BENNINGTON + HOOSICK
 D.P.I. 01460
 PROJ. NO. P.I.N. 1306.00.01
 SHEET 88 OF 92 SHEETS