


CA0+035

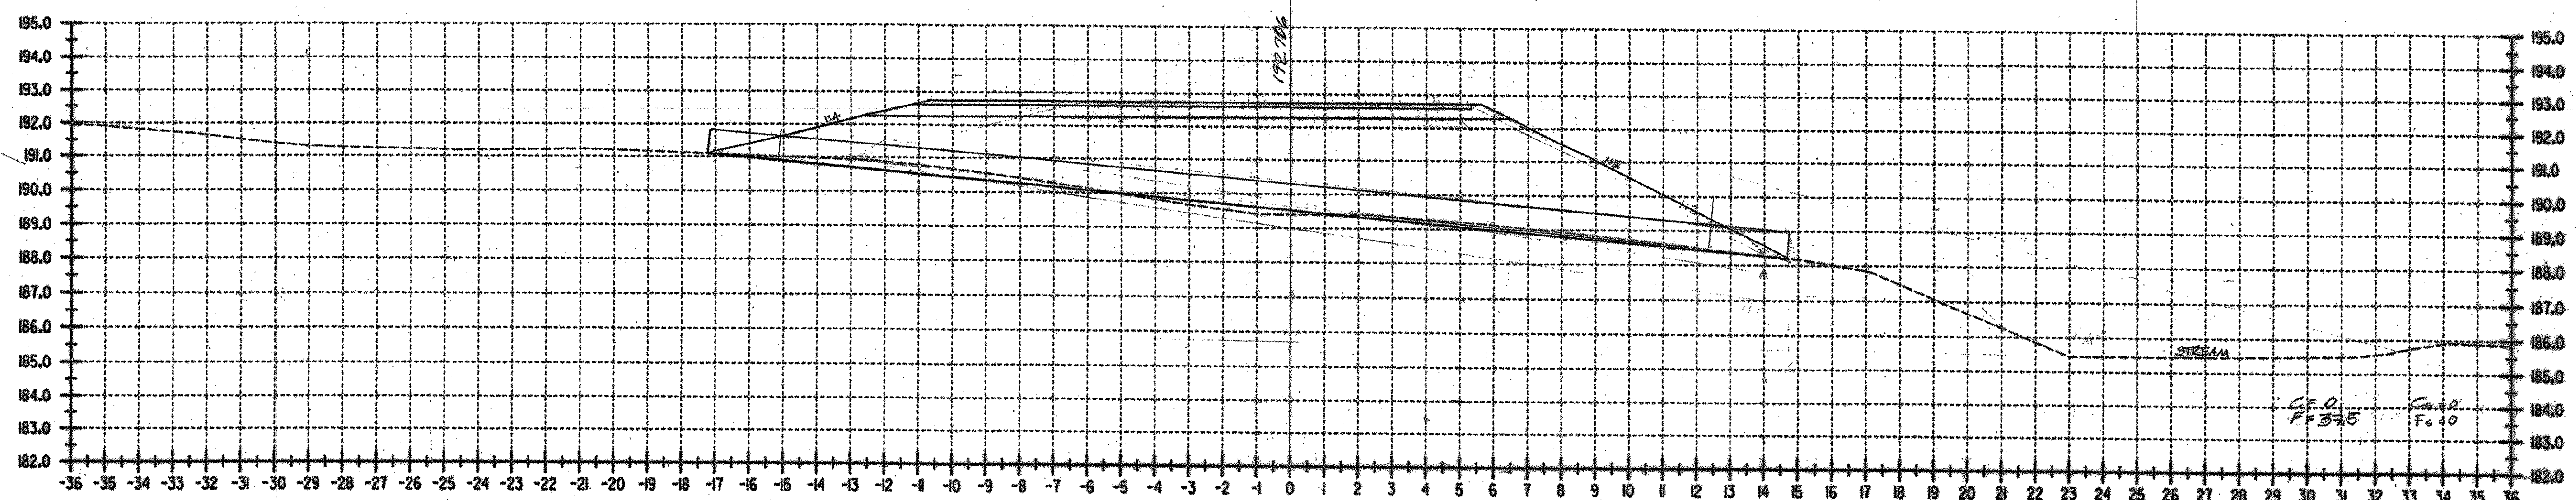

CA0+030

DATUM	
VERTICAL	NAVD 88
HORIZONTAL	NAD 83 (9902)

ALL DIMENSIONS IN MILLIMETERS
EXCEPT AS INDICATED

2 0 2 m

H 1:100
V 1:100

SURVEYED BY	C.H.A. & V.S.E.	DATE	12/23
DRAWN BY	J.S.L.	DATE	11/02
SQUAD LEADER	T.P.K.		
DESIGN FILE NO.	/516/eahill.dgn		
IPARM FILE		DATE PLOTTED	
PROJ. NAME	BENNINGTON - HOOSICK D.P.I. 04610		
PROJ. NO.	P.N. 1306.60J01		
SHEET	91 OF 92 SHEETS		