


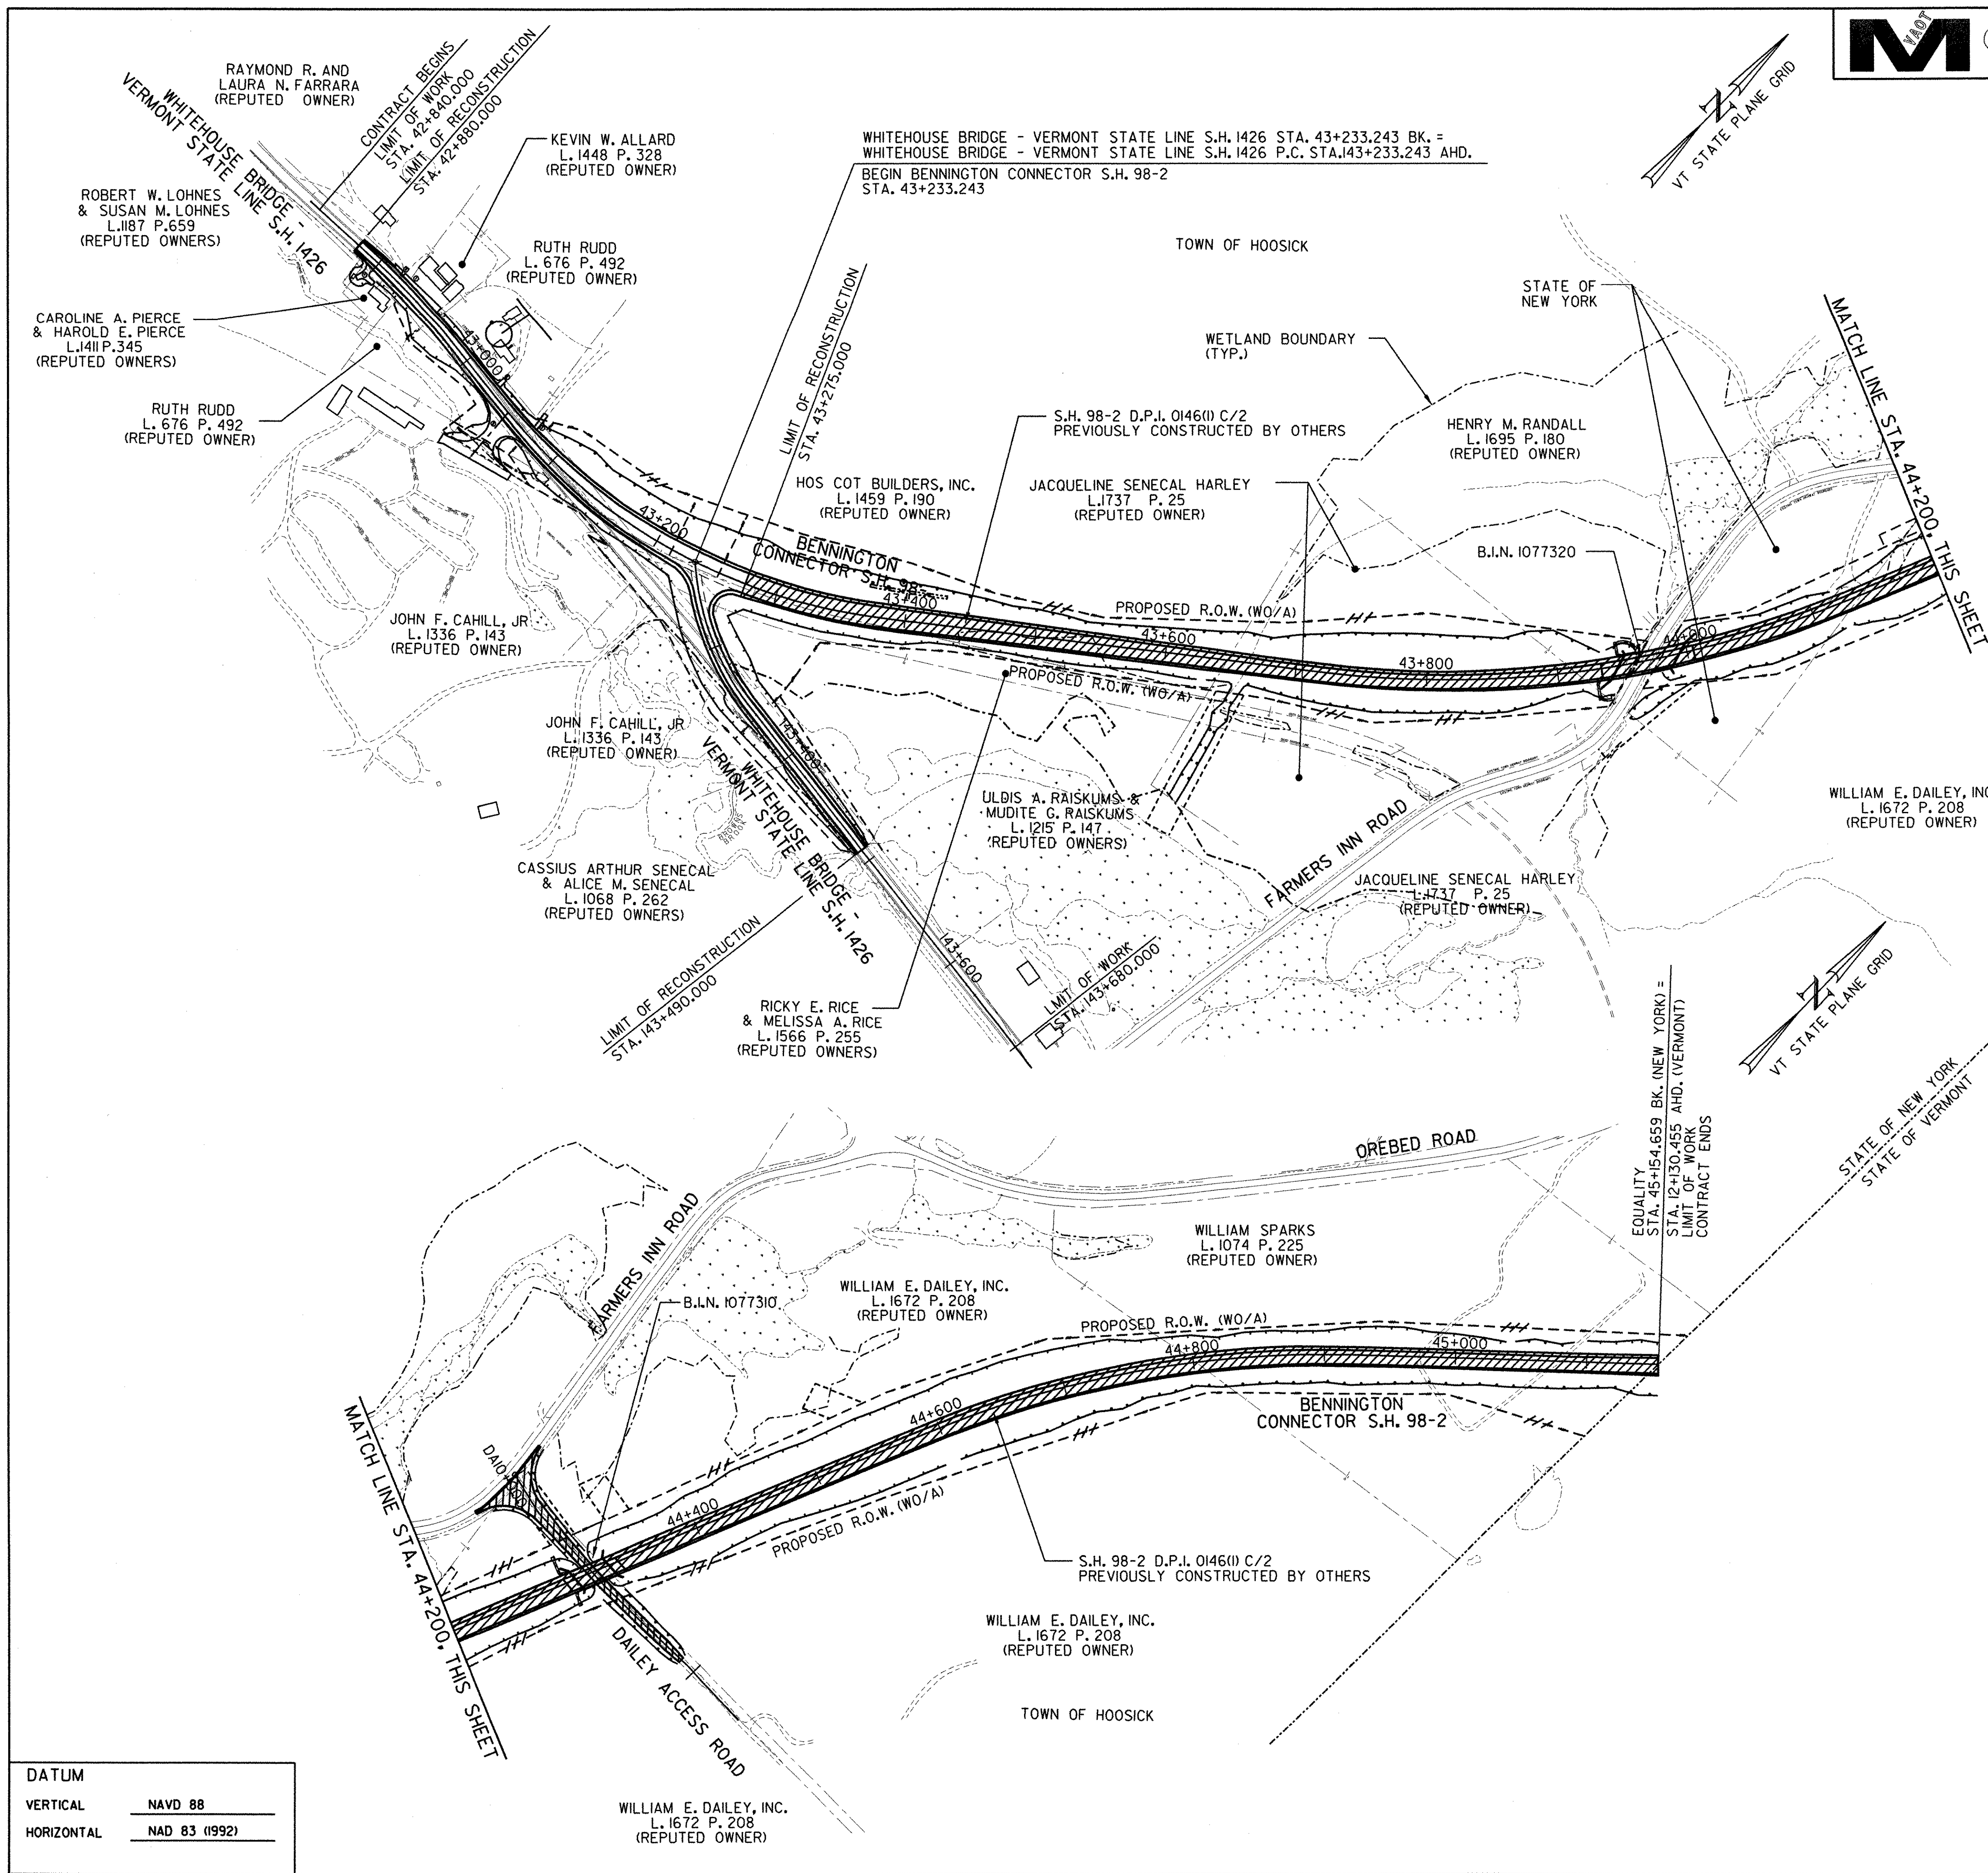

FED. ROAD REG. NO.	STATE	FEDERAL AID PROJECT NO.	SHEET NO.	TOTAL SHEETS
I	N.Y.	0146001	15	92
BENNINGTON CONNECTOR S.H. 98-2				
P.I.N. 1306.60				
WHITEHOUSE BRIDGE - VERMONT STATE LINE S.H. 1426				
RENSSELAER COUNTY				

SURVEYED BY	<u>C.H.A. & V.S.E.</u>	DATE	<u>12/93</u>
DESIGNED BY	<u>D.W.E.</u>	DATE	<u>2/04</u>
DRAWN BY	<u>C.A.K.</u>	DATE	<u>2/04</u>
CHECKED BY	<u>T.P.K.</u>	DATE	<u>2/04</u>
DESIGN FILE NO. <u>2500PLN.DGN</u>			
PROJ. NAME BENNINGTON - HOOSICK D.P.I. 014611) C/I			
PROJ. NO. P.L.N. 1306.60			
SHEET 15 OF 92 DWG NO. GPL-1			