



FED. ROAD REG. NO.	STATE	FEDERAL AID PROJECT NO.	SHEET NO.	TOTAL SHEETS
I	N.Y.	0146001	23	92
BENNINGTON CONNECTOR S.H. 98-2				
P.I.N. 1306.60				
WHITEHOUSE BRIDGE - VERMONT STATE LINE S.H. 1426				
RENSSELAER COUNTY				


FILE NAME = u:\5116\project\contract\vg\stg6.dgn
 DATE/TIME = 2/23/2004
 USER = 2225
 IN CHARGE OF T. KARIS
 DESIGNED BY D. EMERICH
 CHECKED BY D. EMERICH
 ESTIMATED BY D. EMERICH
 CHECKED BY D. GOZALKOWSKI
 DRAFTED BY D. GOZALKOWSKI
 CHECKED BY C. KAHLBAUGH
 DATE 2/04
 CHECKED BY I. BURTNICK

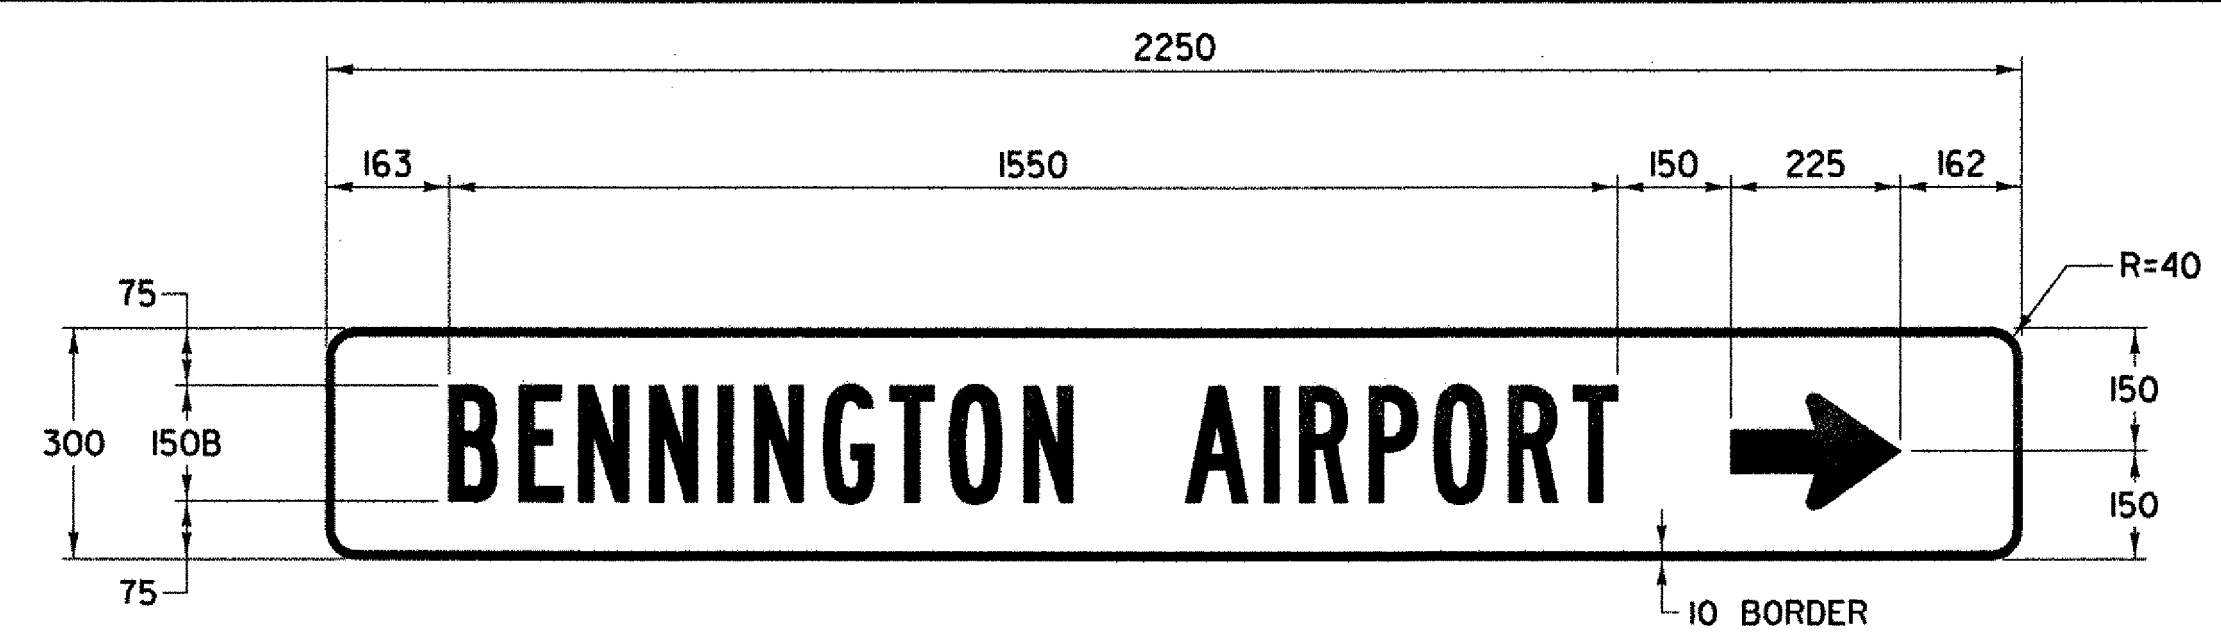


COLOR: BLACK BORDER & TEXT (REFLECTORIZED)
ORANGE BACKGROUND (REFLECTORIZED)

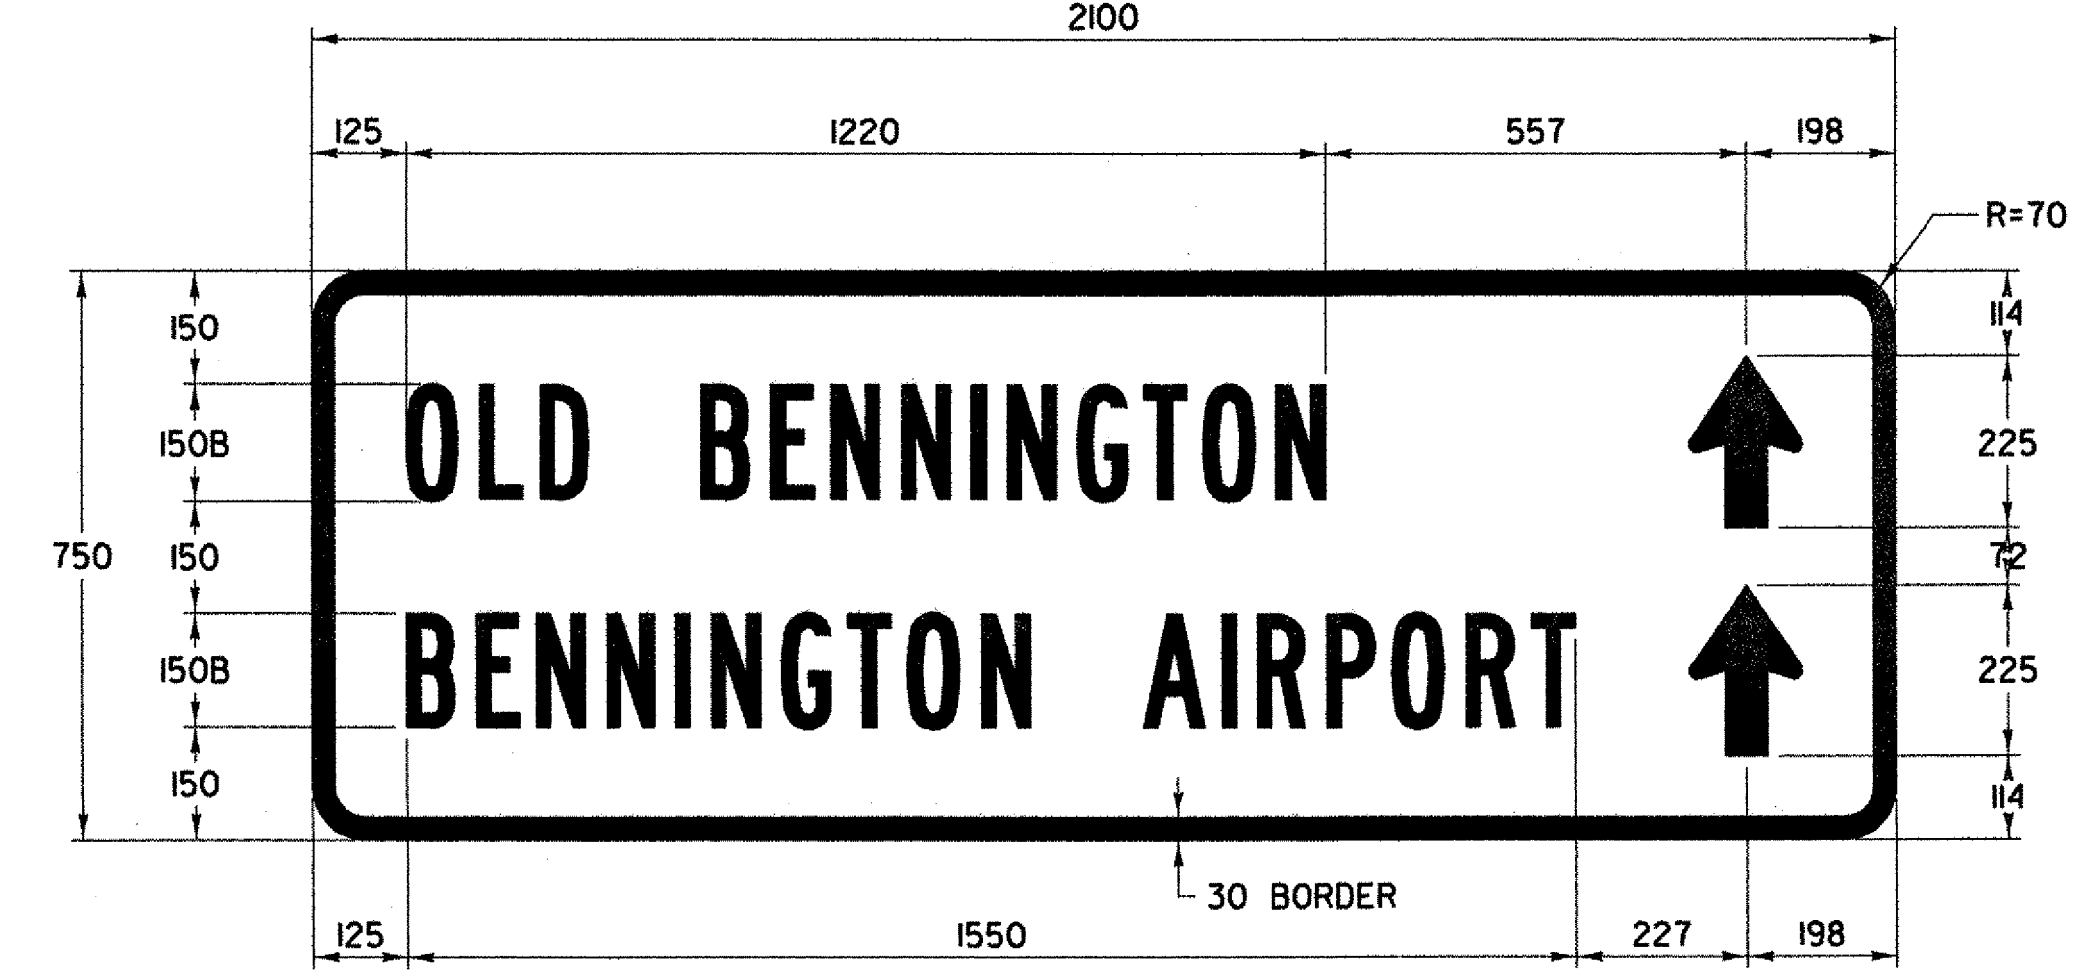

COLOR: BLACK BORDER & TEXT (REFLECTORIZED)
ORANGE BACKGROUND (REFLECTORIZED)

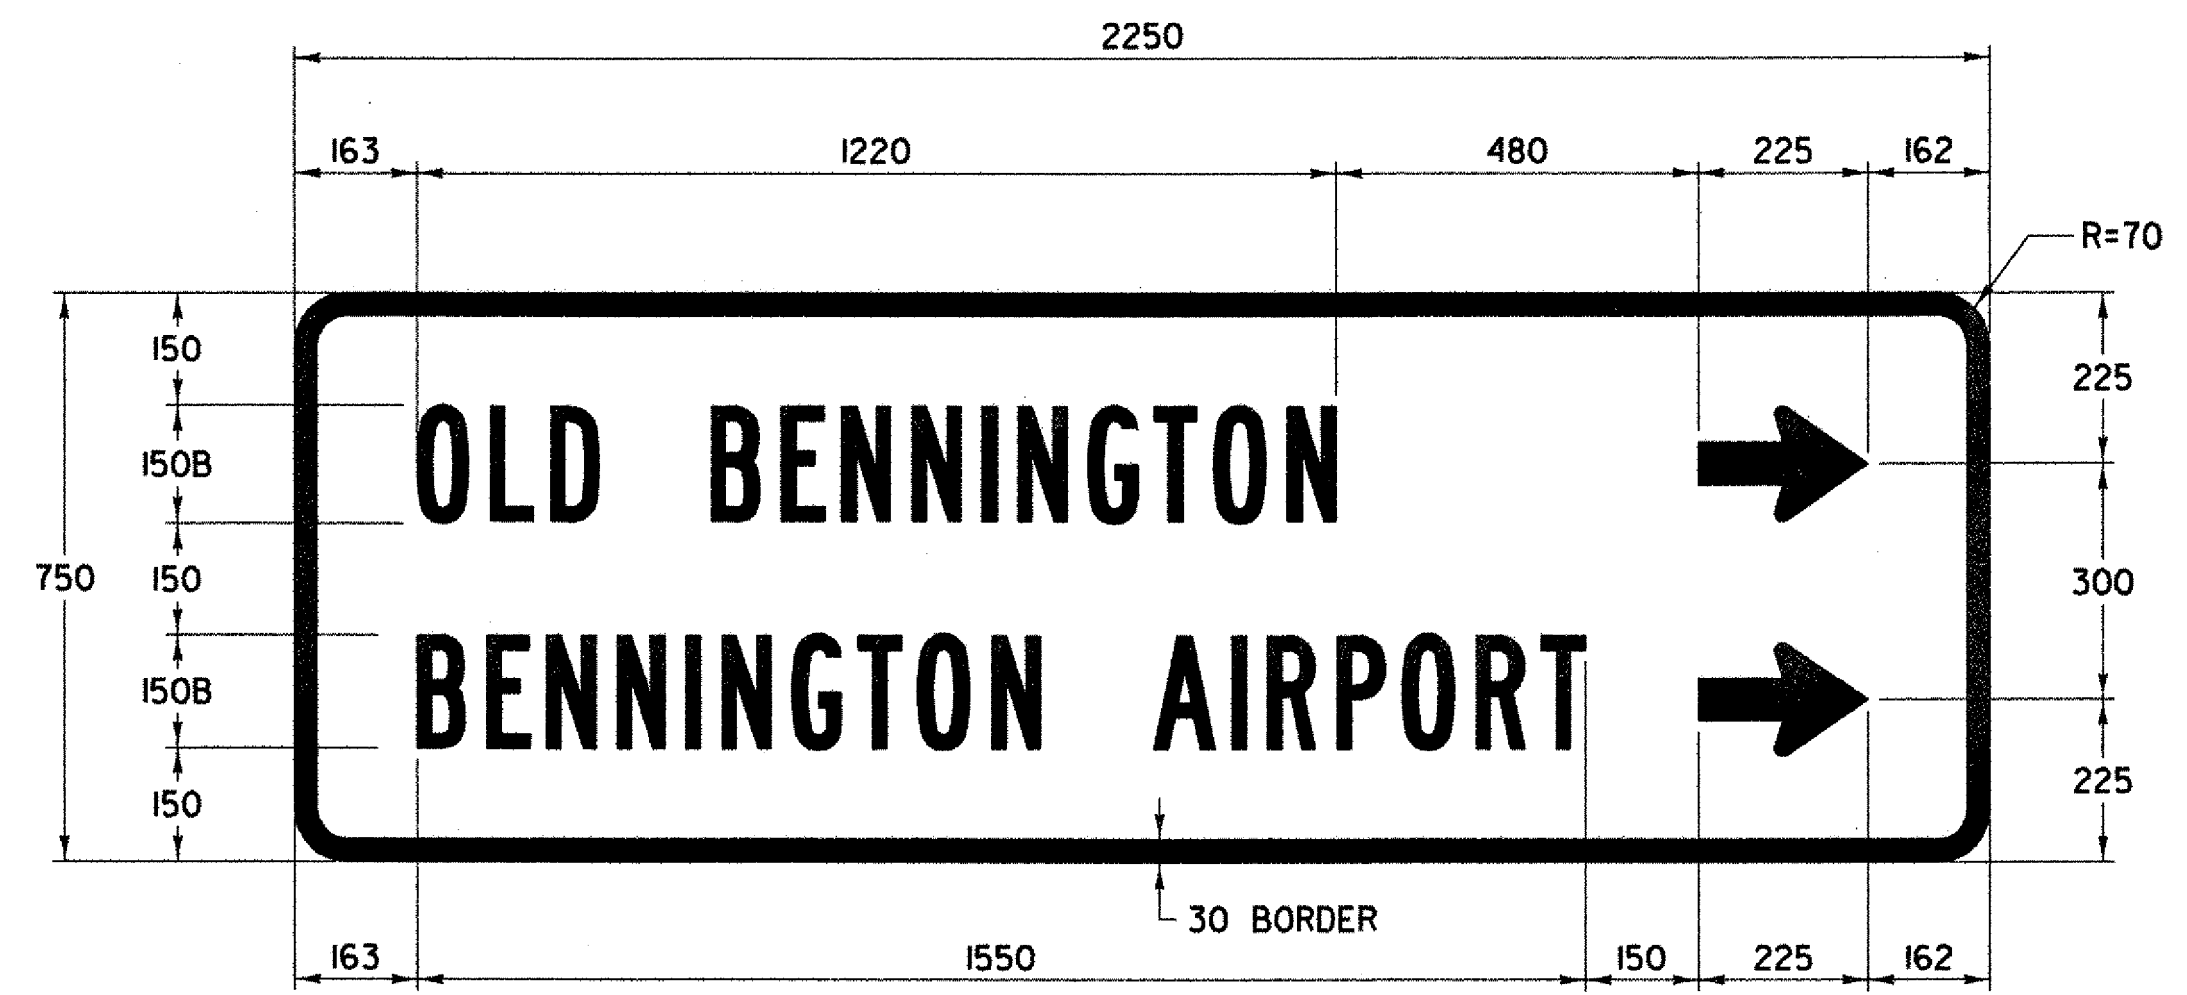


COLOR: BLACK BORDER & TEXT (REFLECTORIZED)
ORANGE BACKGROUND (REFLECTORIZED)

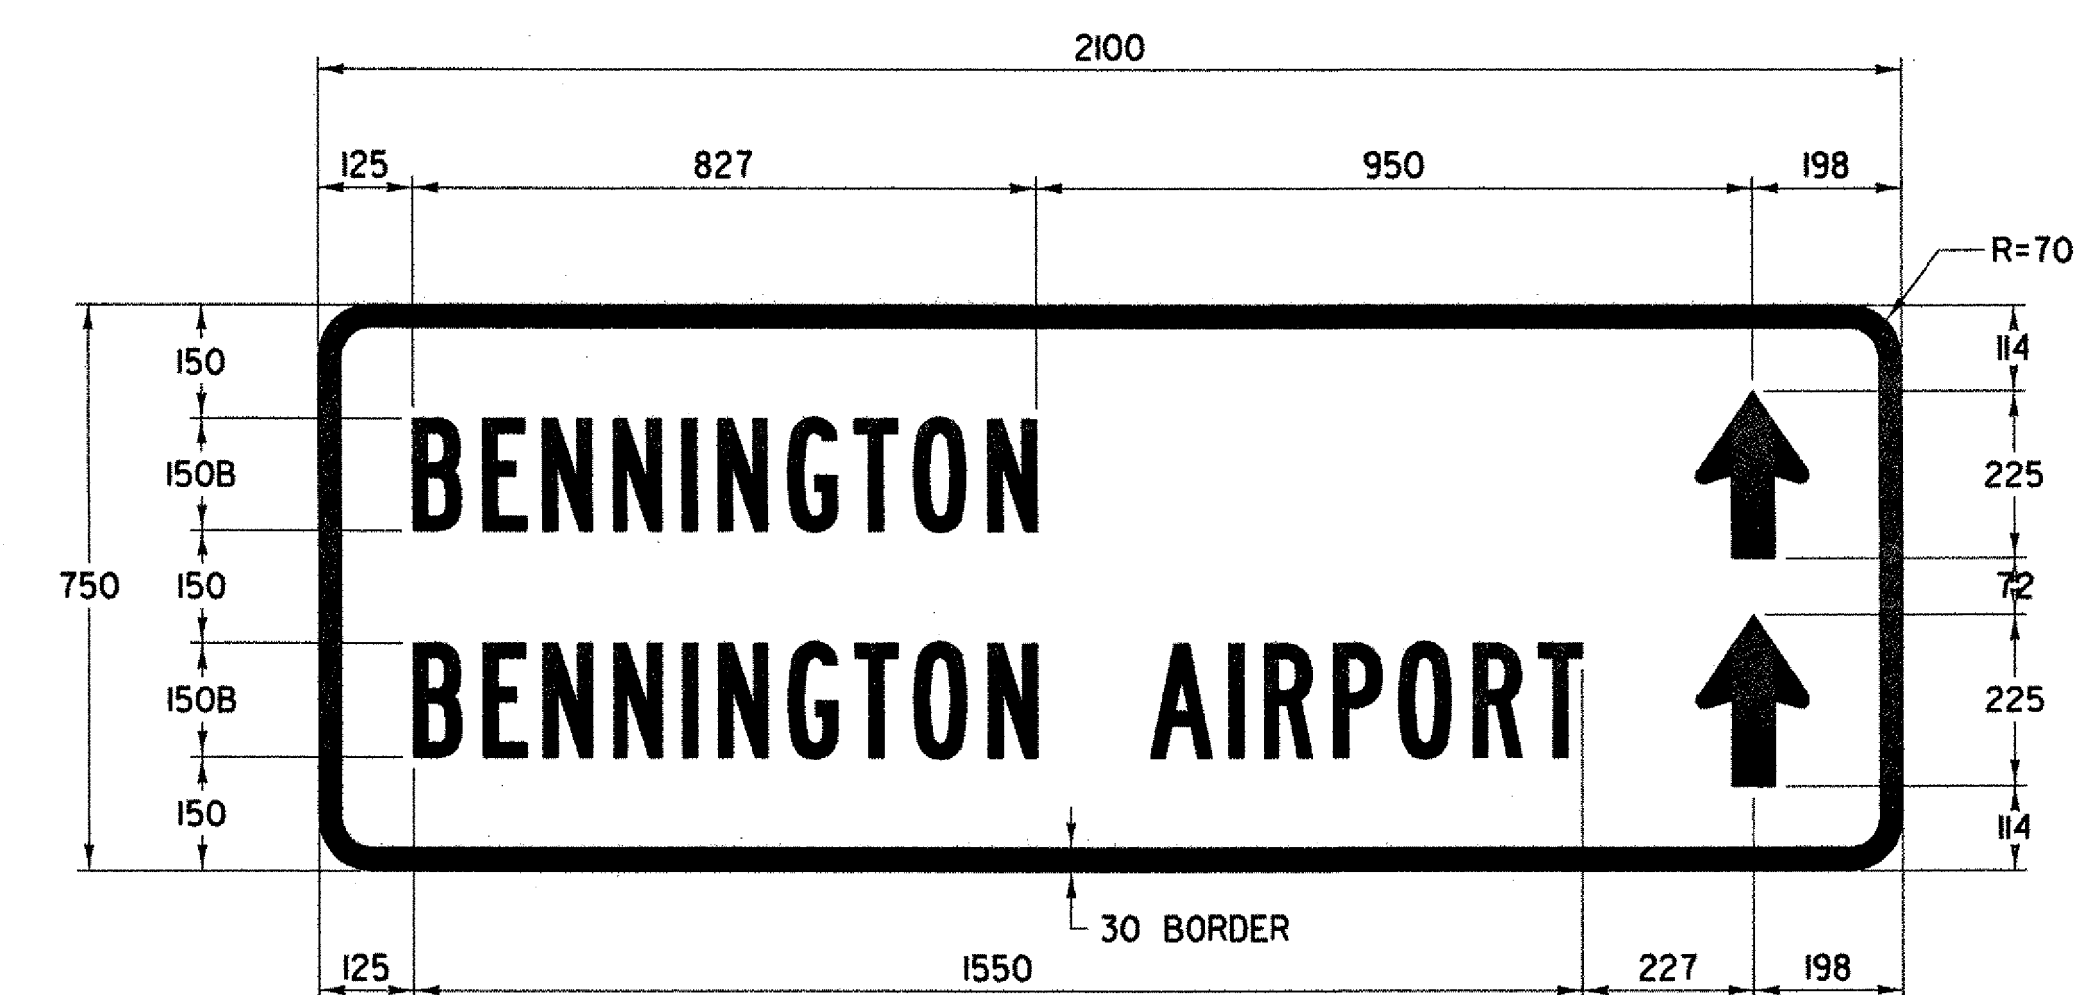


COLOR: BLACK BORDER & TEXT (REFLECTORIZED)
ORANGE BACKGROUND (REFLECTORIZED)


DATUM	
VERTICAL	NAVD 88
HORIZONTAL	NAD 83 (1992)

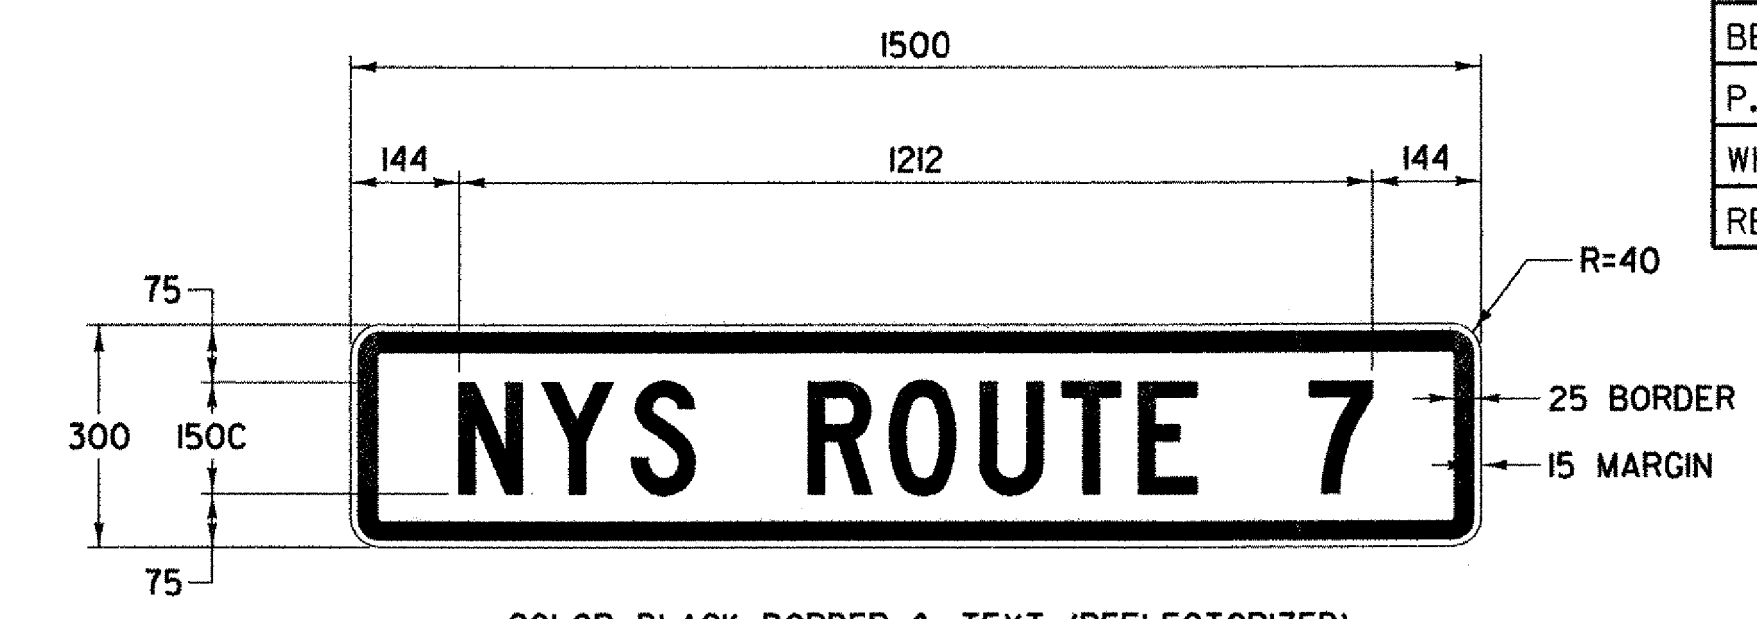

COLOR: BLACK BORDER & TEXT (REFLECTORIZED)
ORANGE BACKGROUND (REFLECTORIZED)

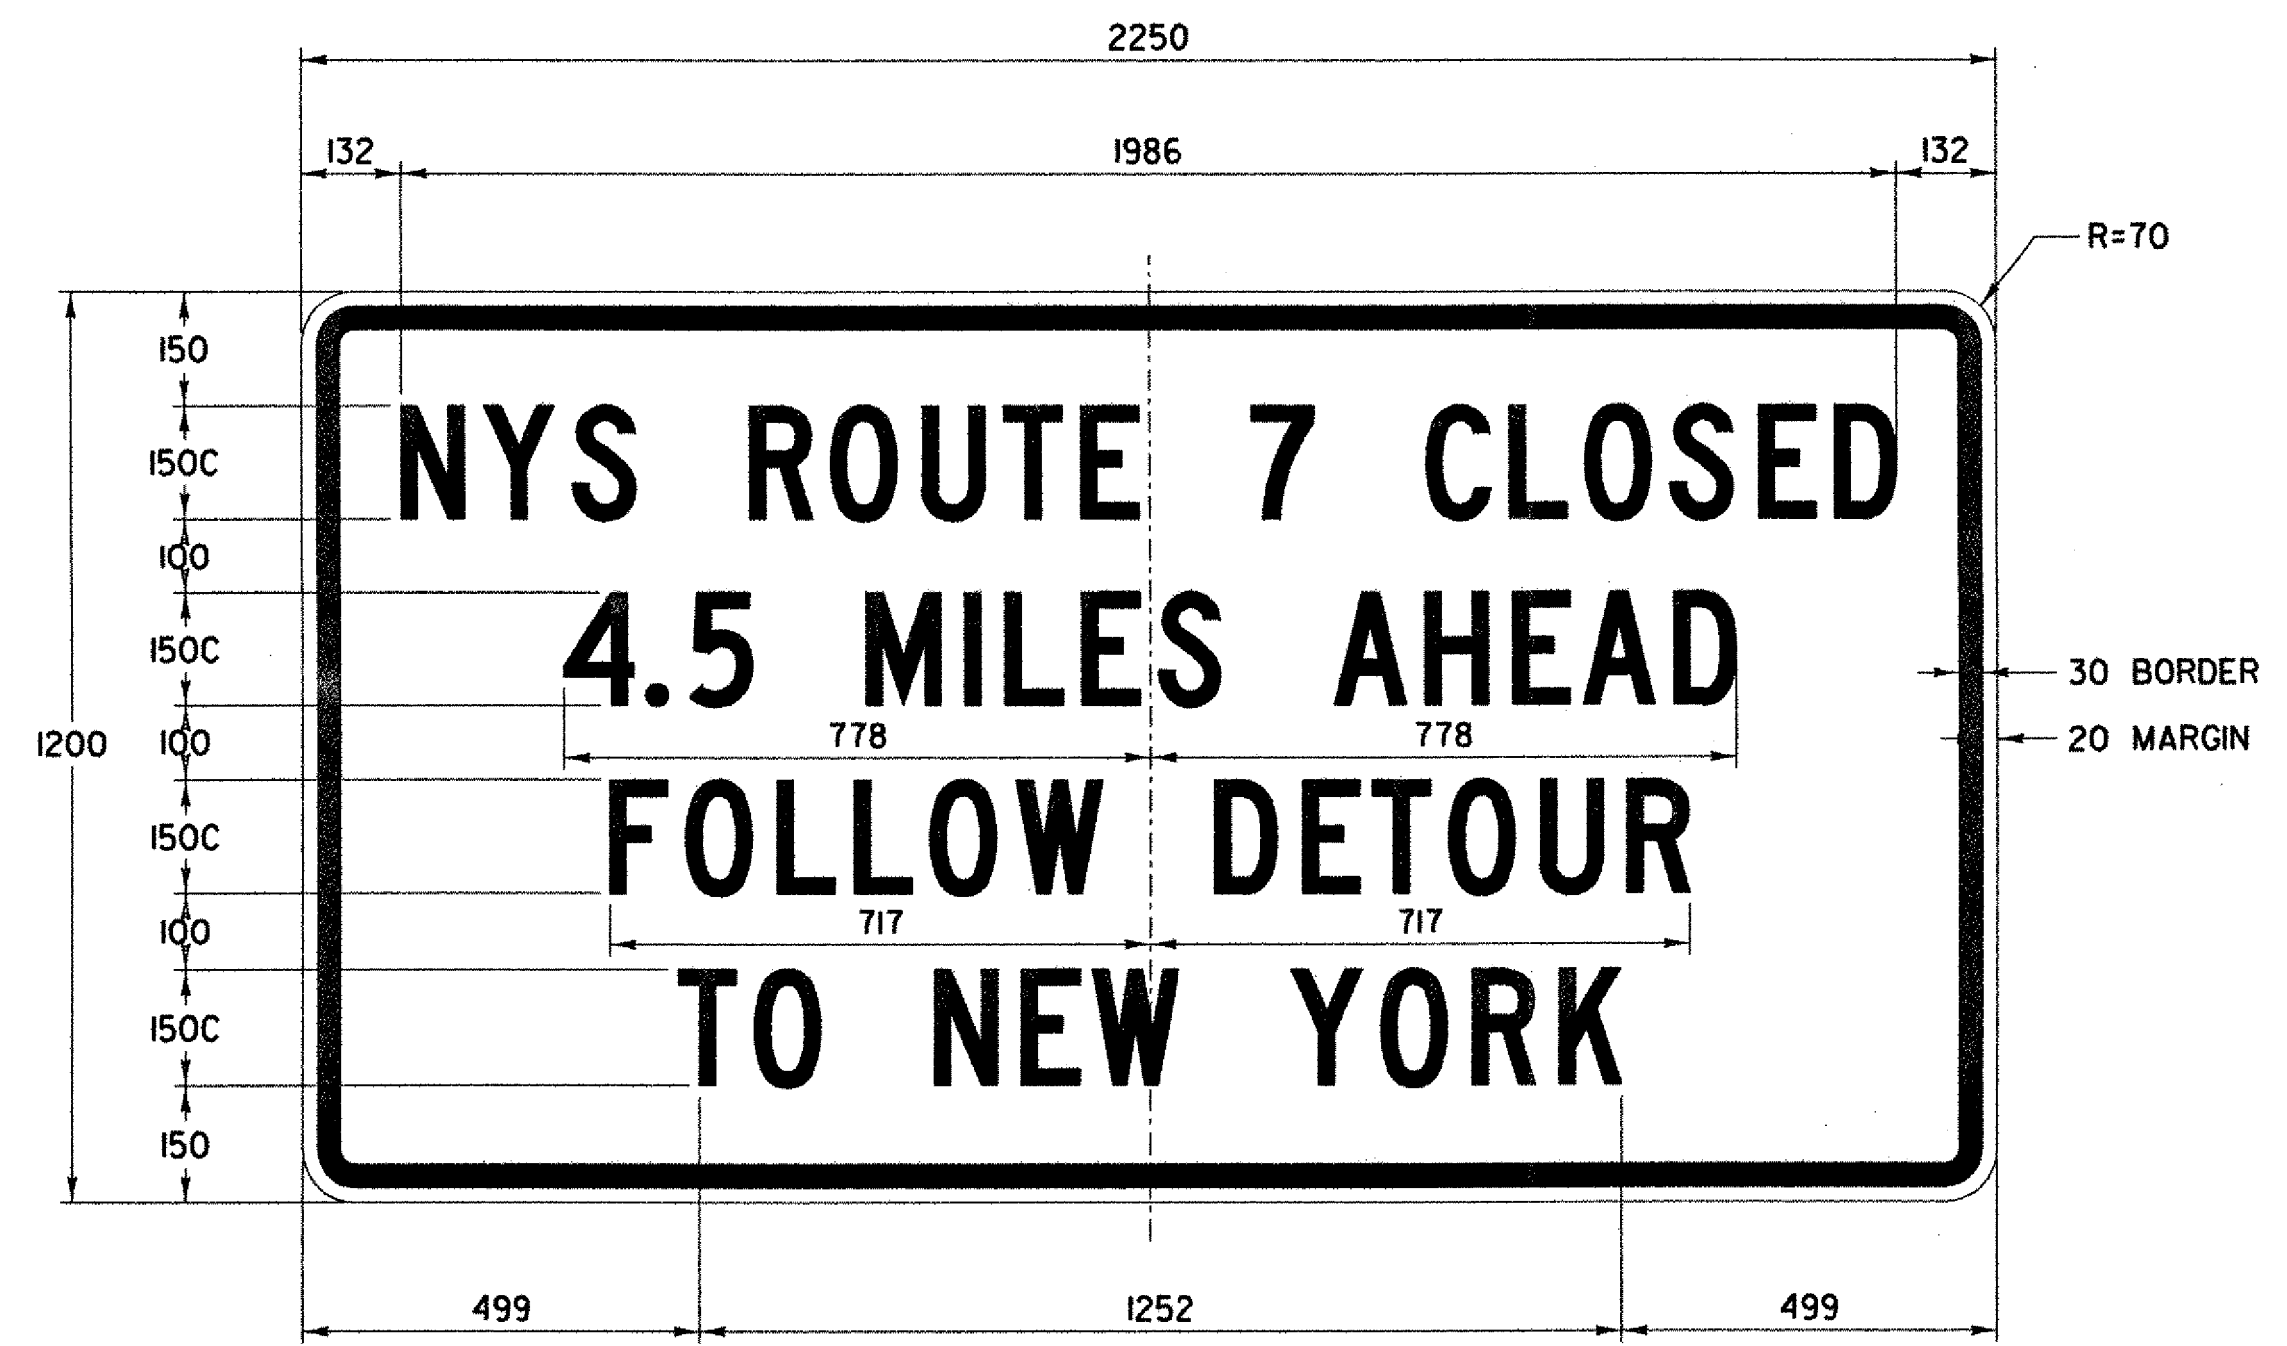

COLOR: BLACK BORDER & TEXT (REFLECTORIZED)
ORANGE BACKGROUND (REFLECTORIZED)

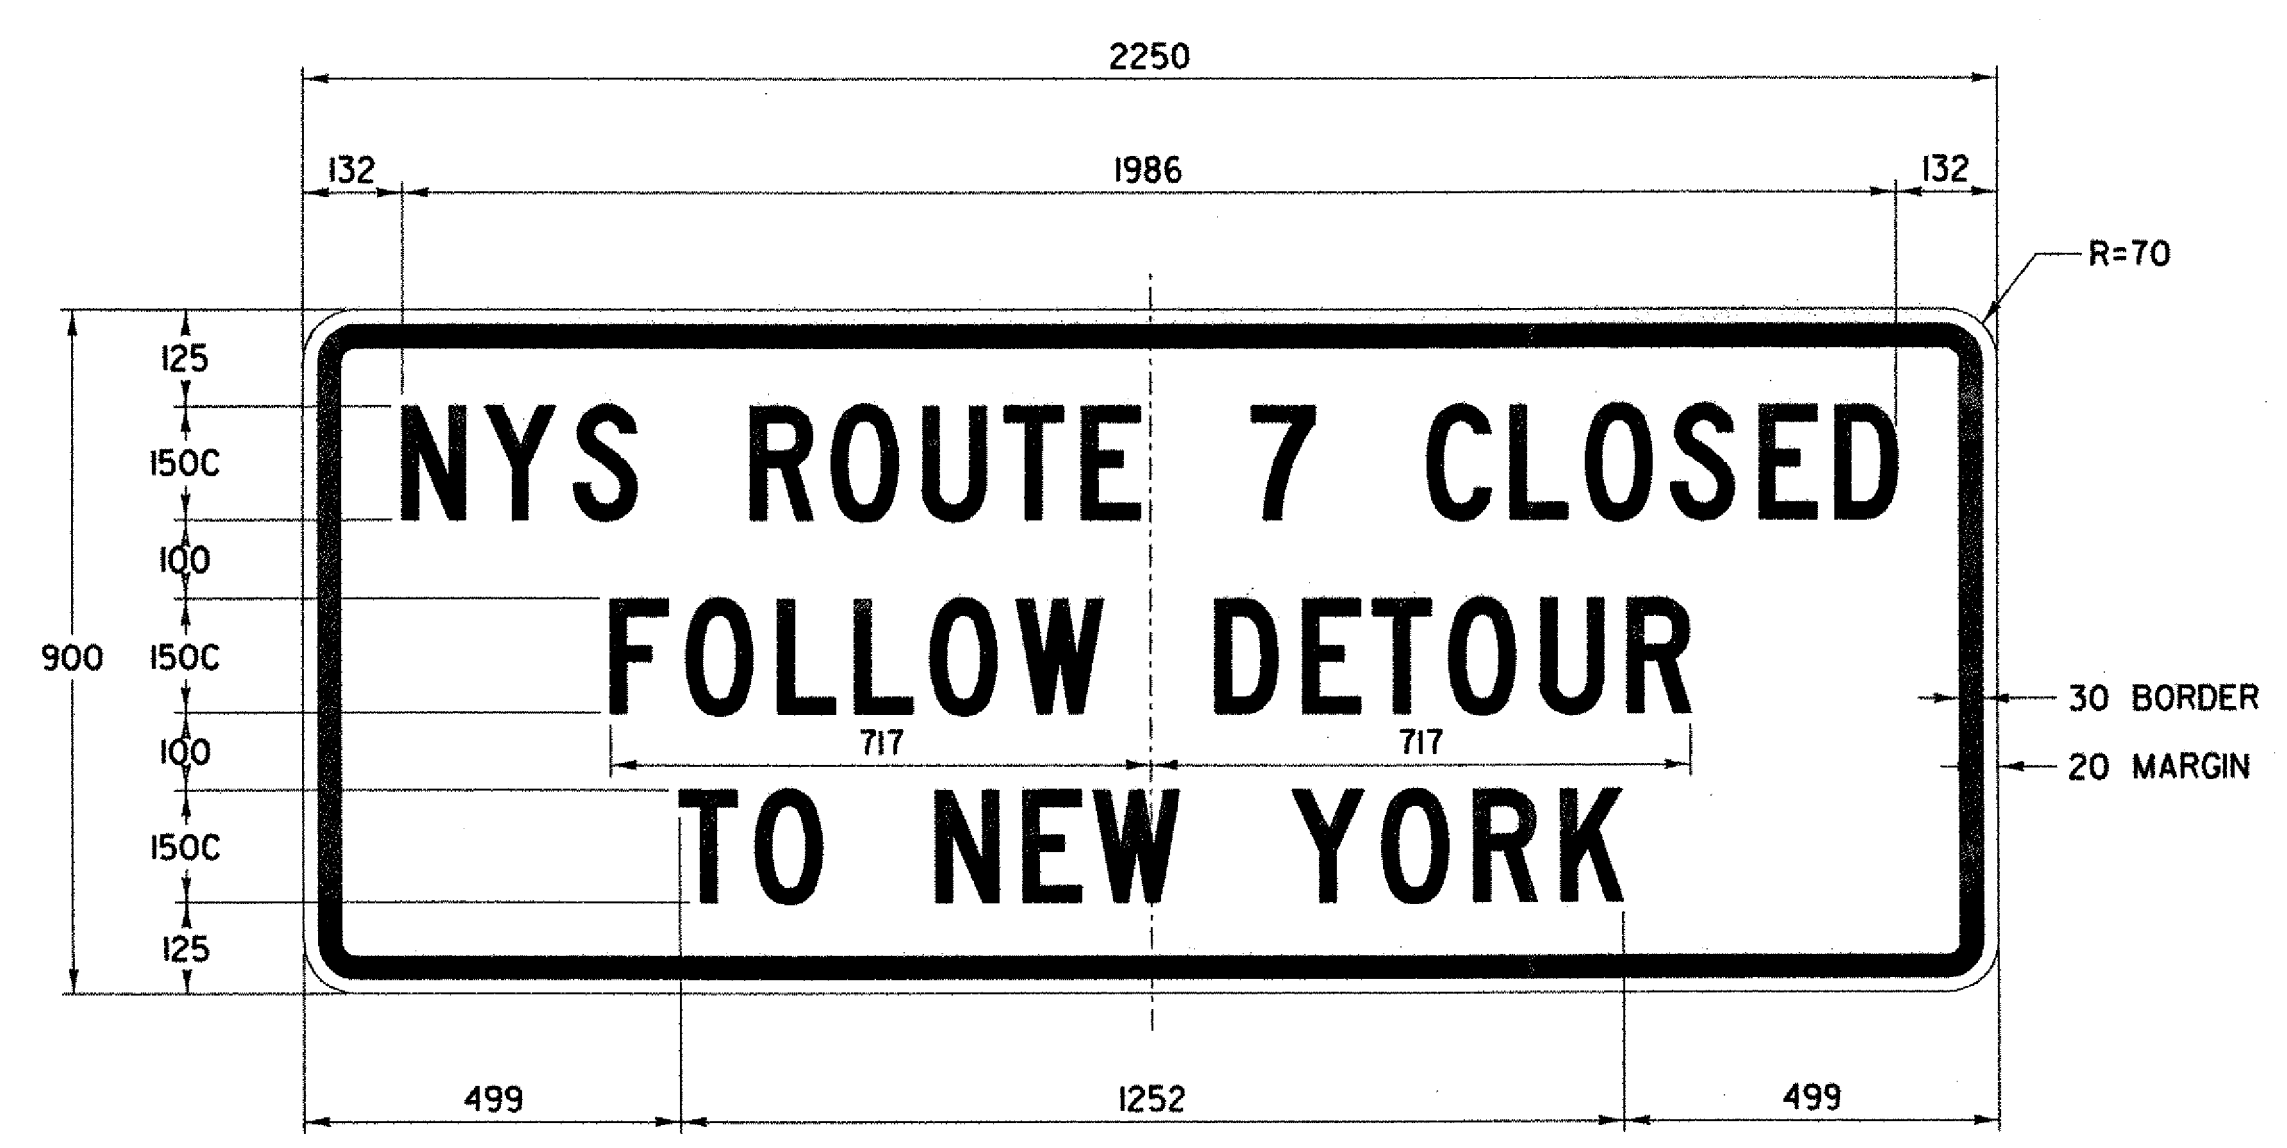

COLOR: BLACK BORDER & TEXT (REFLECTORIZED)
ORANGE BACKGROUND (REFLECTORIZED)

DETOUR NOT USED

NOTE:
ALL DIMENSIONS IN MILLIMETERS
UNLESS OTHERWISE NOTED.

MAINTENANCE AND PROTECTION OF TRAFFIC

SURVEYED BY	C.H.A. & V.S.E.	DATE	12/93
DESIGNED BY	D.W.E.	DATE	2/04
DRAWN BY	C.A.K.	DATE	2/04
CHECKED BY	T.P.K.	DATE	2/04
DESIGN FILE NO.	NYTSD5.DGN		
PROJ. NAME	BENNINGTON - HOOSICK D.P.I. 0146(1) C/1		
PROJ. NO.	P.I.N. 1306.60		
SHEET	23 OF 92	DWG NO.	MPT-5