
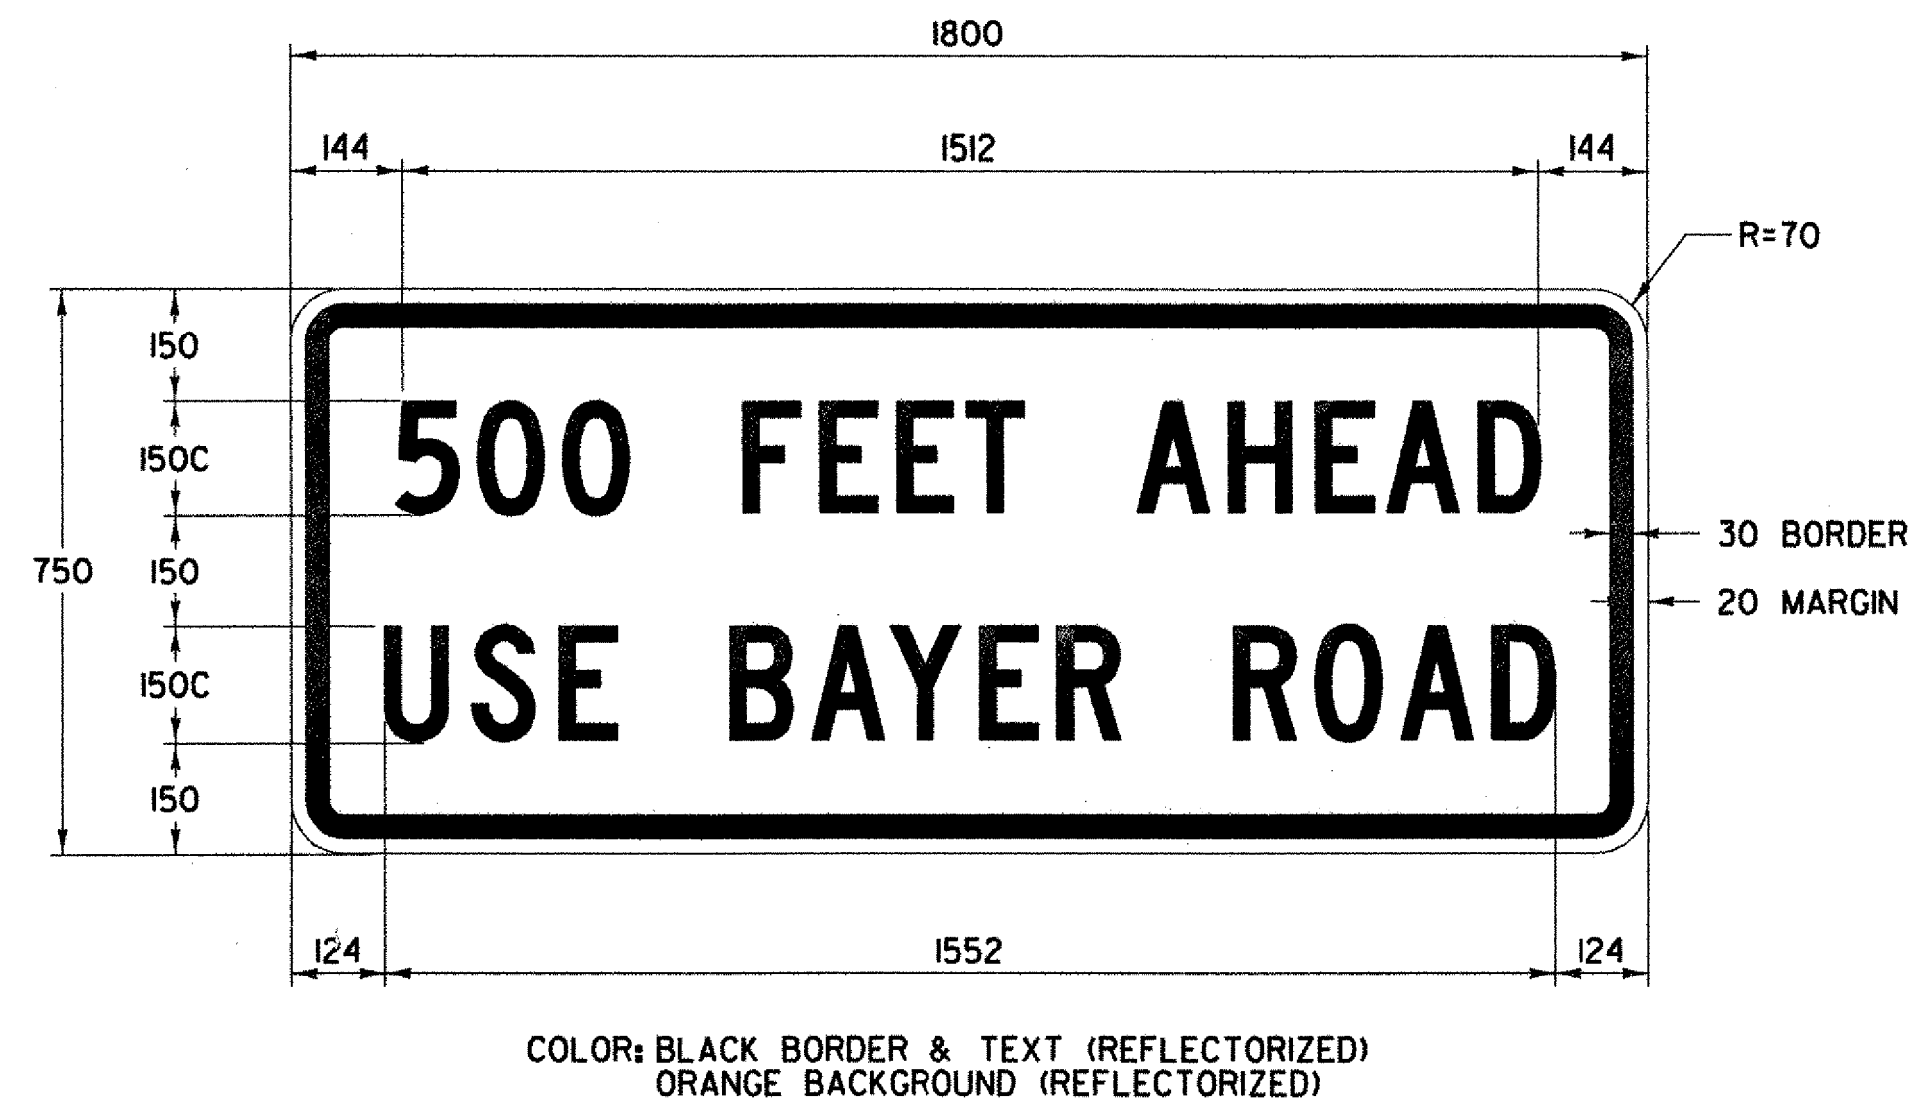
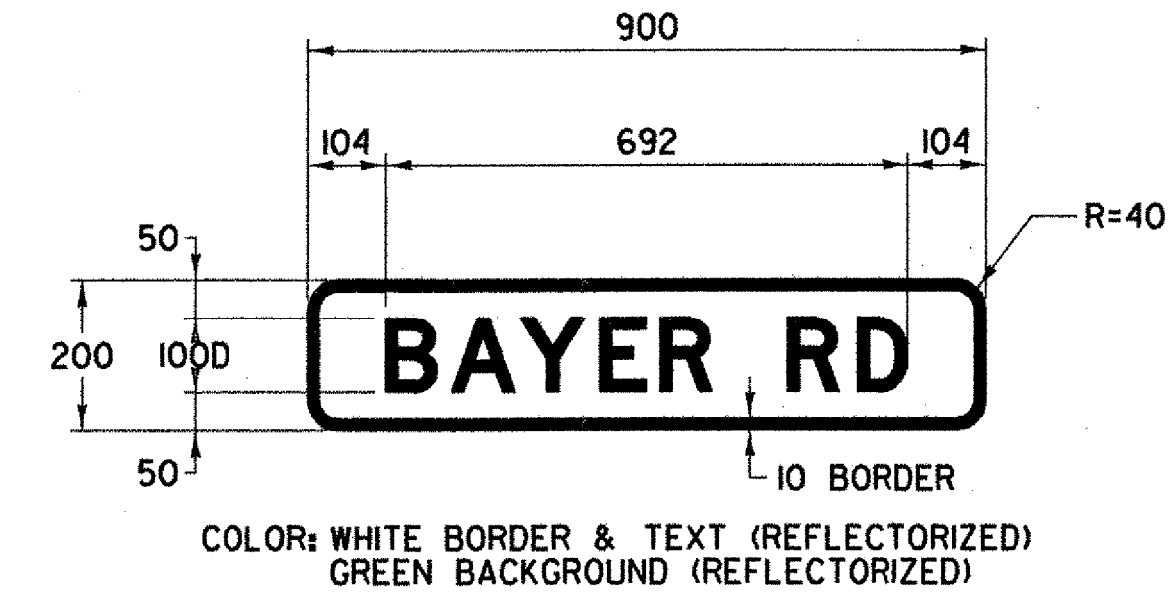


FED. ROAD REG. NO.	STATE	FEDERAL AID PROJECT NO.	SHEET NO.	TOTAL SHEETS
1	N.Y.	0146001	24	92
BENNINGTON CONNECTOR S.H. 98-2				
P.I.N. 1306.60				
WHITEHOUSE BRIDGE - VERMONT STATE LINE S.H. 1426				
RENSSELAER COUNTY				

FILE NAME = h:\5116\mtdo\contract1\ngt2d6.dgn
 DATE/TIME = 2/23/2004
 USER = 2225
 IN CHARGE OF I. KARIS DESIGNED BY D. EMERICH CHECKED BY D. EMERICH ESTIMATED BY D. EMERICH CHECKED BY D. EMERICH DRAFTED BY D. GOZALKOWSKI CHECKED BY D. GOZALKOWSKI DRAFTED BY C. KAHLBAUGH CHECKED BY I. BURTNICK DATE 2/04

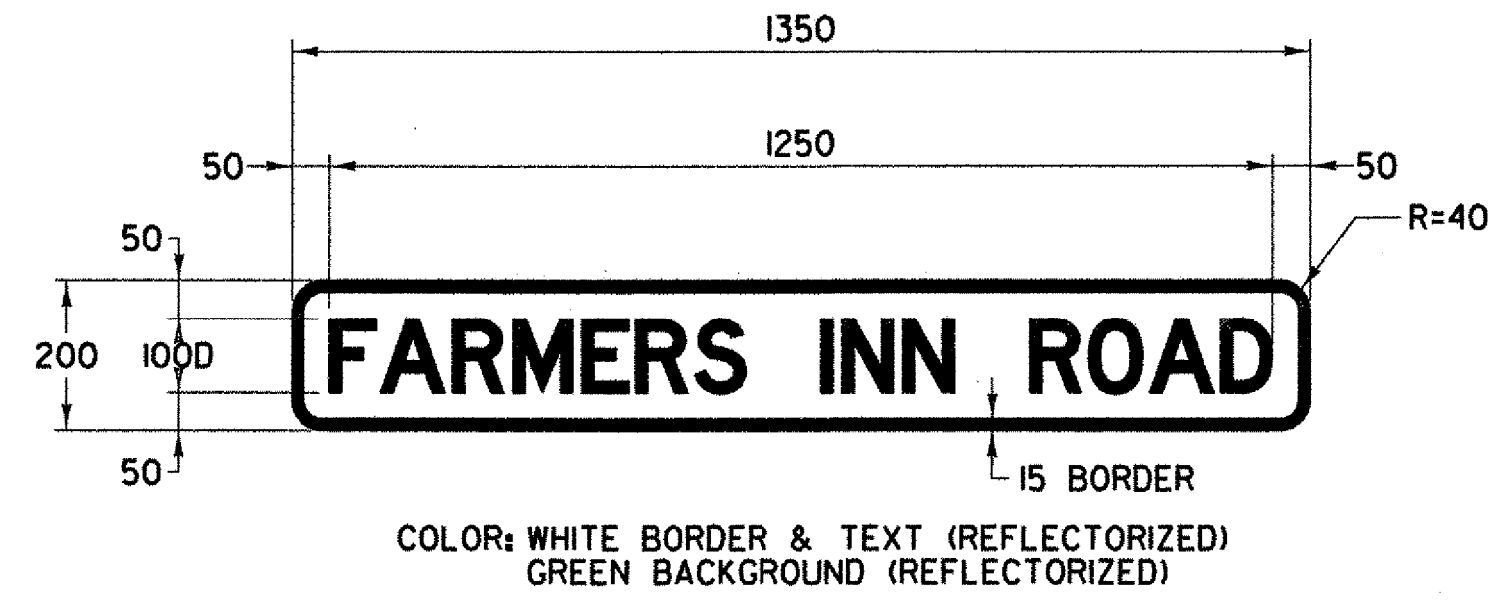

DETOUR NOT USED

DATUM	
VERTICAL	NAVD 88
HORIZONTAL	NAD 83 (1992)

NOTE:
 ALL DIMENSIONS IN MILLIMETERS
 UNLESS OTHERWISE NOTED.

MAINTENANCE AND PROTECTION OF TRAFFIC	SURVEYED BY	C.H.A. & V.S.E.	DATE	12/93
	DESIGNED BY	D.W.E.	DATE	2/04
	DRAWN BY	C.A.K.	DATE	2/04
	CHECKED BY	T.P.K.	DATE	2/04
	DESIGN FILE NO.	NYTSD6.DGN		
PROJ. NAME	BENNINGTON - HOOSICK D.P.I. 0146(1) C/1			
PROJ. NO.	P.I.N. 1306.60			
SHEET 24 OF 92	DWG NO. MPT-6			