


FED. ROAD REG. NO.	STATE	FEDERAL AID PROJECT NO.	SHEET NO.	TOTAL SHEETS
1	N.Y.	0146001	28	92
BENNINGTON CONNECTOR S.H. 98-2				
P.I.N. 1306.60				
WHITEHOUSE BRIDGE - VERMONT STATE LINE S.H. 1426				
RENSSELAER COUNTY				

FILE NAME = S:\1515\1515\contract\1515\1515.mxd
 DATE/TIME = 2/23/2004 10:22:25
 IN CHARGE OF T. KARIS
 DESIGNED BY D. EMERICH
 CHECKED BY D. EMERICH
 DRAFTED BY D. GOZALKOWSKI
 CHECKED BY D. GOZALKOWSKI
 DRAFTED BY C. KAHLBAUGH
 CHECKED BY I. BURTMICK
 DATE 2/04

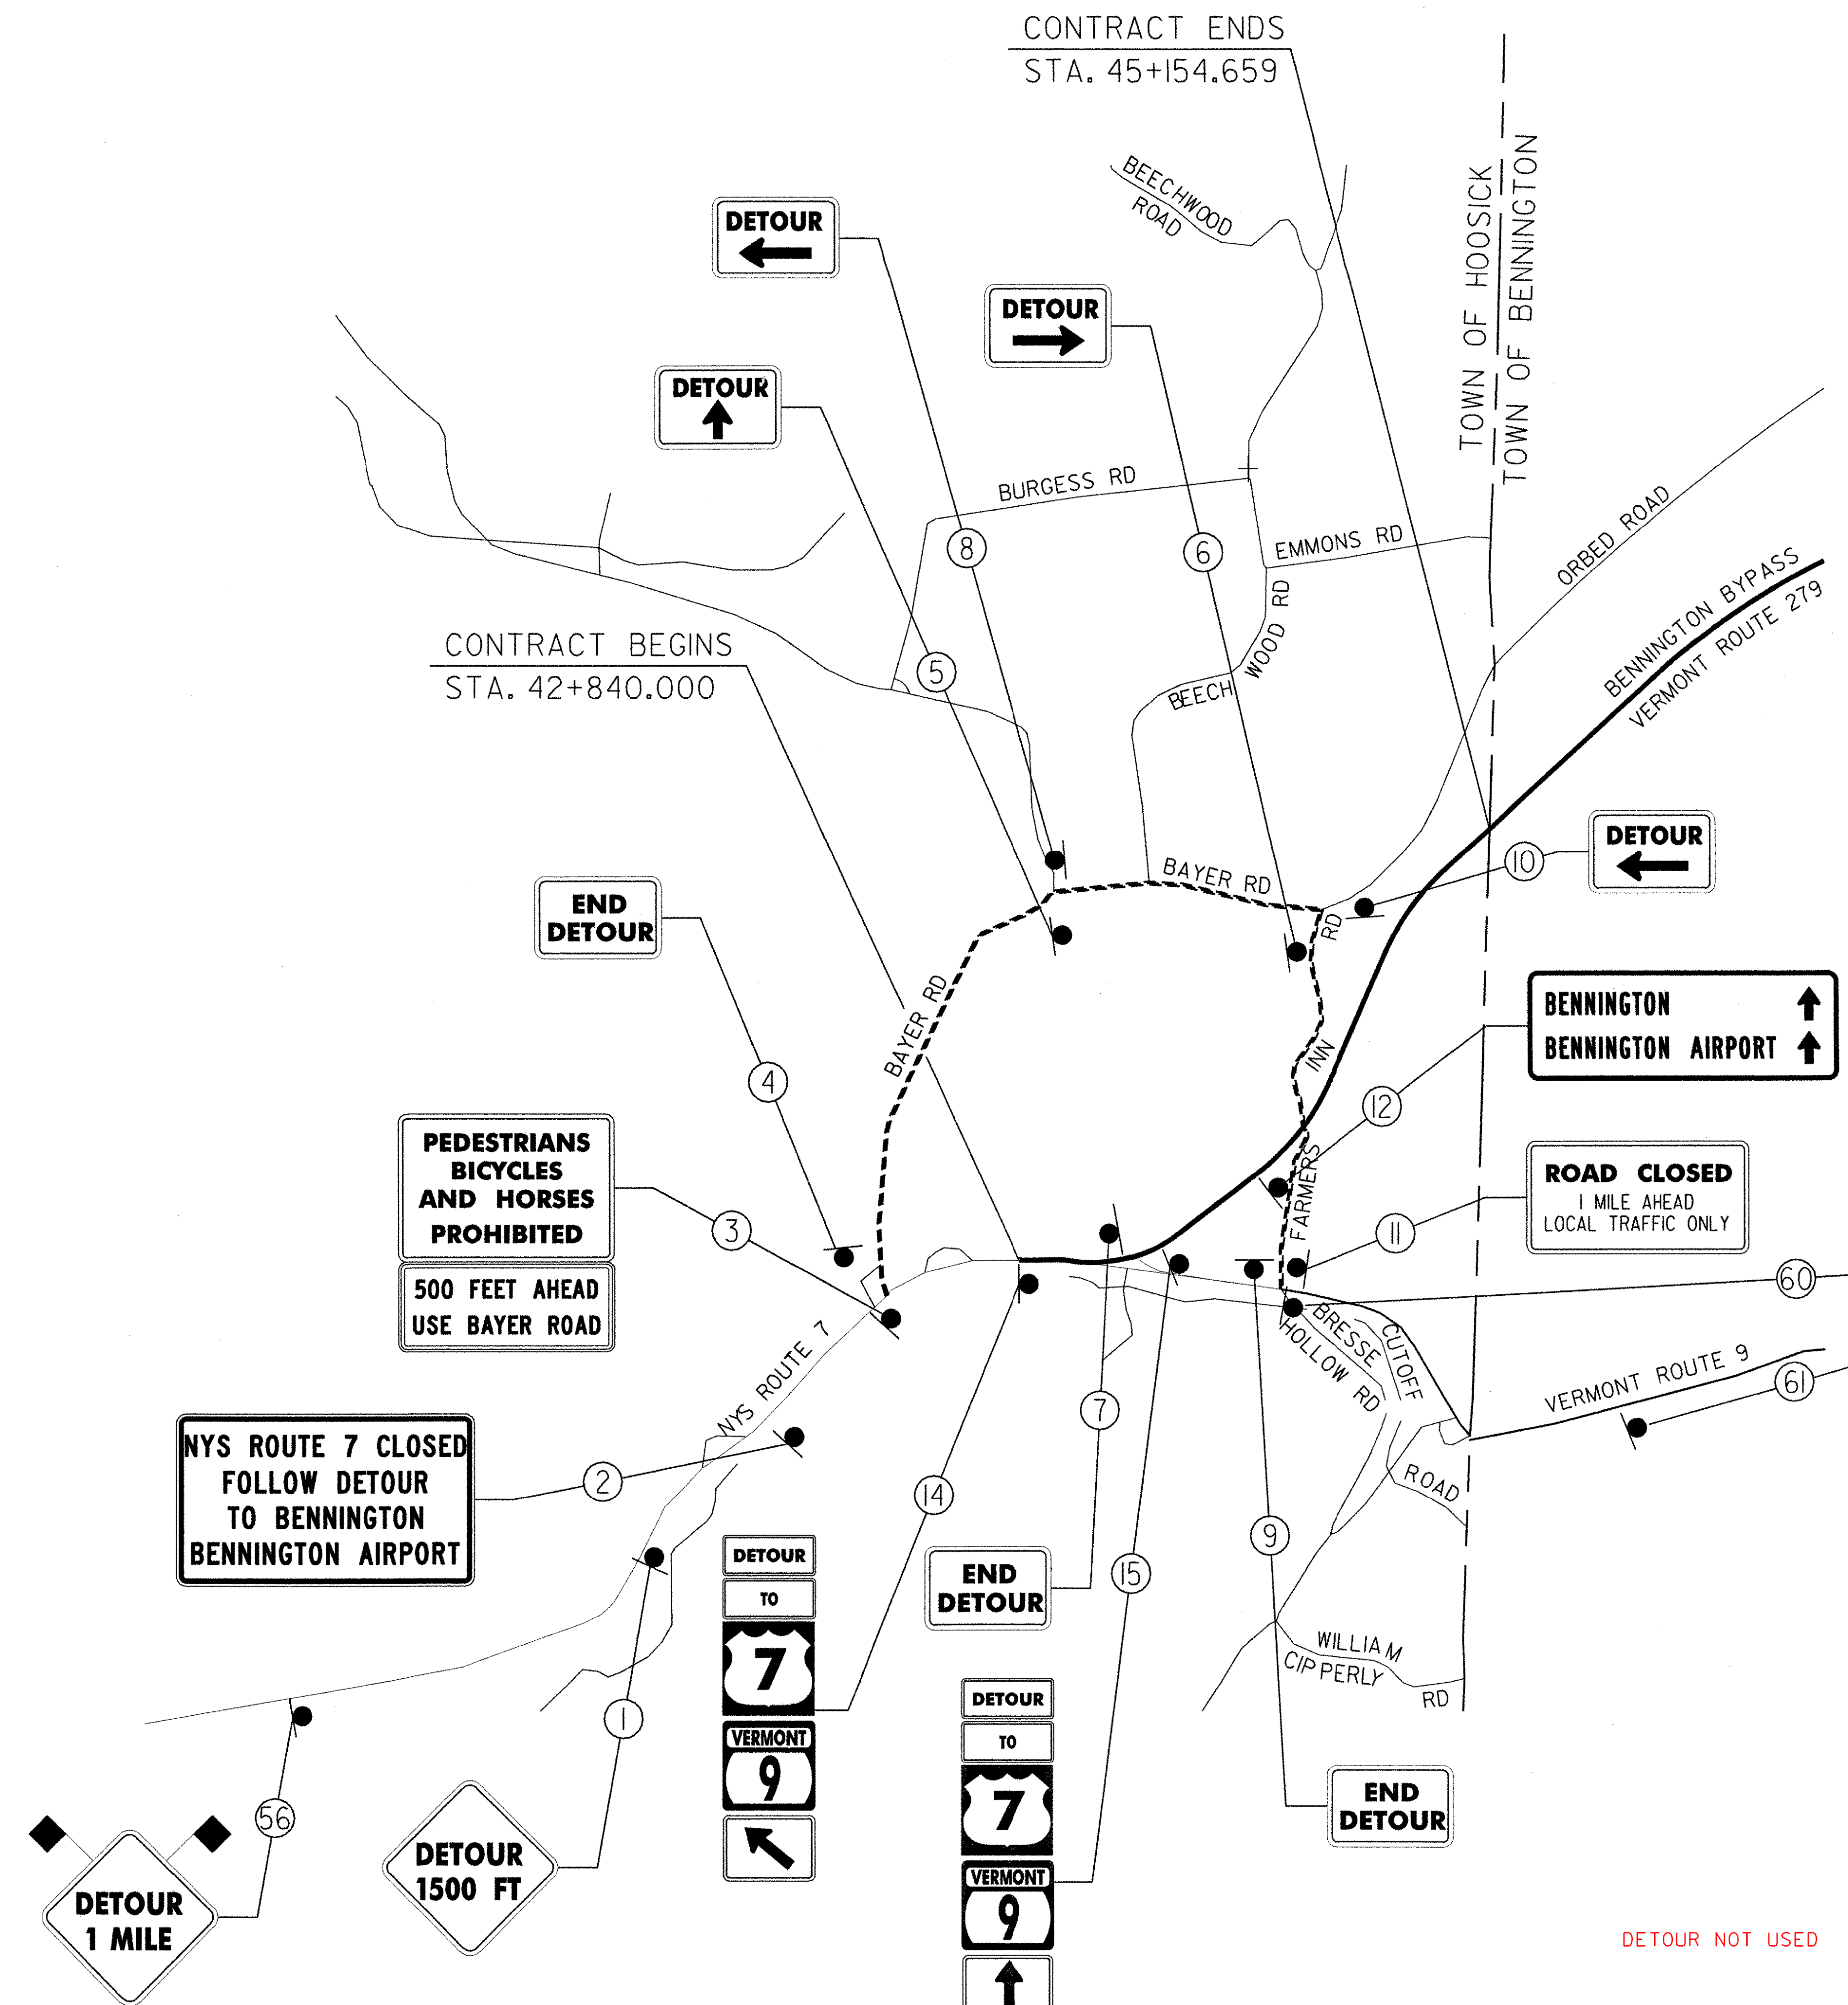

LEGEND

	DETOUR ROUTE
	PEDESTRIAN, BICYCLE & HORSES DETOUR ROUTE

CONSTRUCTION SEQUENCING PLANS

SURVEYED BY	C.H.A. & V.S.E.	DATE	12/93
DESIGNED BY	D.W.E.	DATE	2/04
DRAWN BY	C.A.K.	DATE	2/04
CHECKED BY	T.P.K.	DATE	2/04
DESIGN FILE NO.	5116MPT.DGN		
PROJ. NAME	BENNINGTON - HOOSICK D.P.I. 0146(1) C/1		
PROJ. NO.	P.I.N. 1306.60		
SHEET 28 OF 92	DWG NO. CSP-4		

DATUM

VERTICAL	NAVD 88
HORIZONTAL	NAD 83 (1992)

DETOUR NOT USED