


| FED. ROAD REG. NO. | STATE | FEDERAL AID PROJECT NO. | SHEET NO. | TOTAL SHEETS |
|--------------------|-------|-------------------------|-----------|--------------|
| 1 | N.Y. | 0146001 | 30 | 92 |

BENNINGTON CONNECTOR S.H. 98-2
 P.I.N. 1306.60
 WHITEHOUSE BRIDGE - VERMONT STATE LINE S.H. 1426
 RENSSELAER COUNTY

FILE NAME: s:\1515\1515\project\contract\1515\1515.mxd
 DATE/TIME: 2/23/2004 10:22:25
 IN CHARGE OF: T. KARIS
 DESIGNED BY: D. EMERICH
 CHECKED BY: D. EMERICH
 ESTIMATED BY: D. GOZALKOWSKI
 DRAFTED BY: D. GOZALKOWSKI
 CHECKED BY: C. KAHLBAUGH
 CHECKED BY: I. BURTNICK
 DATE: 2/04

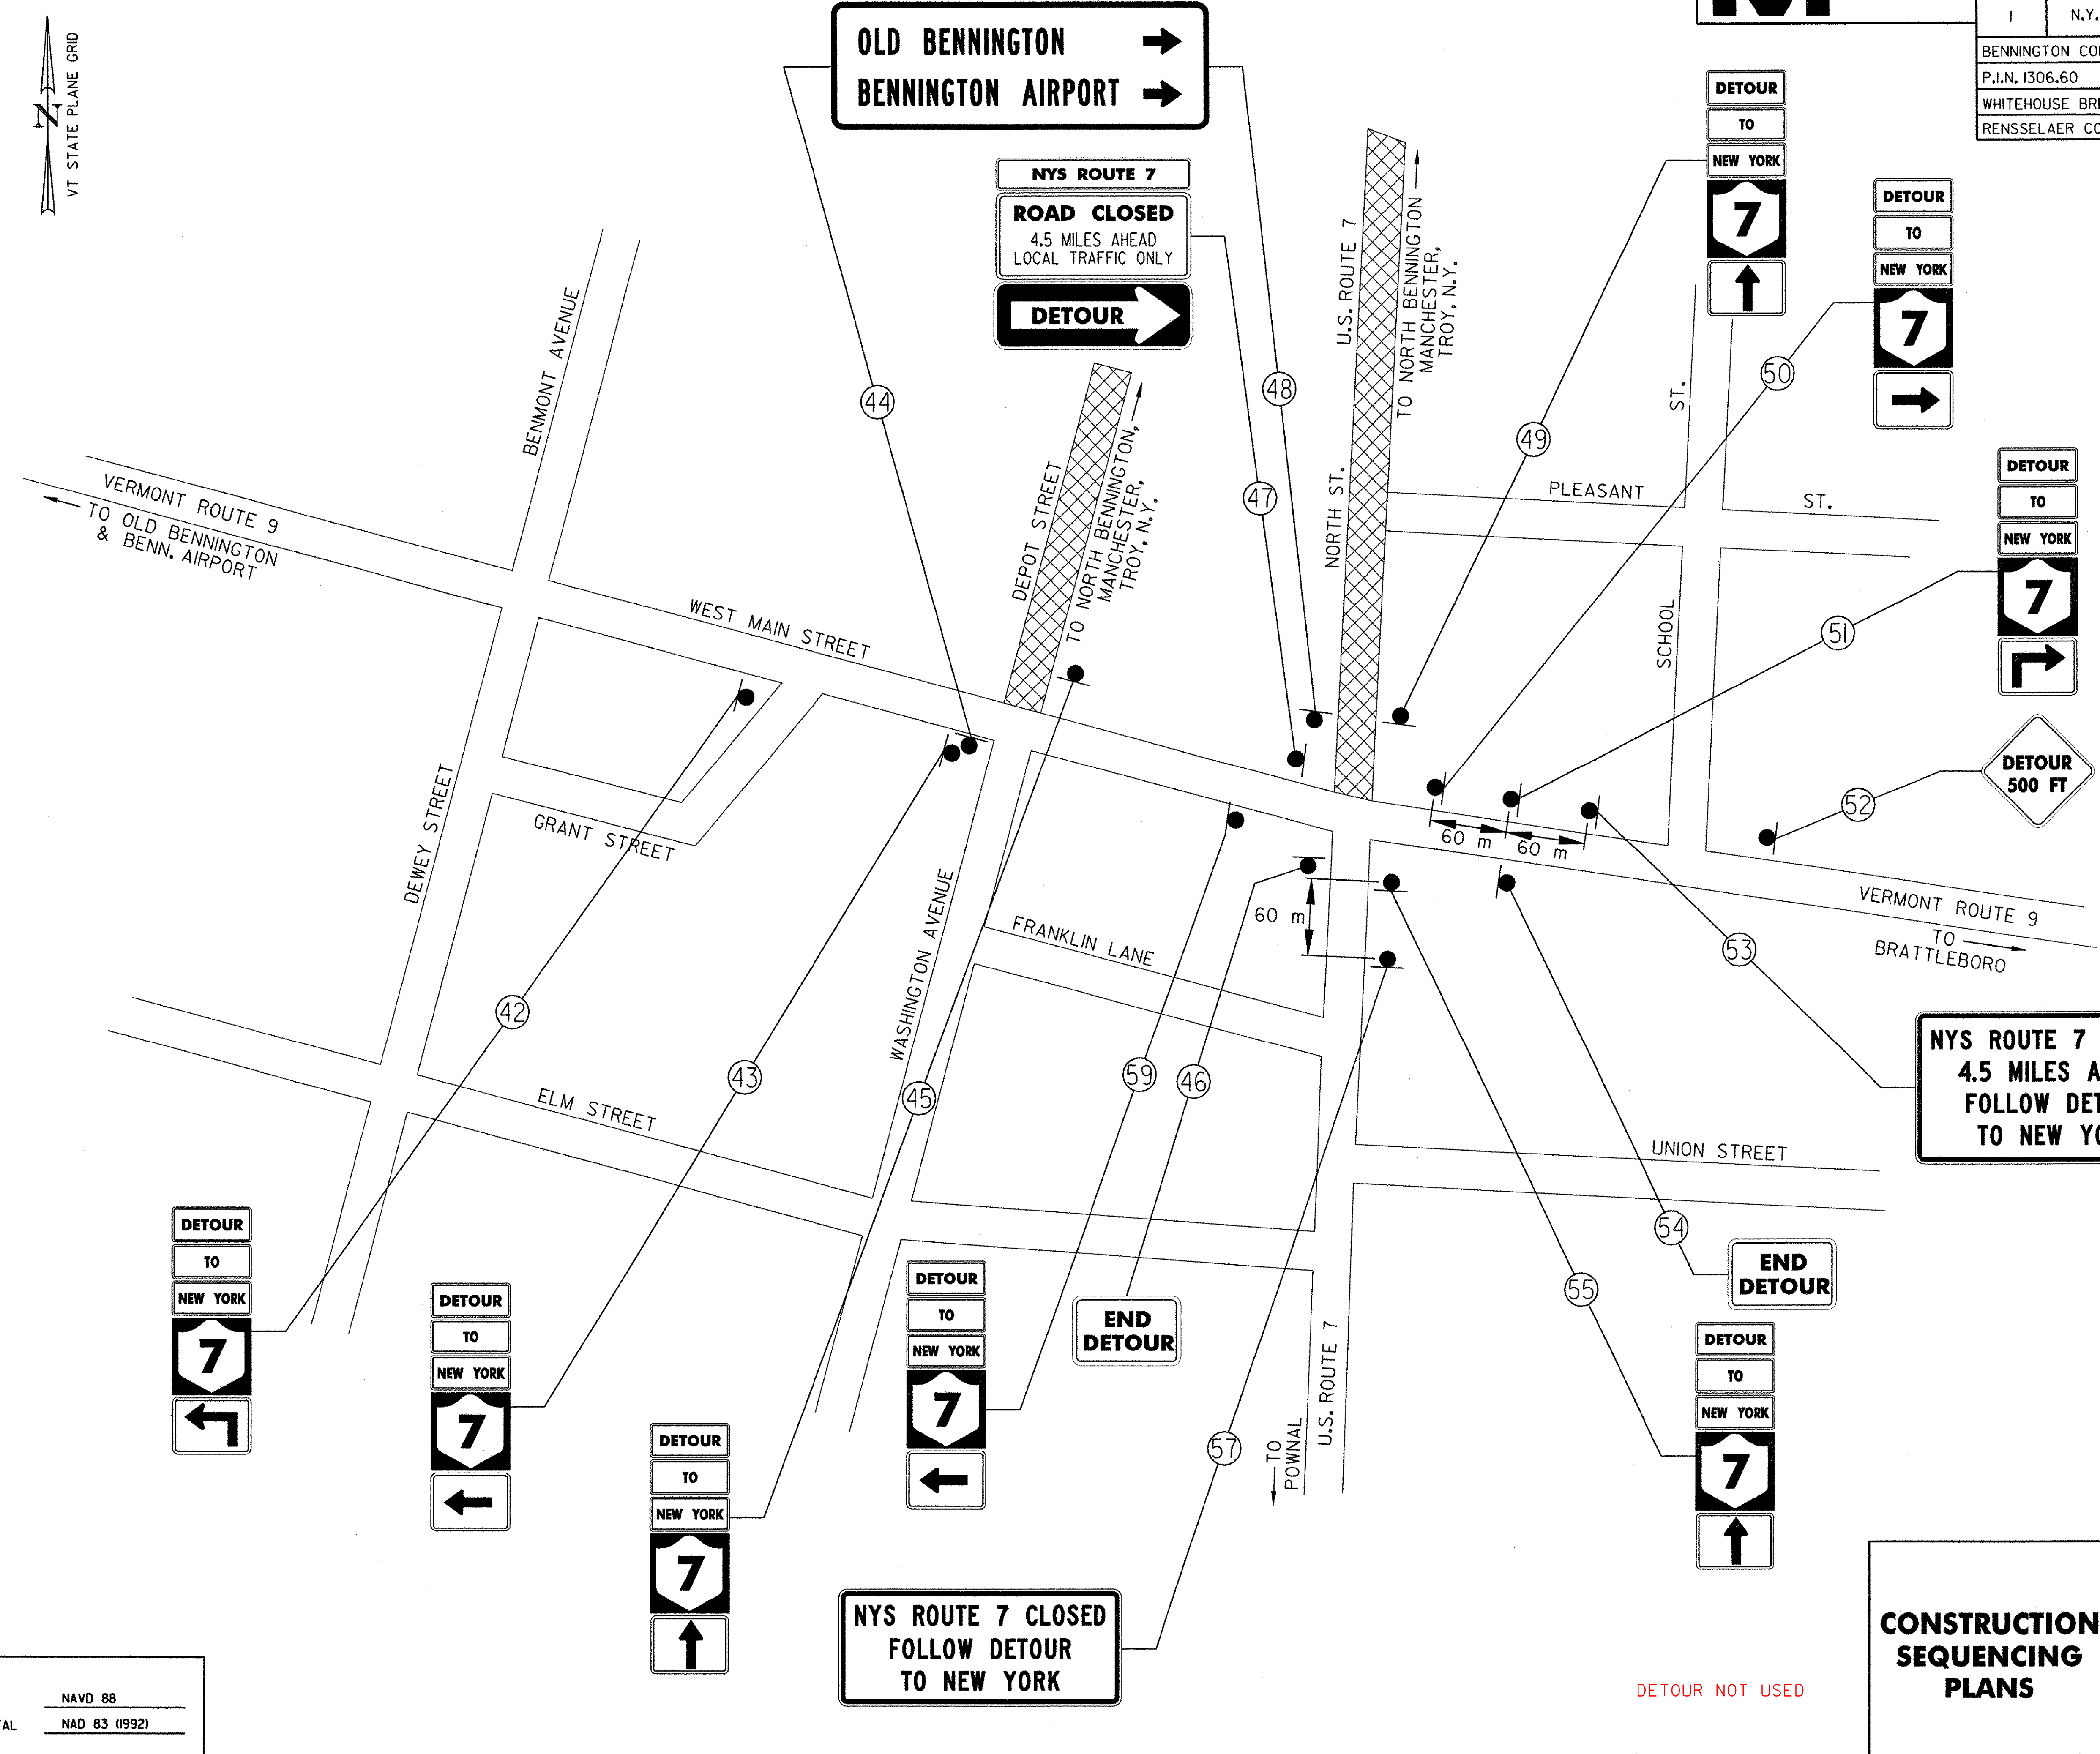

| | |
|------------|---------------|
| DATUM | |
| VERTICAL | NAVD 88 |
| HORIZONTAL | NAD 83 (1992) |

| CONSTRUCTION SEQUENCING PLANS | |
|-------------------------------|---|
| SURVEYED BY | C.H.A. & V.S.E. DATE 12/93 |
| DESIGNED BY | D.W.E. DATE 2/04 |
| DRAWN BY | C.A.K. DATE 2/04 |
| CHECKED BY | T.P.K. DATE 2/04 |
| DESIGN FILE NO. | 516MPT.DGN |
| PROJ. NAME | BENNINGTON - HOOSICK D.P.I. 0146(1) C/1 |
| PROJ. NO. | P.I.N. 1306.60 |
| SHEET | 30 OF 92 |
| DWG NO. | CSP-6 |

| LEGEND | |
|--------|--------------|
| | DETOUR ROUTE |