





FED. ROAD REG. NO.	STATE	FEDERAL AID PROJECT NO.	SHEET NO.	TOTAL SHEETS
I	N.Y.	0146001	51	92
BENNINGTON CONNECTOR S.H. 98-2				
P.I.N. 1306.60				
WHITEHOUSE BRIDGE - VERMONT STATE LINE S.H. 1426				
RENSSELAER COUNTY				

LEGEND	
	EXISTING WETLAND SOIL TO BE REMOVED AND USED FOR PROPOSED WETLAND AREA ESTABLISHMENT
	PROPOSED WETLAND AREA TO BE ESTABLISHED AND SEEDED
	EXISTING WETLAND TO REMAIN

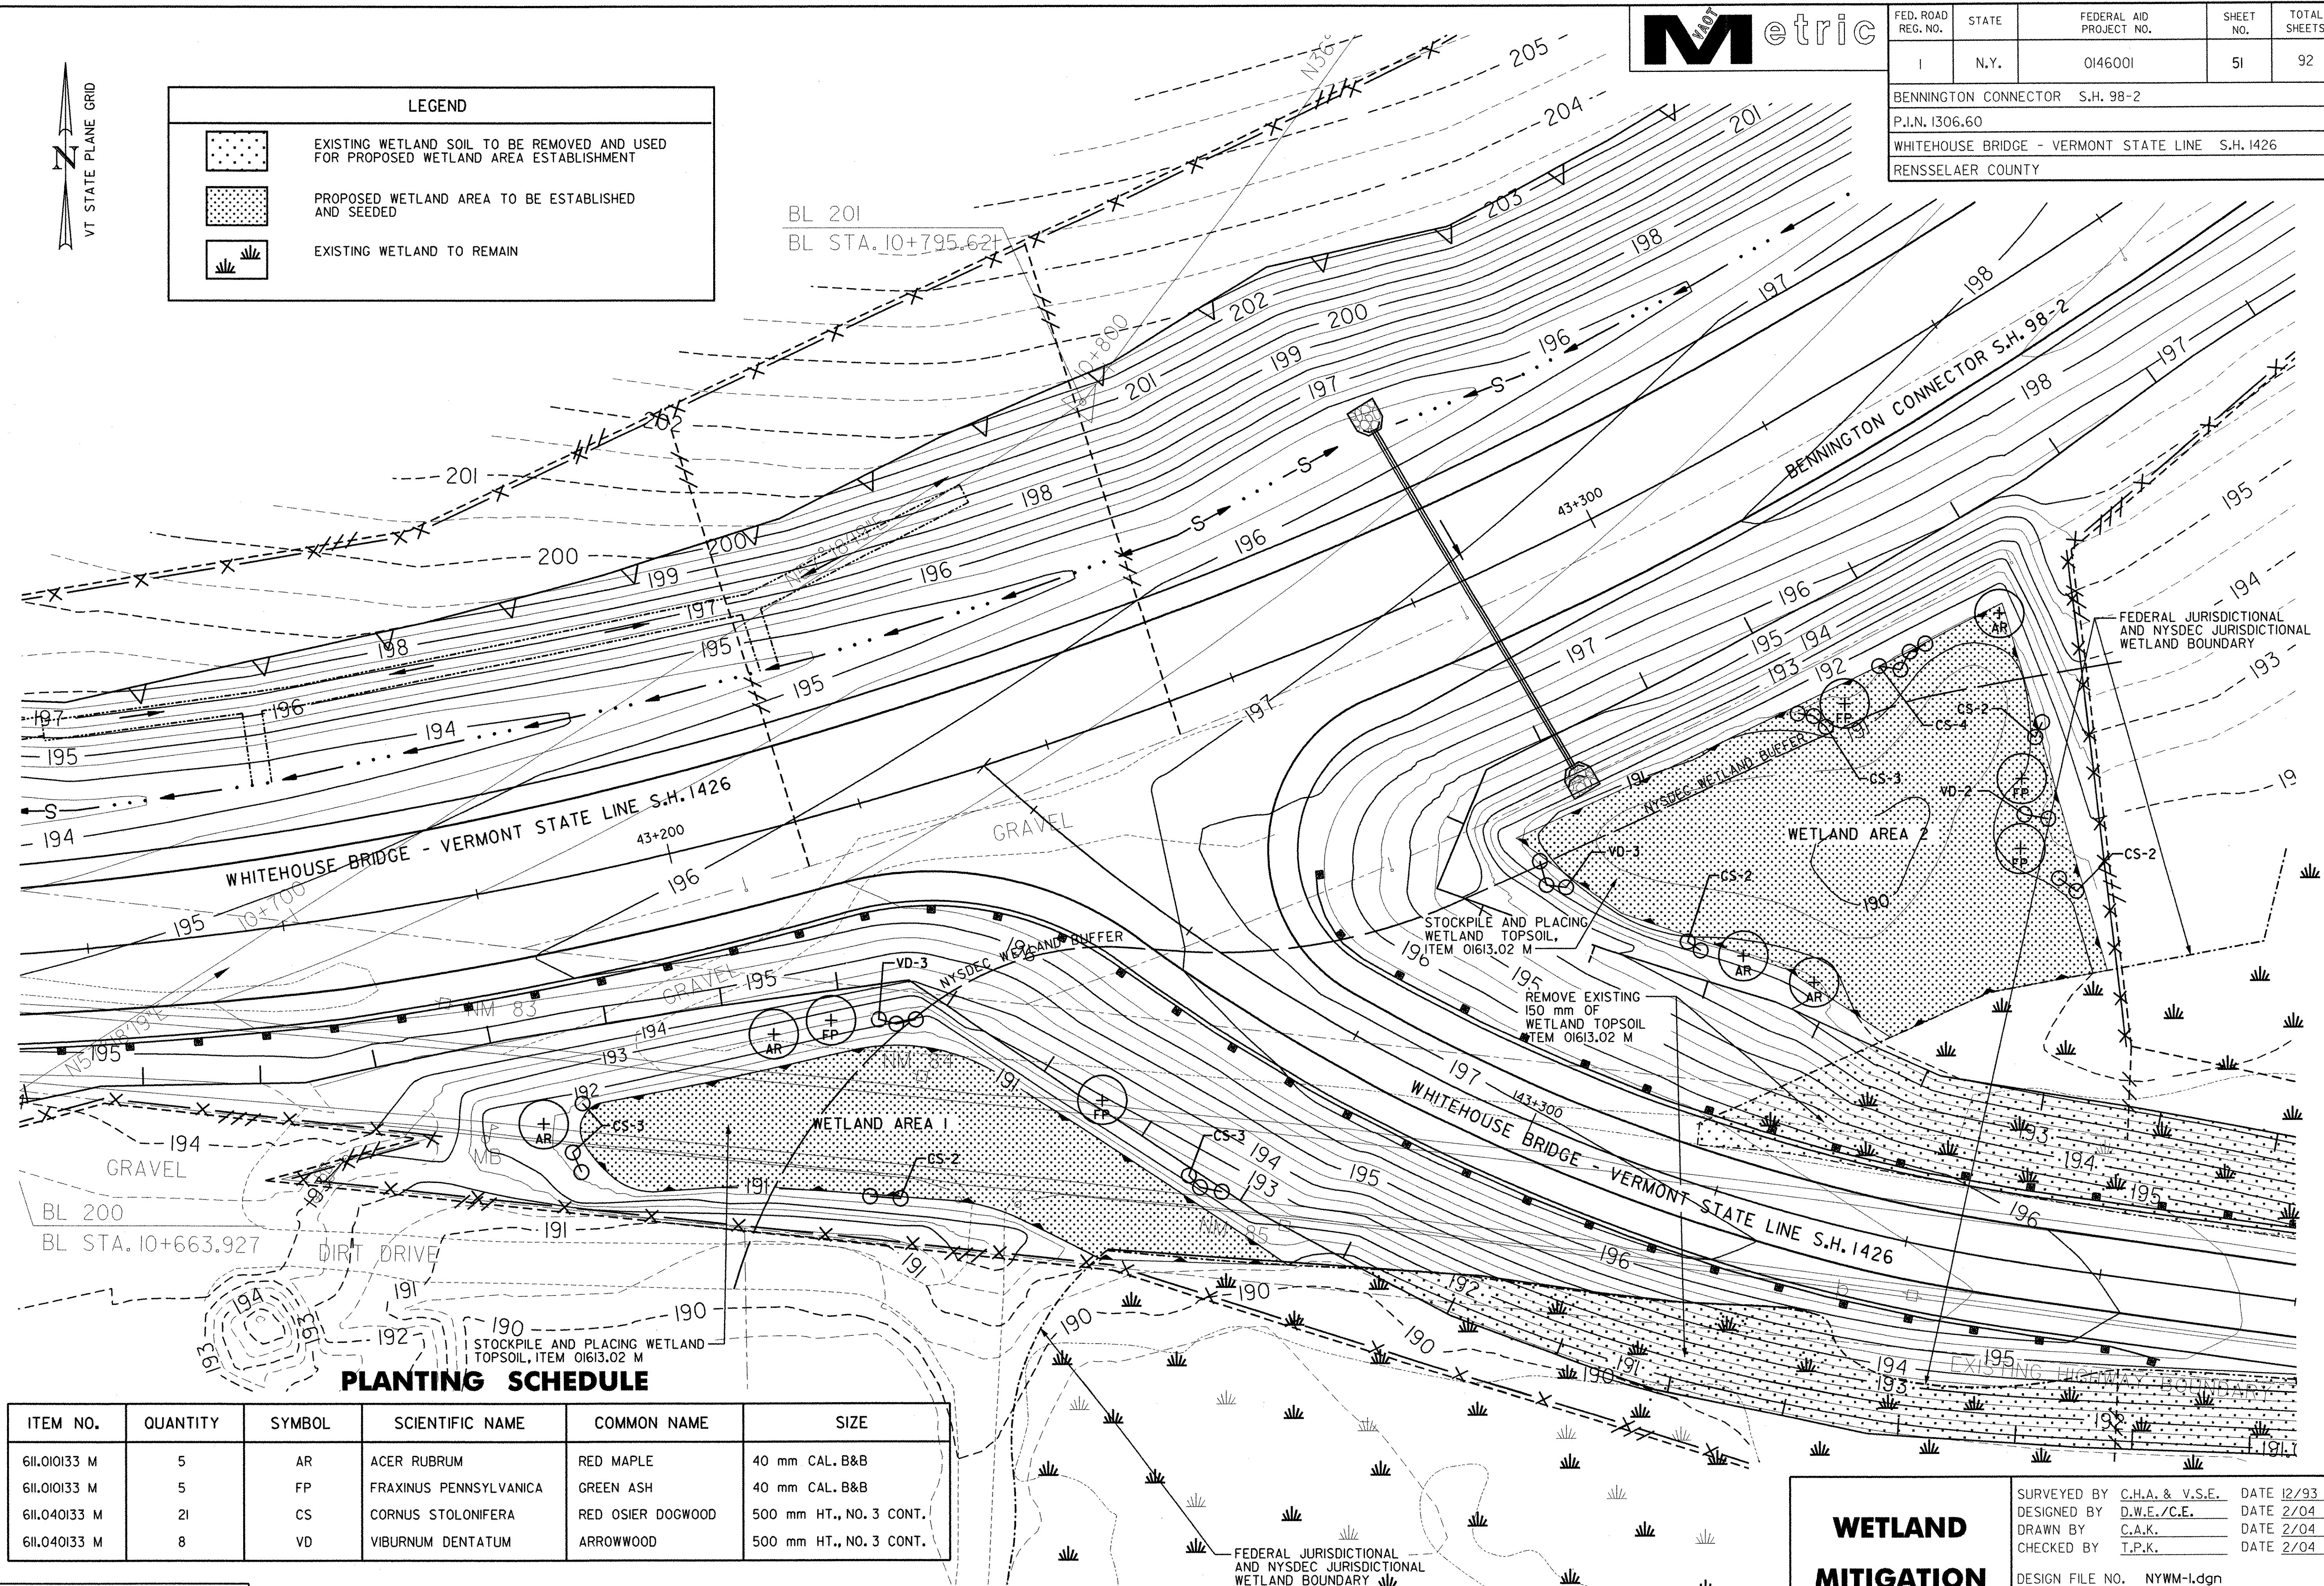

ITEM NO.	QUANTITY	SYMBOL	SCIENTIFIC NAME	COMMON NAME	SIZE
61L010133 M	5	AR	ACER RUBRUM	RED MAPLE	40 mm CAL. B&B
61L010133 M	5	FP	FRAXINUS PENNSYLVANICA	GREEN ASH	40 mm CAL. B&B
61L040133 M	21	CS	CORNUS STOLONIFERA	RED OSIER DOGWOOD	500 mm HT., NO. 3 CONT.
61L040133 M	8	VD	VIBURNUM DENTATUM	ARROWWOOD	500 mm HT., NO. 3 CONT.

DATUM	
VERTICAL	<u>NAVD 88</u>
HORIZONTAL	<u>NAD 83 (1992)</u>

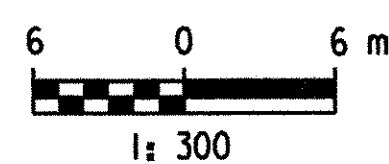

WETLAND MITIGATION PLAN

SURVEYED BY	<u>C.H.A. & V.S.E.</u>	DATE	<u>12/93</u>
DESIGNED BY	<u>D.W.E./C.E.</u>	DATE	<u>2/04</u>
DRAWN BY	<u>C.A.K.</u>	DATE	<u>2/04</u>
CHECKED BY	<u>T.P.K.</u>	DATE	<u>2/04</u>
DESIGN FILE NO. <u>NYWM-1.dgn</u>			
PROJ. NAME	BENNINGTON - HOOSICK D.P.I. 0146(1) C/1		
PROJ. NO.	P.I.N. 1306.60		
SHEET 51 OF	92	DWG NO. WM-1	