



FED. ROAD REG. NO.	STATE	FEDERAL AID PROJECT NO.	SHEET NO.	TOTAL SHEETS
1	N.Y.	0146001	58	92
BENNINGTON CONNECTOR S.H. 98-2				
P.J.N. 1306.60				
WHITEHOUSE BRIDGE - VERMONT STATE LINE S.H. 1426				
RENSSELAER COUNTY				


TABLE OF R.O.W. MARKERS

STATION	OFFSET (m)	ITEM 625.04 M (EA)	ITEM 625.05 M (EA)
10+456.186	16.449 RT		1
10+456.034	18.474 RT		1
10+495.654	29.493 RT	1	
10+547.003	14.914 RT	1	
10+562.999	15.294 RT	1	
10+564.699	47.634 RT		1
10+598.322	16.889 LT		1
10+608.202	16.371 RT	1	
10+608.567	25.637 LT	1	
10+625.351	39.875 LT	1	
10+636.496	17.044 RT		1
10+673.484	5.728 RT		1
10+683.060	21.168 RT		1
10+698.304	25.879 RT	1	
10+730.984	26.332 LT	1	
10+750.953	75.217 RT	1	
10+759.484	22.499 LT	1	
10+801.383*	135.795 RT	1	
10+807.736	124.385 RT	1	
10+822.995*	151.015 RT	1	
10+834.665	246.716 RT	1	
10+842.232	249.371 RT	1	
10+866.603	252.035 RT	1	
TOTAL QUANTITY		16	7

*STATION LOCATED BY EXTENDING BACK STATION AHEAD

LEGEND			
ITEM NO.	DESCRIPTION	UNIT	SYMBOL
625.04 M	CONCRETE RIGHT-OF-WAY MARKERS, TYPE L (LOW)	EA	L
625.05 M	STEEL PIN AND CAP RIGHT-OF-WAY MARKERS	EA	■

THE R.O.W. MARKER TABLE IS USED FOR ITEMS AND COUNT PLACEMENT OF RIGHT-OF-WAY MARKERS ARE FROM APPROPRIATION MAPS.

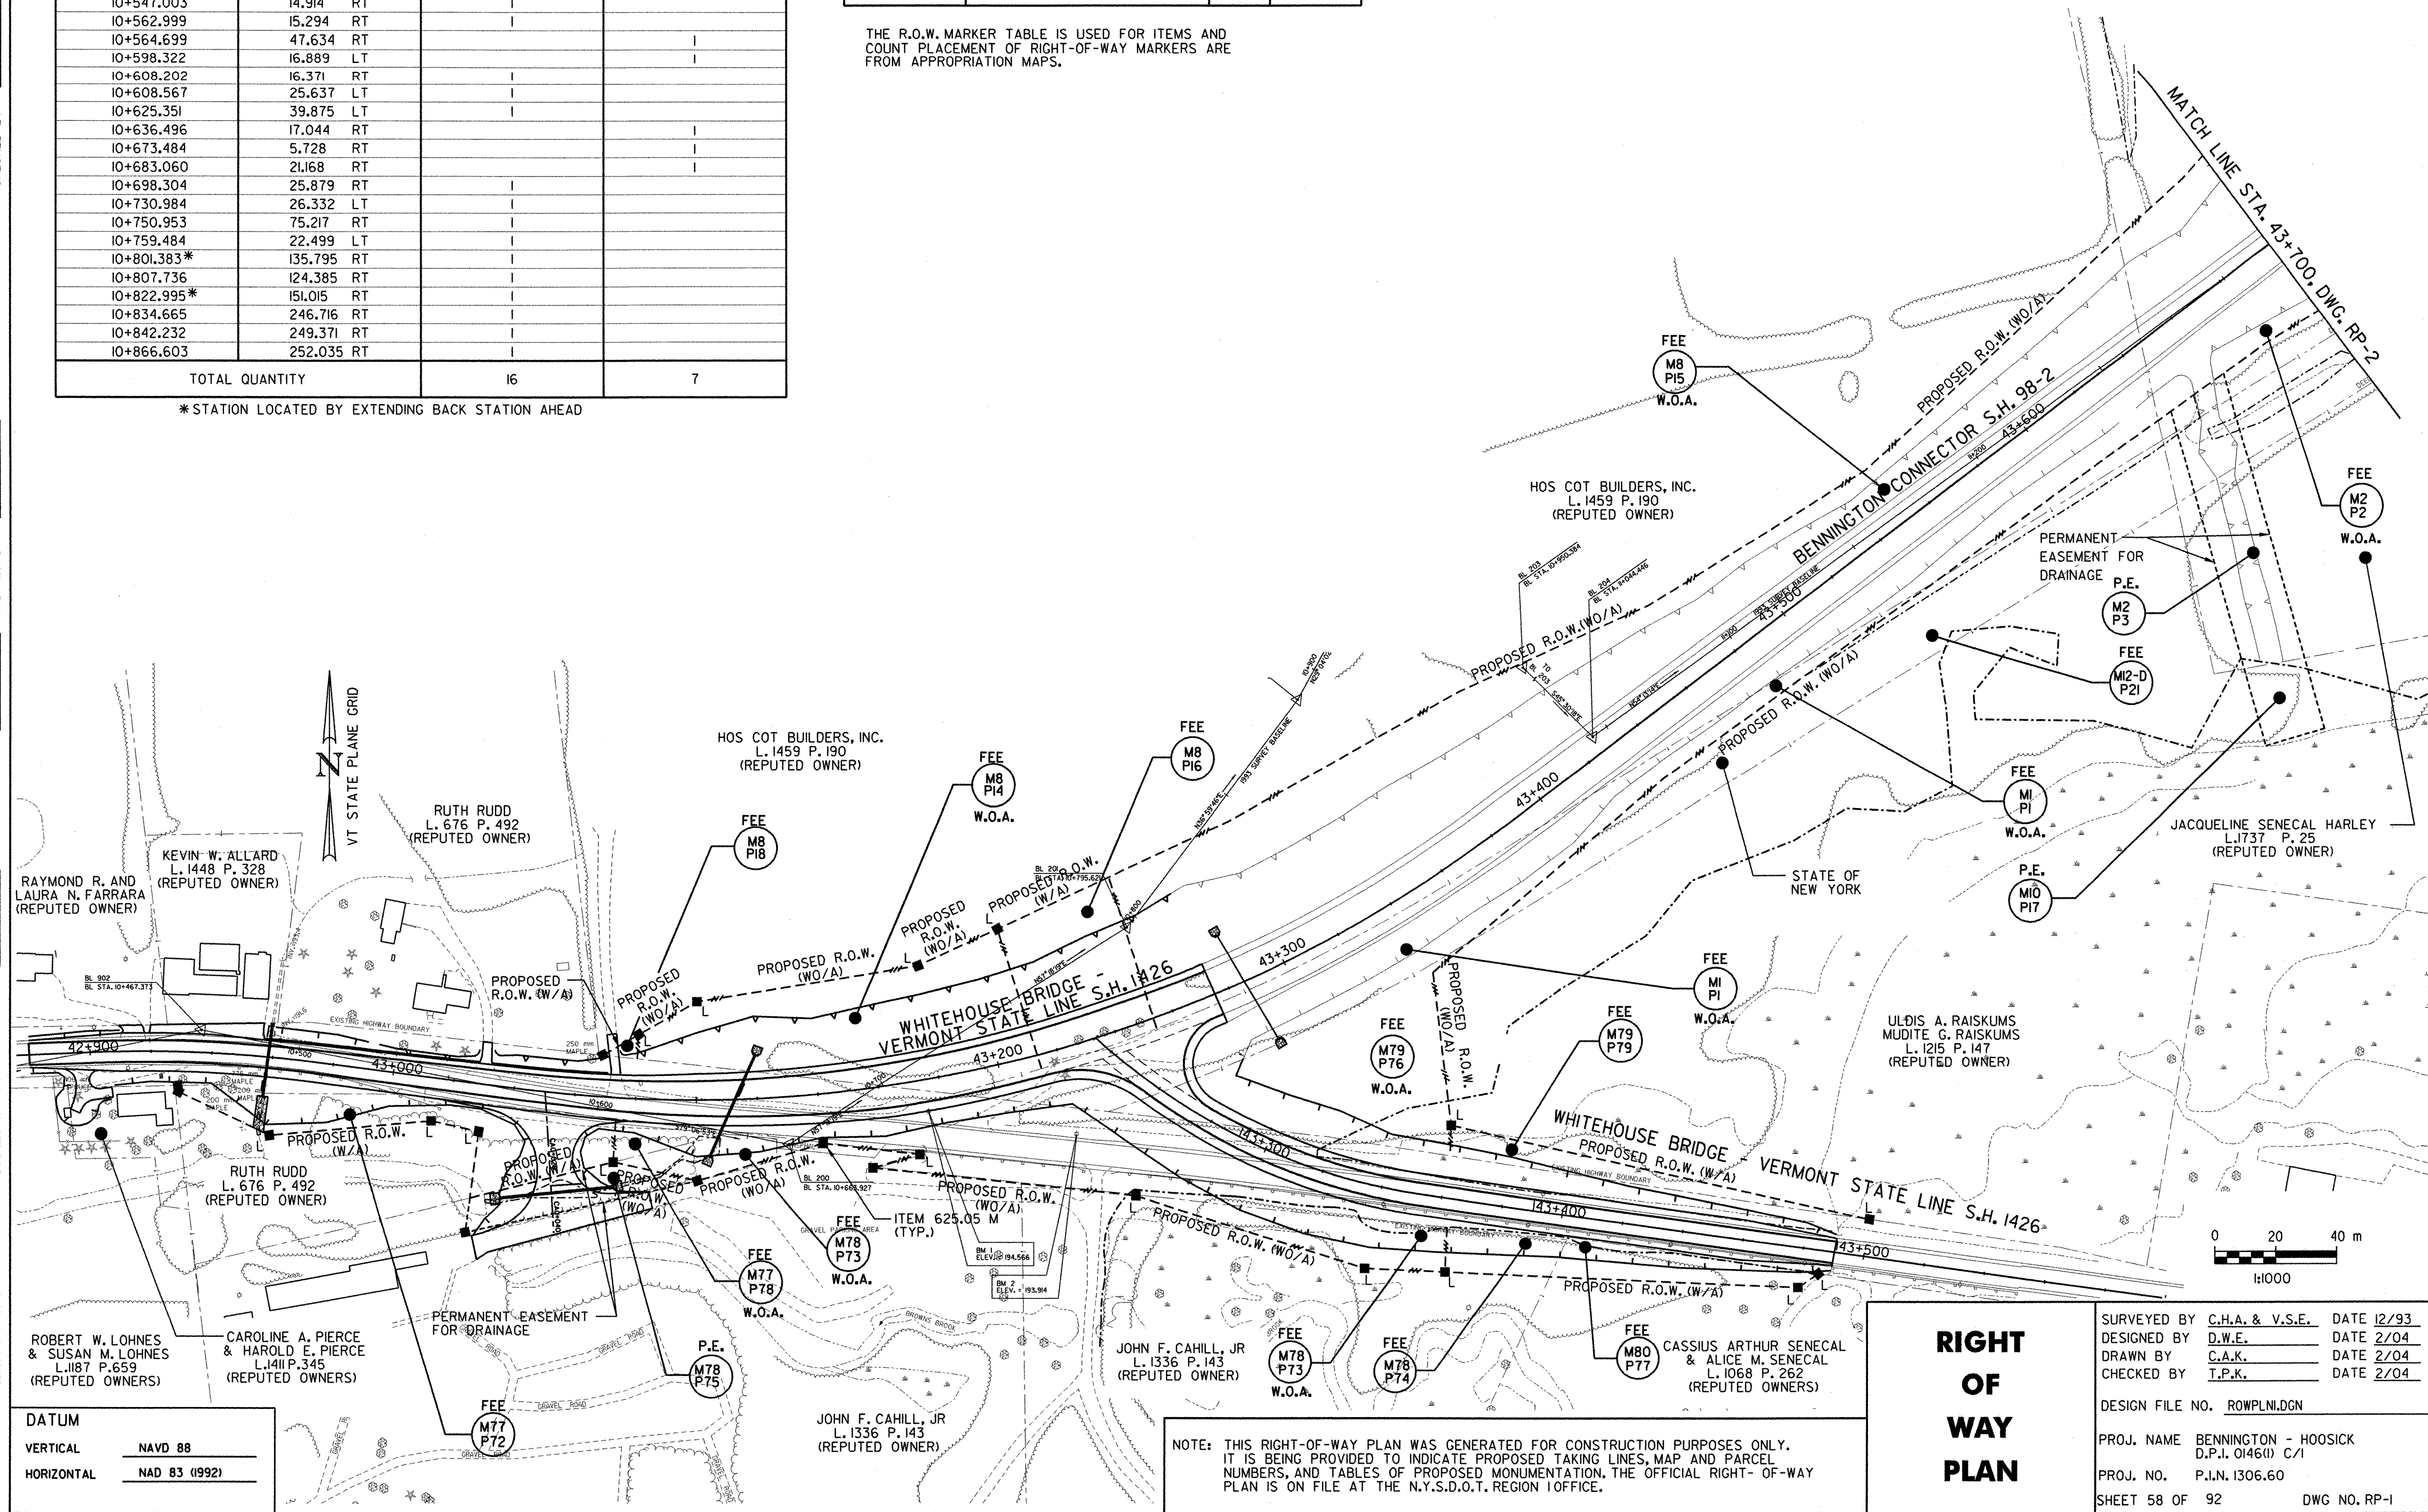

NOTE: THIS RIGHT-OF-WAY PLAN WAS GENERATED FOR CONSTRUCTION PURPOSES ONLY. IT IS BEING PROVIDED TO INDICATE PROPOSED TAKING LINES, MAP AND PARCEL NUMBERS, AND TABLES OF PROPOSED MONUMENTATION. THE OFFICIAL RIGHT-OF-WAY PLAN IS ON FILE AT THE N.Y.S.D.O.T. REGION 1 OFFICE.

RIGHT OF WAY PLAN

SURVEYED BY	C.H.A. & V.S.E.	DATE	12/93
DESIGNED BY	D.W.E.	DATE	2/04
DRAWN BY	C.A.K.	DATE	2/04
CHECKED BY	T.P.K.	DATE	2/04
DESIGN FILE NO. ROWPLN.DGN			
PROJ. NAME BENNINGTON - HOOSICK D.P.I. 0146(1) C/1			
PROJ. NO. P.J.N. 1306.60			
SHEET 58 OF 92 DWG NO. RP-1			