


FED. ROAD REG. NO.	STATE	FEDERAL AID PROJECT NO.	SHEET NO.	TOTAL SHEETS
I	N.Y.	0146001	64	92
BENNINGTON CONNECTOR S.H. 98-2				
P.I.N. 1306.60				
WHITEHOUSE BRIDGE - VERMONT STATE LINE S.H. 1426				
RENSSELAER COUNTY				

NOTE:
1. SEE DWG'S. STD-1 TO STD-2 FOR SIGN TEXT DATA.

2/04 DATE I. BURTNICK CHECKED BY
 C. KAHLBAUGH CHECKED BY
 D. GOZALKOWSKI DRAFTED BY
 D. EMERICH ESTIMATED BY
 D. GOZALKOWSKI CHECKED BY
 D. EMERICH CHECKED BY
 T. KARIS IN CHARGE OF

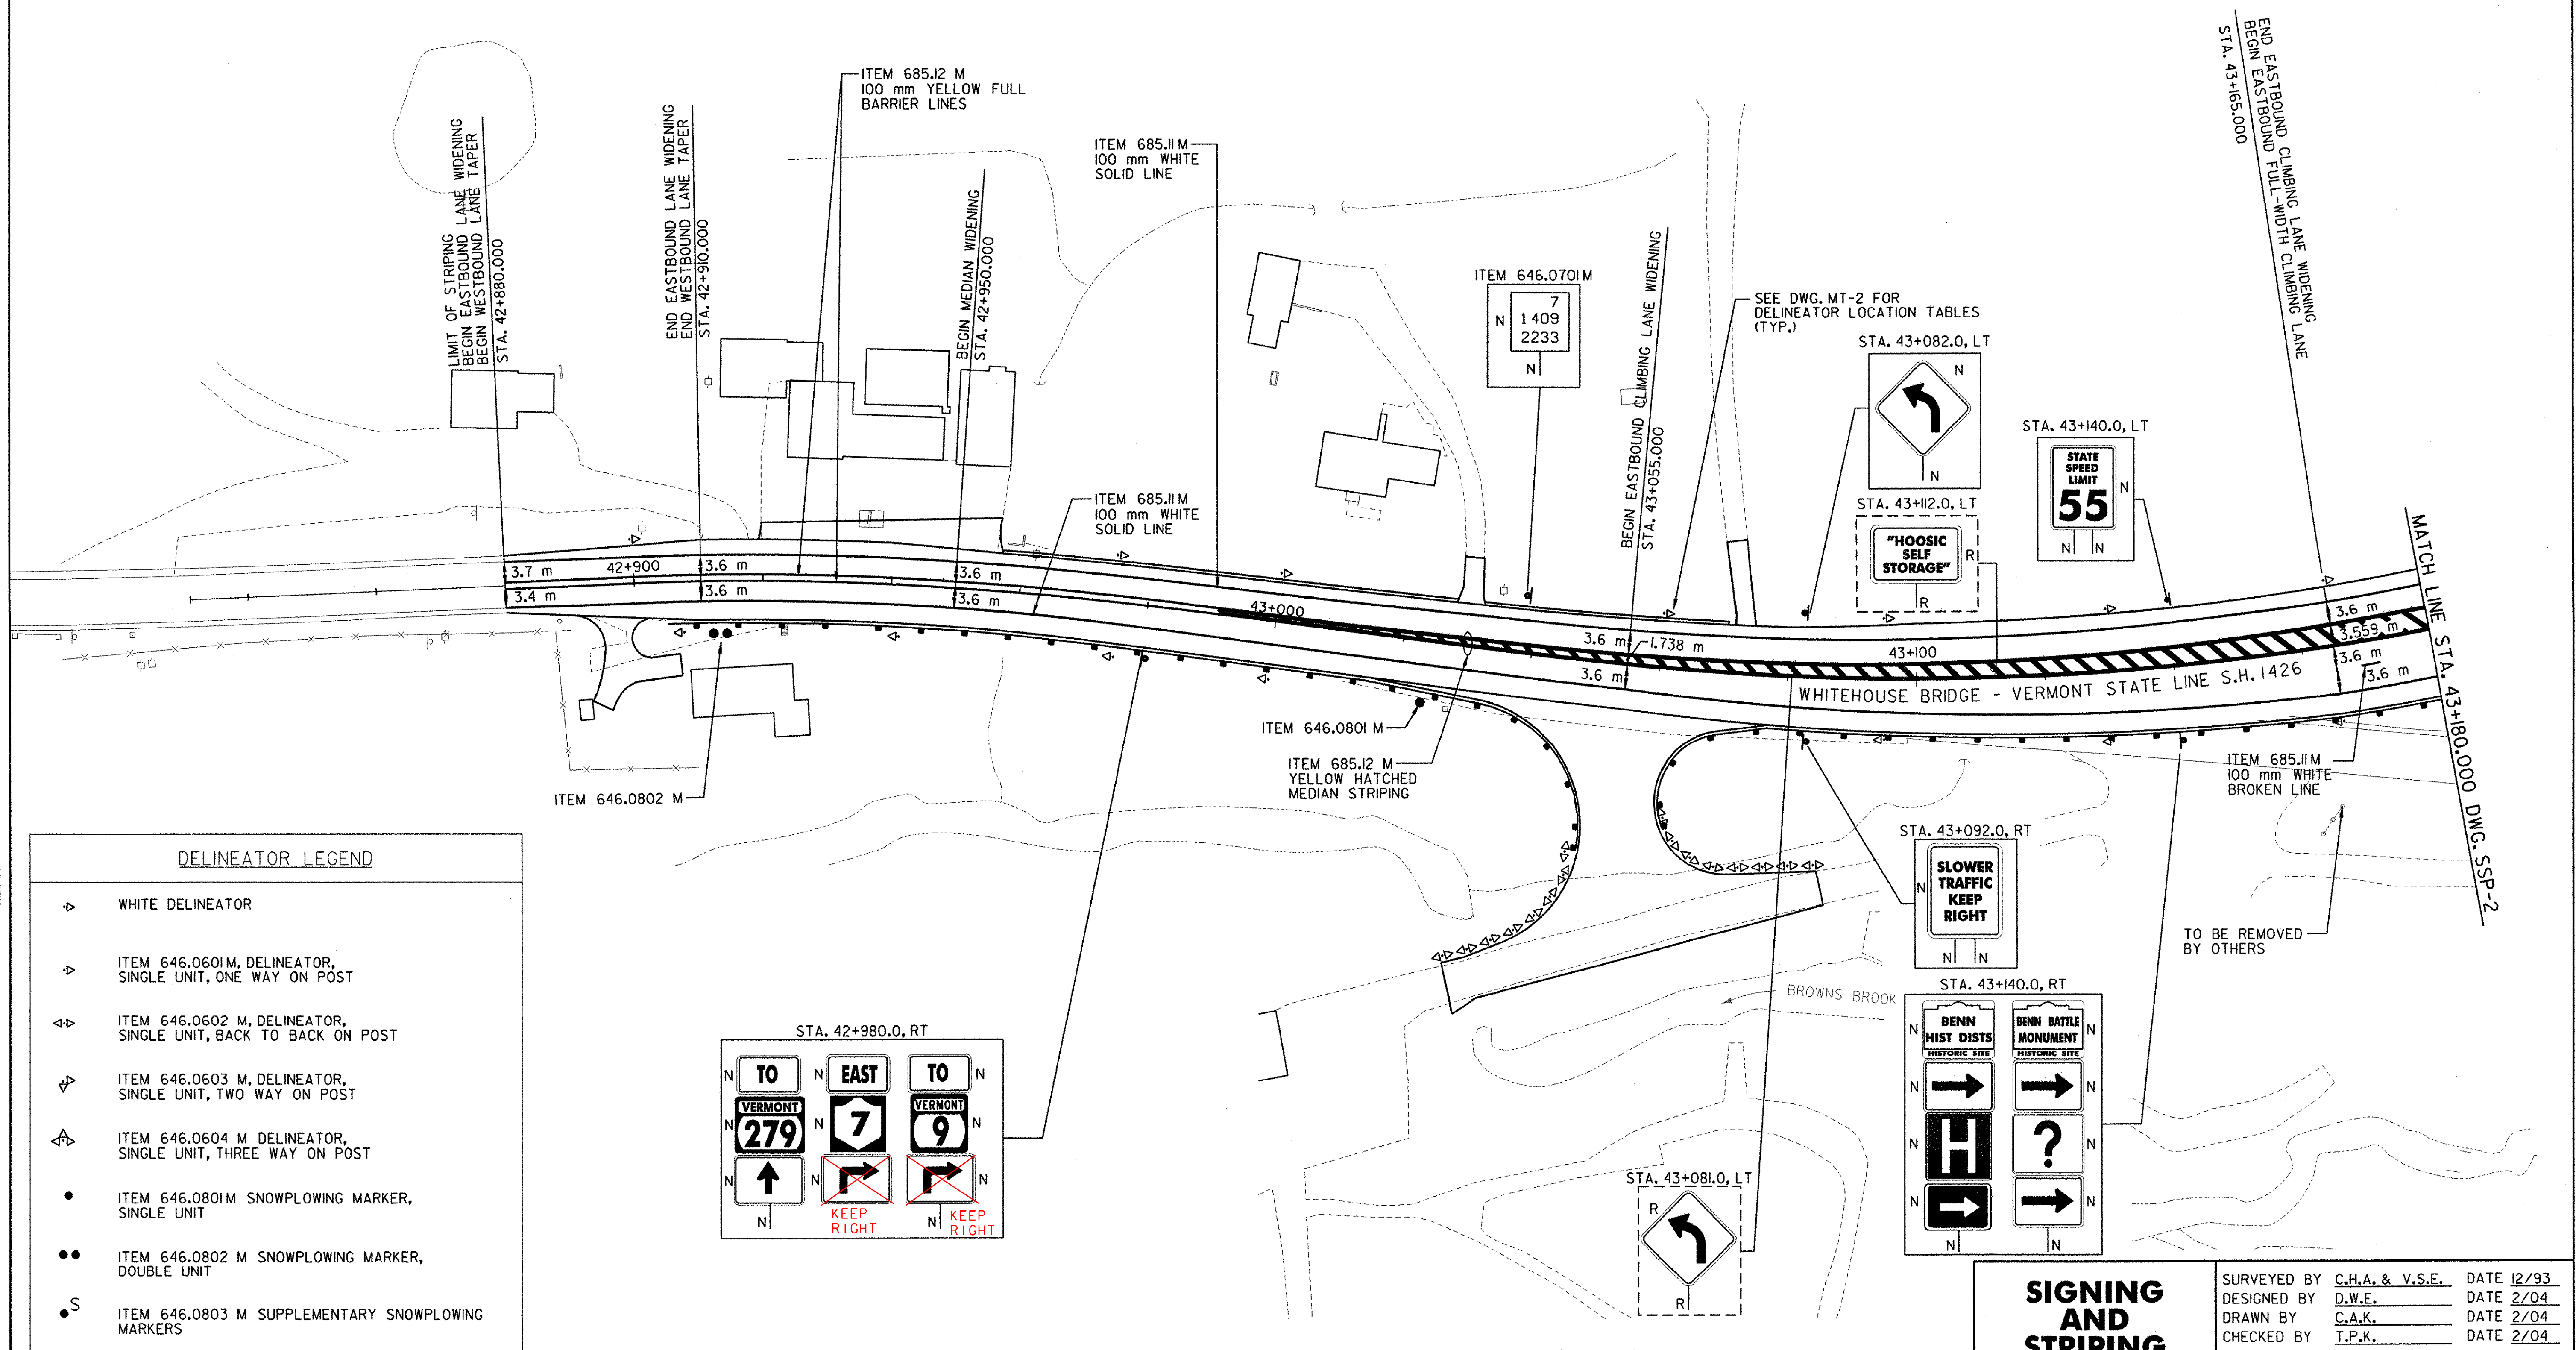


DELINEATOR LEGEND

- ▽ WHITE DELINEATOR
- ▽ ITEM 646.0601M, DELINEATOR, SINGLE UNIT, ONE WAY ON POST
- ▽ ITEM 646.0602 M, DELINEATOR, SINGLE UNIT, BACK TO BACK ON POST
- ▽ ITEM 646.0603 M, DELINEATOR, SINGLE UNIT, TWO WAY ON POST
- ▽ ITEM 646.0604 M DELINEATOR, SINGLE UNIT, THREE WAY ON POST
- ITEM 646.0801M SNOWPLOWING MARKER, SINGLE UNIT
- ITEM 646.0802 M SNOWPLOWING MARKER, DOUBLE UNIT
- S ITEM 646.0803 M SUPPLEMENTARY SNOWPLOWING MARKERS

SIGN LEGEND

- R = REMOVE
- S = SALVAGE
- N = NEW
- RET = RETAIN
- B-B = BACK TO BACK
- EXISTING =
- NEW =

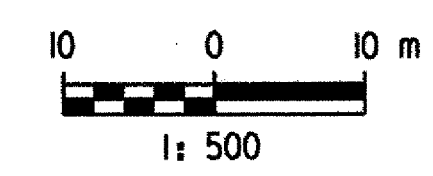

SIGNING AND STRIPING PLAN
STA. 42 + 880 TO STA. 43 + 180

SURVEYED BY C.H.A. & V.S.E. DATE 12/93
 DESIGNED BY D.W.E. DATE 2/04
 DRAWN BY C.A.K. DATE 2/04
 CHECKED BY T.P.K. DATE 2/04
 DESIGN FILE NO. NYSSPLDGN
 PROJ. NAME BENNINGTON - HOOSIC D.P.I. 0146(I) C/1
 PROJ. NO. P.I.N. 1306.60
 SHEET 64 OF 92 DWG NO. SSP-1

FILE NAME = \\S:\SIS\mgs\dot\contract\mgs\sspl.dgn
 DATE/TIME = 2/23/2004
 USER = 2225

DATUM

VERTICAL	NAVD 88
HORIZONTAL	NAD 83 (1992)