

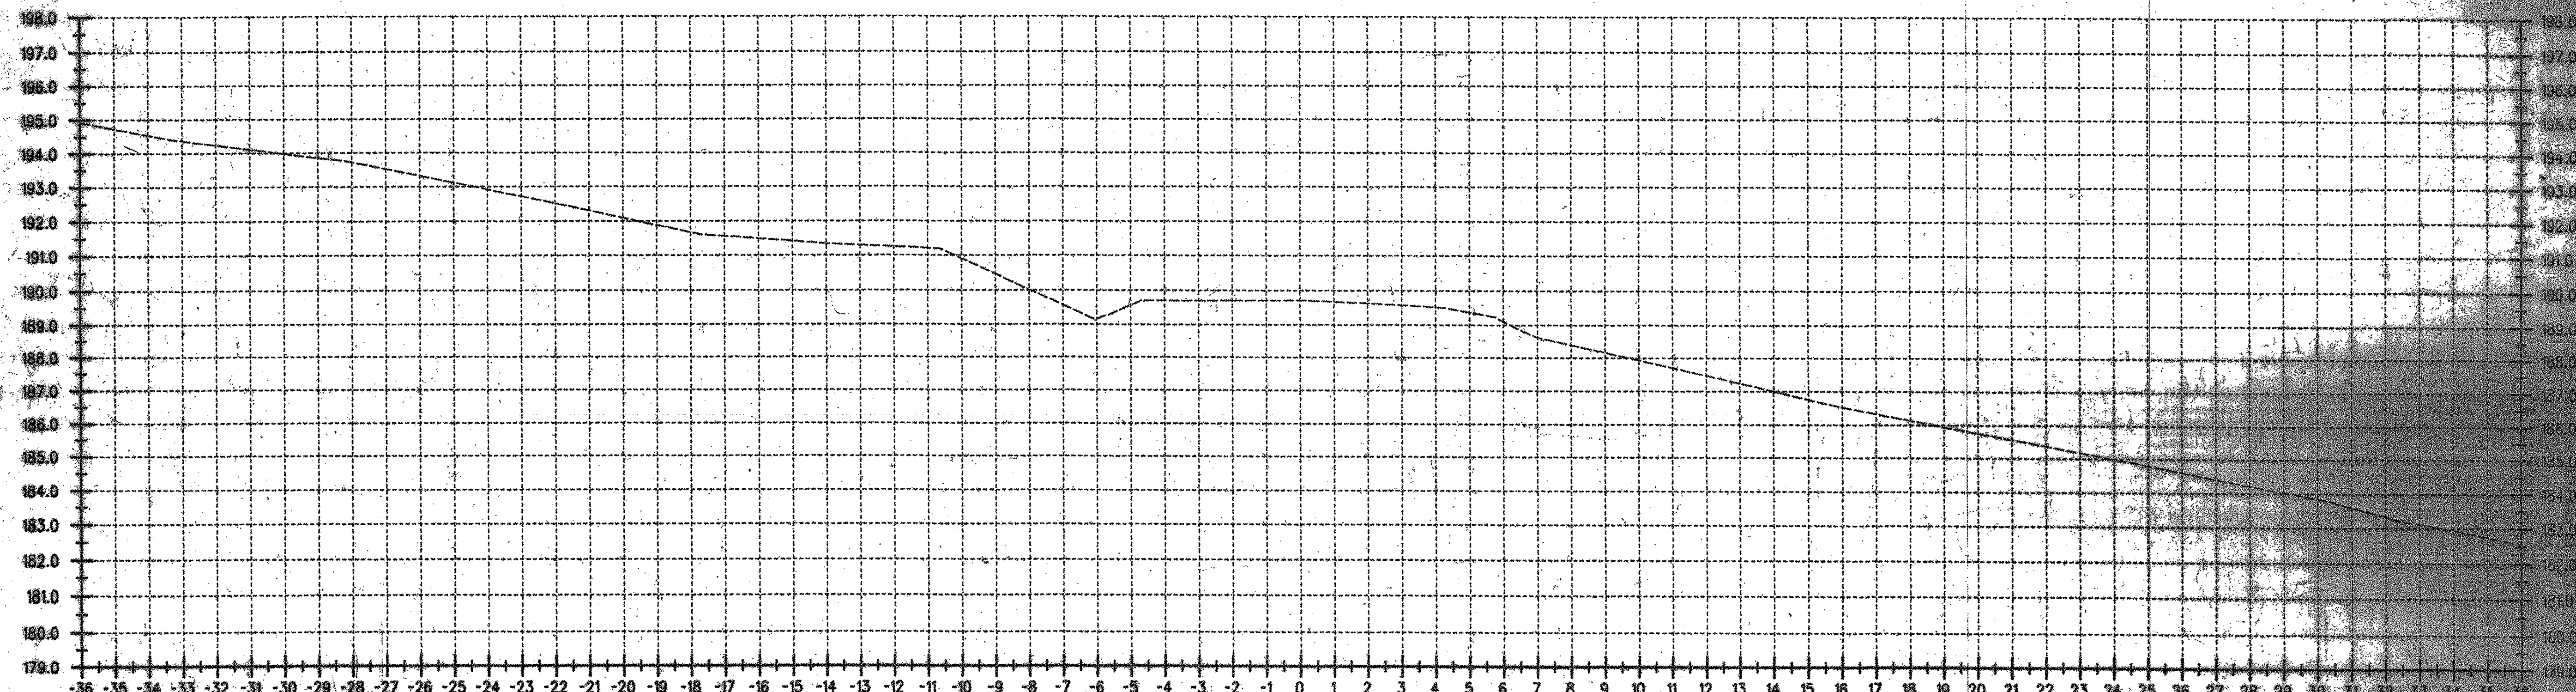


42+860

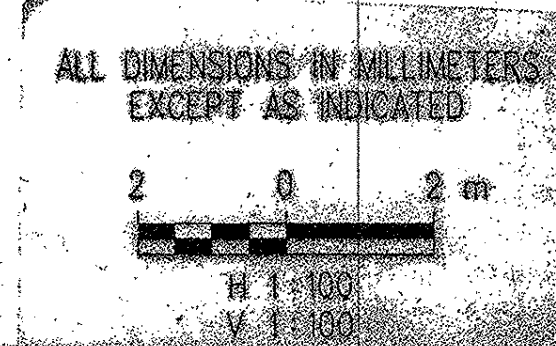

42+840

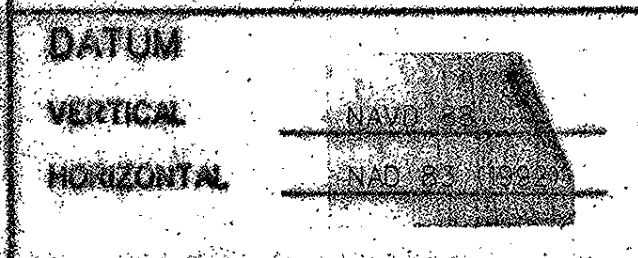

SURVEYED BY C.H.A. & V.S.E. DATE  
 DRAWN BY J.S.L. DATE  
 SQUAD LEADER T.P.K.  
 DESIGN FILE NO. N/A  
 PARM FILE DATE PLOTTED  
 PROJ. NAME BENNINGTON - HOOSICK  
 D.P.I. 0145(D)  
 PROJ. NO. P.L.N. 1306.00.201  
 SHEET 72 OF 92 SHEETS