



h

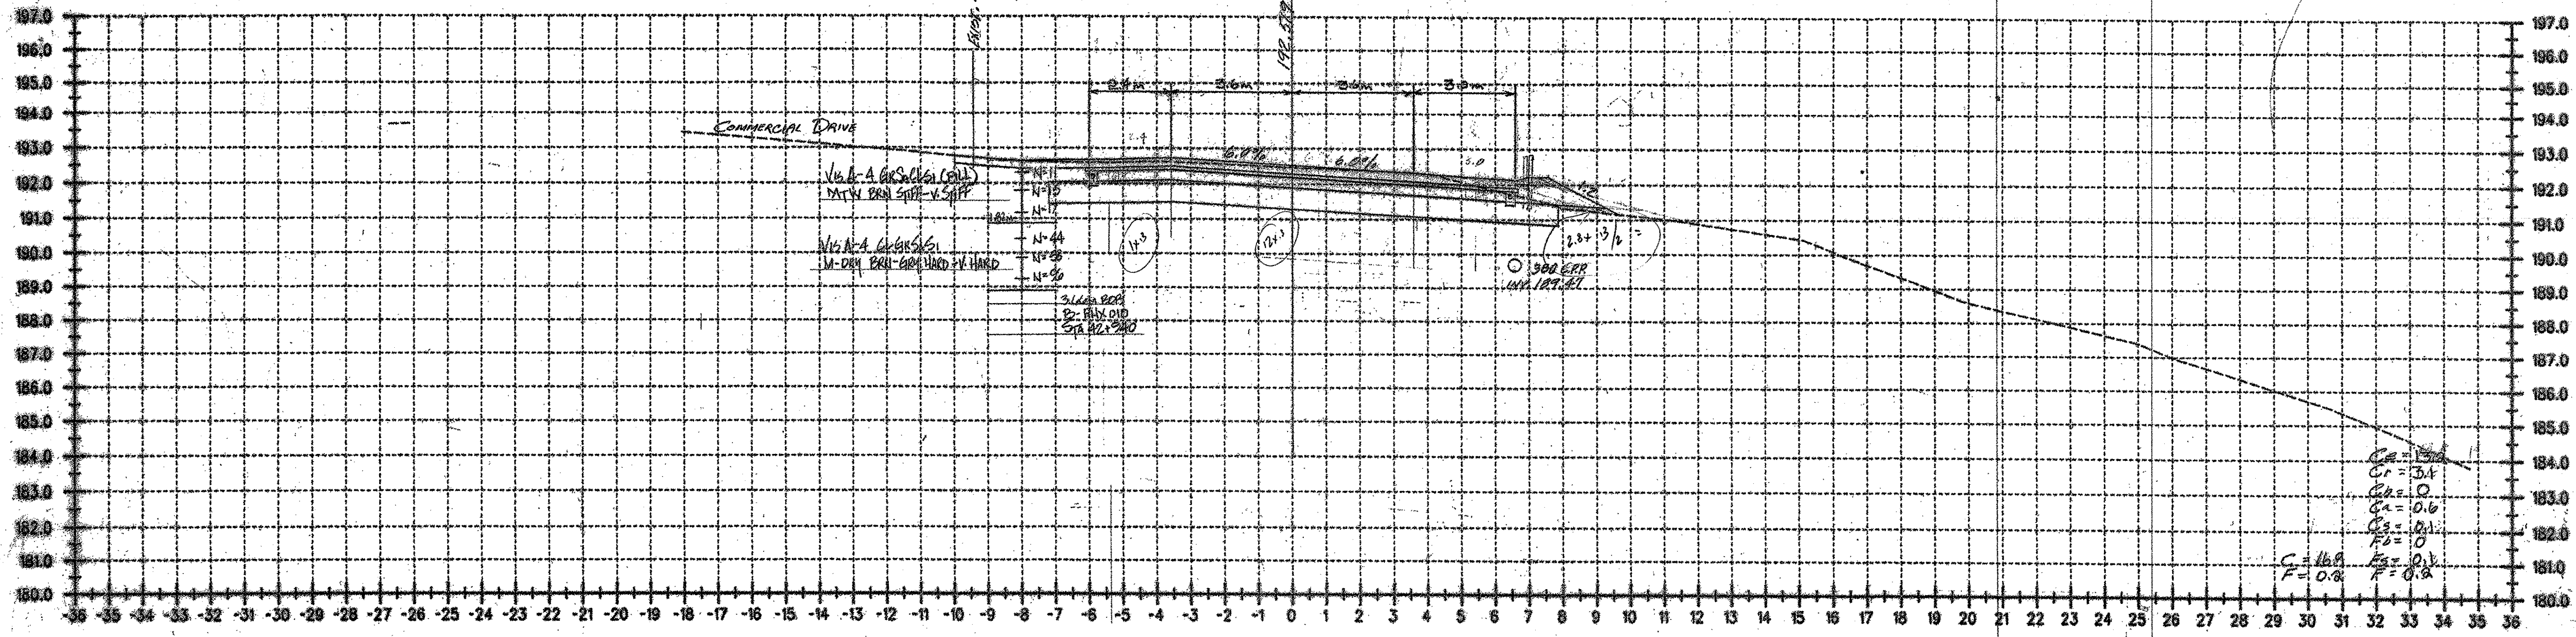

42+940

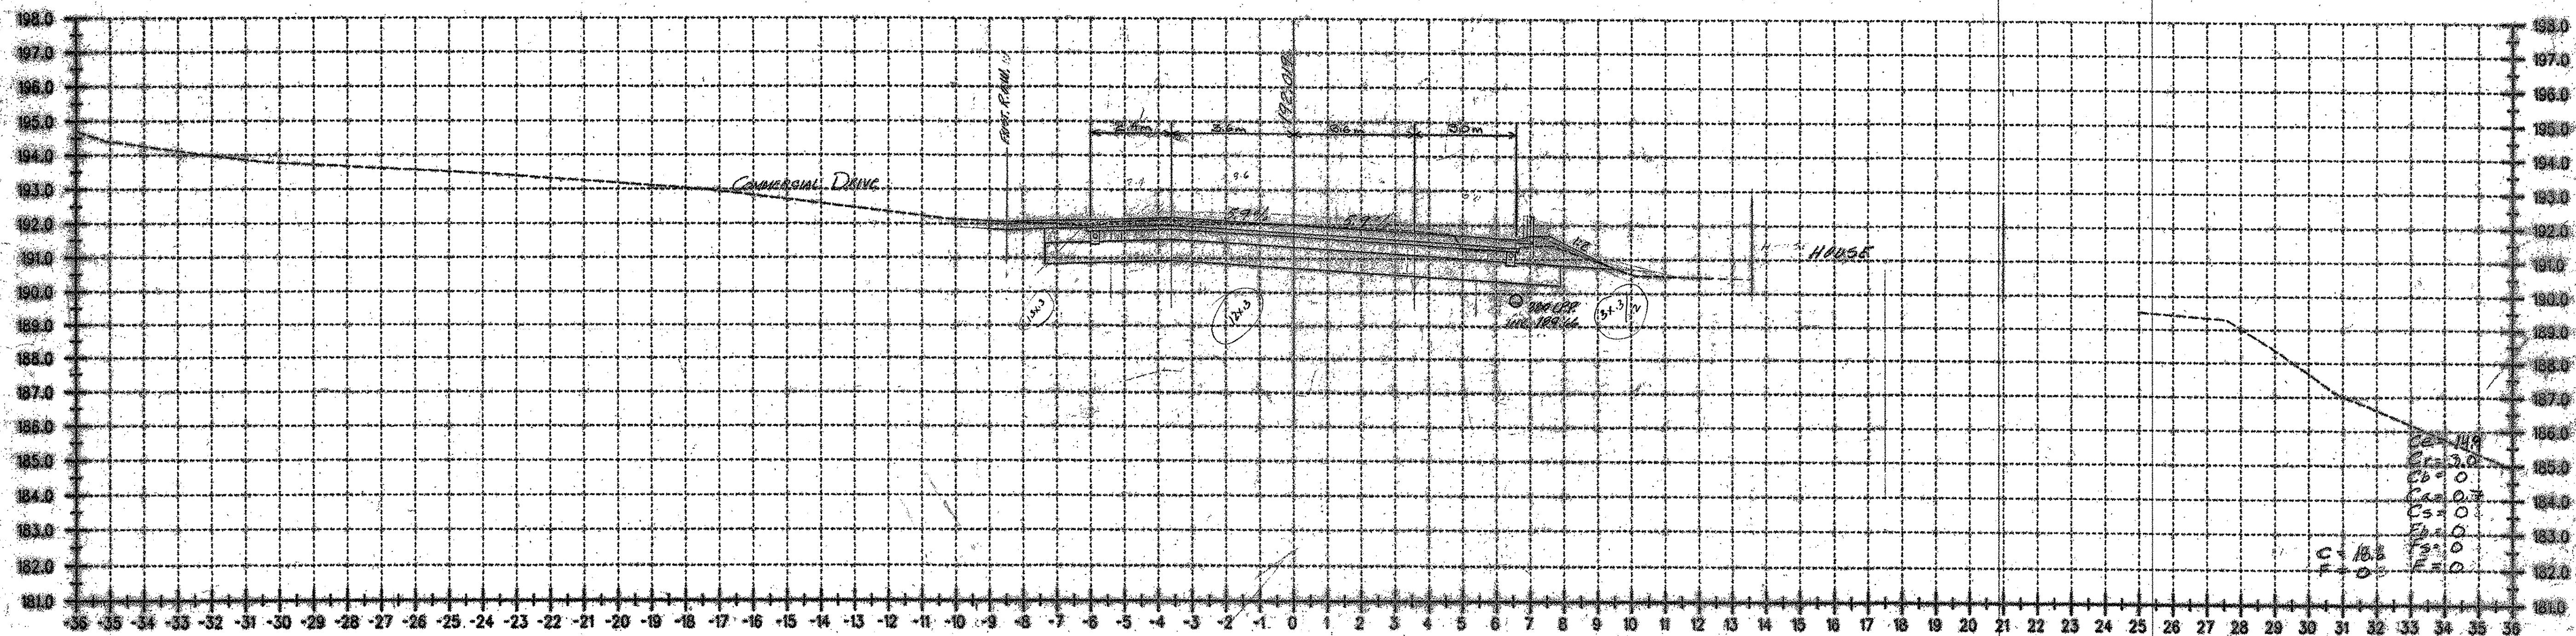

42+920

DATUM
 VERTICAL NAVD 83
 HORIZONTAL NAD 83 (1992)

ALL DIMENSIONS IN MILLIMETERS EXCEPT AS INDICATED

SURVEYED BY C.H.A. & V.S.E. DATE 12/18/02
 DRAWN BY J.S.L. DATE 11/02
 SQUAD LEADER T.P.K.
 DESIGN FILE NO: N/A
 PARM FILE DATE PLOTTED
 PROJ. NAME BENNINGTON - HOOSICK
 D.P.J. 014610
 PROJ. NO. P.L.N. 1308.60.201
 SHEET 74 OF 92 SHEETS