



43+220

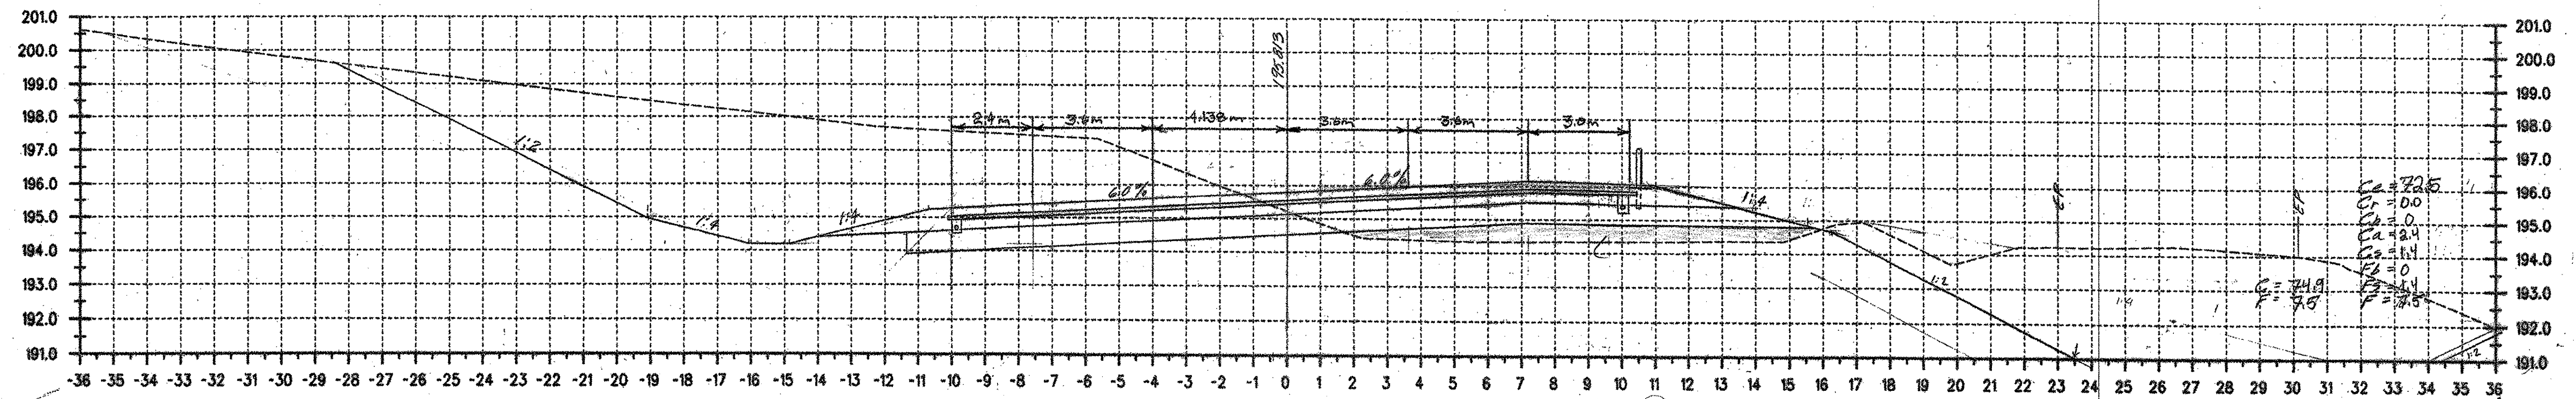

43+200

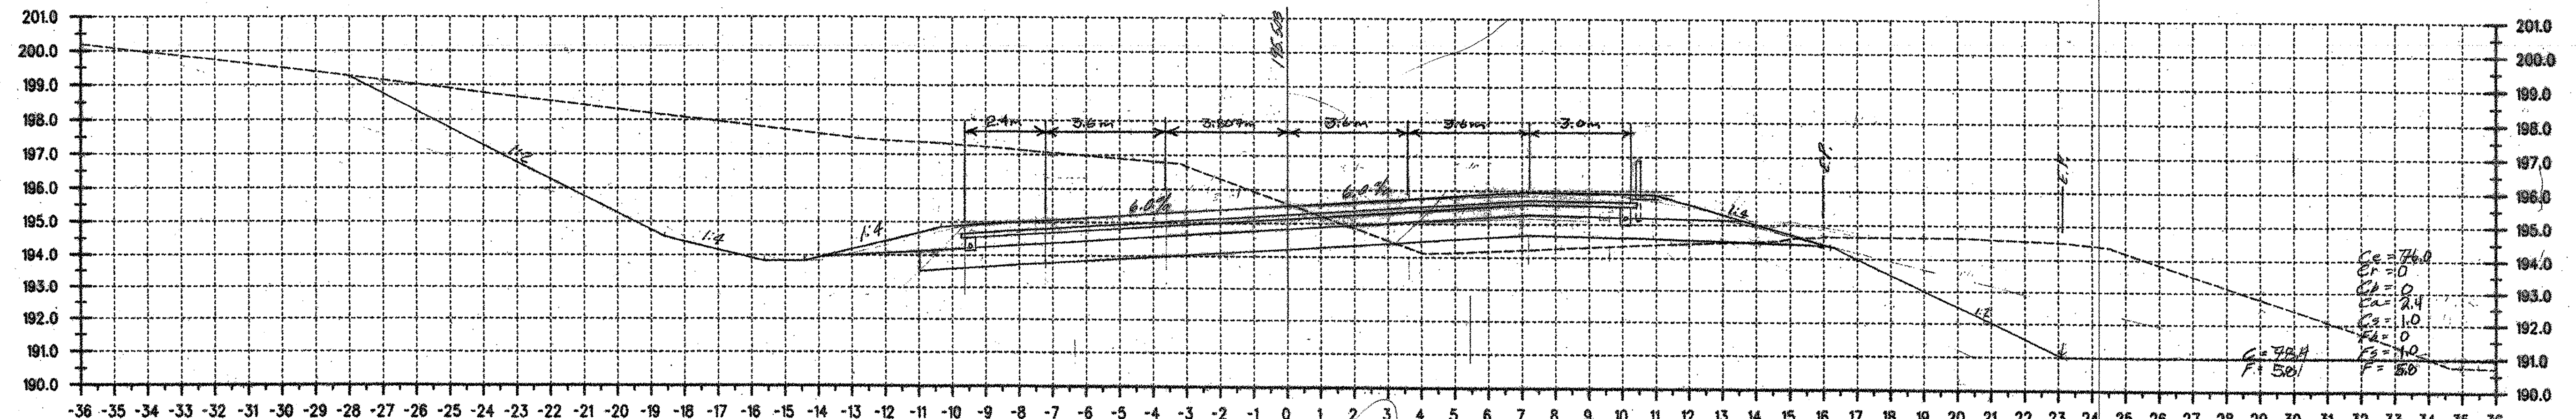

43+180

DATUM
 VERTICAL NAVD 88
 HORIZONTAL NAD 83 (1992)

ALL DIMENSIONS IN MILLIMETERS
 EXCEPT AS INDICATED
 2 0 2 m
 H: 1:100
 V: 1:100

SURVEYED BY C.H.A. & V.S.E. DATE 12/93
 DRAWN BY J.S.L. DATE 11/93
 SQUAD LEADER T.P.K.
 DESIGN FILE NO. n/a
 FILE _____ DATE PLOTTED _____
 PROJ. NAME BENNINGTON - HOOSICK
 D.P.I. 0146(1)
 PROJ. NO. P.I.N. 1306.60.201
 SHEET 80 OF 92 SHEETS