



*Handwritten notes:*  
 11/15/03  
 P.S. 15/11/03  
 (unclear)

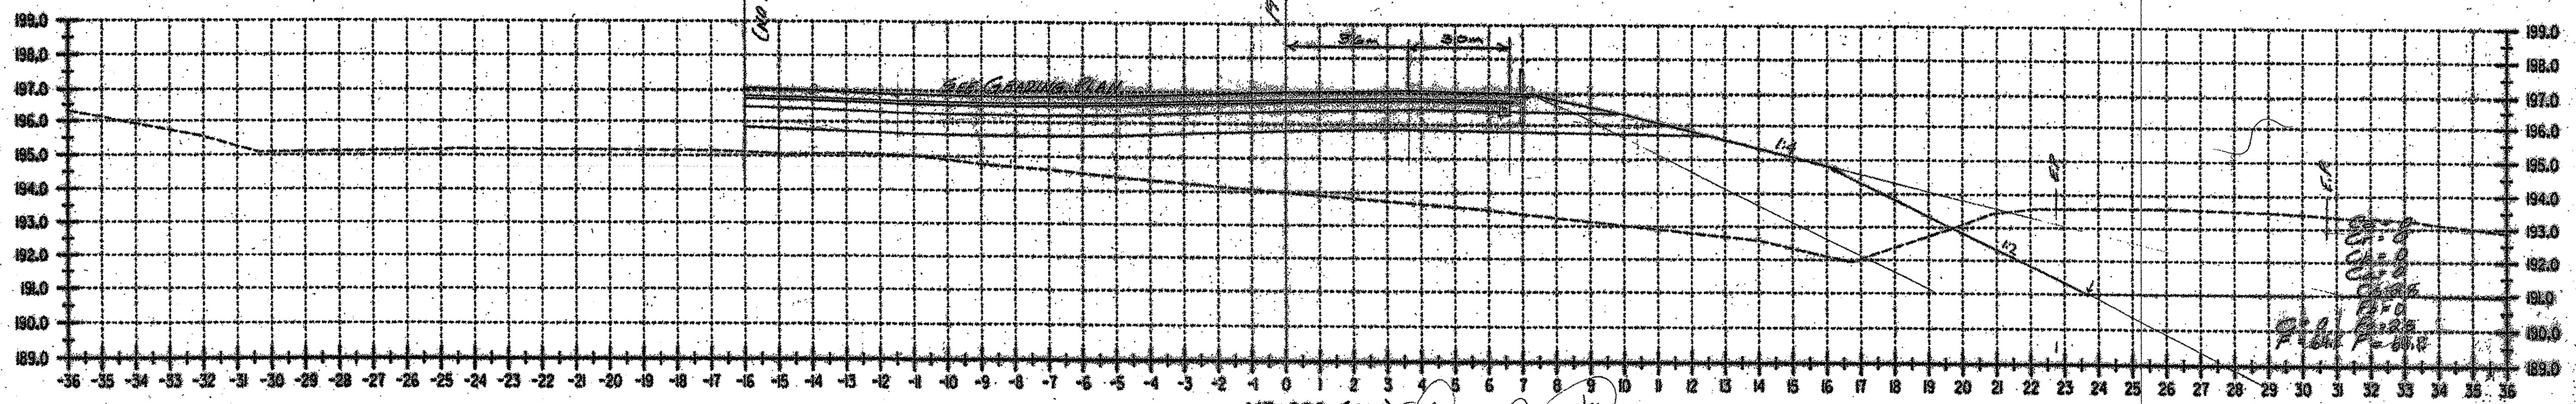

*Handwritten notes:*  
 2.3/13  
 4.66  
 7.65  
 3.5e-11/2  
 11

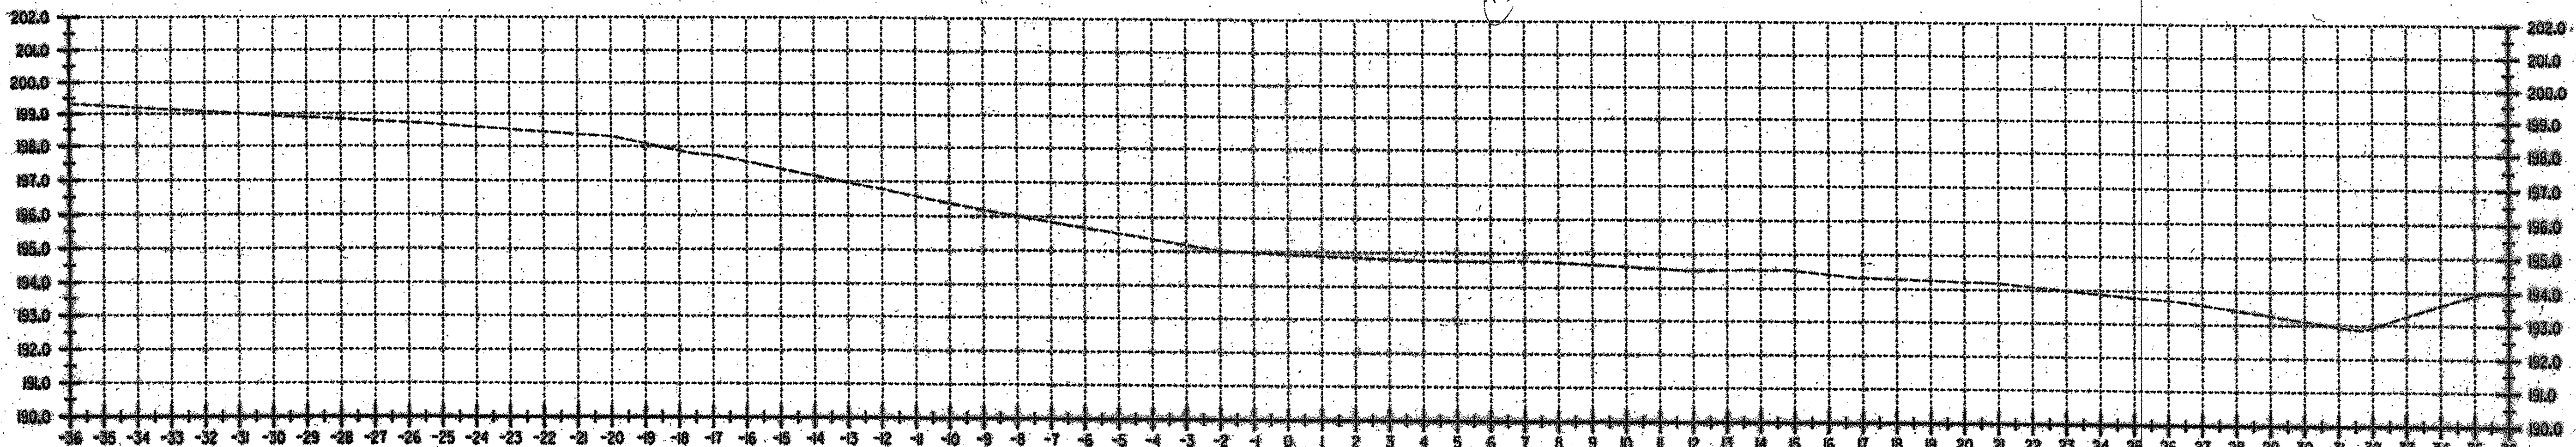

DATUM  
 VERTICAL NAD 88  
 HORIZONTAL NAD 83 09921

ALL DIMENSIONS IN MILLIMETERS  
 EXCEPT AS INDICATED  
 2 0 2 m  
 H: 1:100  
 V: 1:100

SURVEYED BY CHA. & V.S.E. DATE 10/03  
 DRAWN BY J.S.L. DATE 11/03  
 SQUAD LEADER J.F.K.  
 DESIGN FILE NO. 152A  
 PARM FILE \_\_\_\_\_ DATE PLOTTED \_\_\_\_\_  
 PROJ. NAME BENNINGTON HOOSICK  
D.P. 0460  
 PROJ. NO. P.N. 1306.GC.D  
 SHEET 52 OF 90 SHEETS