


MATCH LINE ROW SHEET 43

MATCH LINE ROW SHEET 45

THIS SHEET TO BE USED
FOR RIGHT-OF-WAY
INFORMATION ONLY

LINES SHOWN ON THIS PLAN AS EXISTING
PROPERTY LINES P/L ARE BELIEVED TO
BE ACCURATE BUT SHOULD NOT BE RELIED
UPON FOR PURPOSES UNRELATED TO THE
STATE OF VERMONT'S ACQUISITION OF LAND
AND RIGHTS FOR THIS PROJECT.

DATUM
VERTICAL NAVD 88
HORIZONTAL NAD 83 (1992)

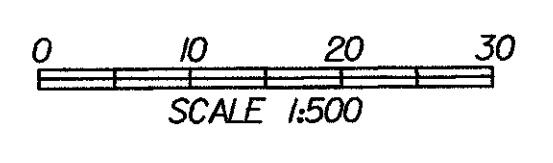

PROJECT: BENNINGTON - HOOSICK	PROJECT NO. : D.P.I. 0146 (1)
DESIGN FILE NAME: IPARM FILE NAME: SURVEYED BY: SQUAD LEADER: DHH DWG. NO. ROW-44	PLOT DATE: SURVEY DATE: DRAWN BY: VSE SHEET: 30 OF 473