


THIS SHEET TO BE USED FOR RIGHT-OF-WAY INFORMATION ONLY

DATUM
 VERTICAL NAVD 88
 HORIZONTAL NAD 83 (1992)

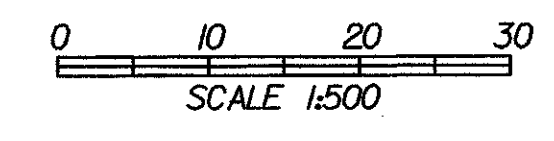

PROJECT: BENNINGTON - HOOSICK	PROJECT NO.: D.P.I. 0146 (1)
DESIGN FILE NAME: IPARM FILE NAME: SURVEYED BY: SQUAD LEADER: DHH DWG. NO. ROW-45	PLOT DATE: SURVEY DATE: DRAWN BY: VSE SHEET: 31 OF 473