



MATCH LINE ROW SHEET 49

MATCH LINE ROW SHEET 51

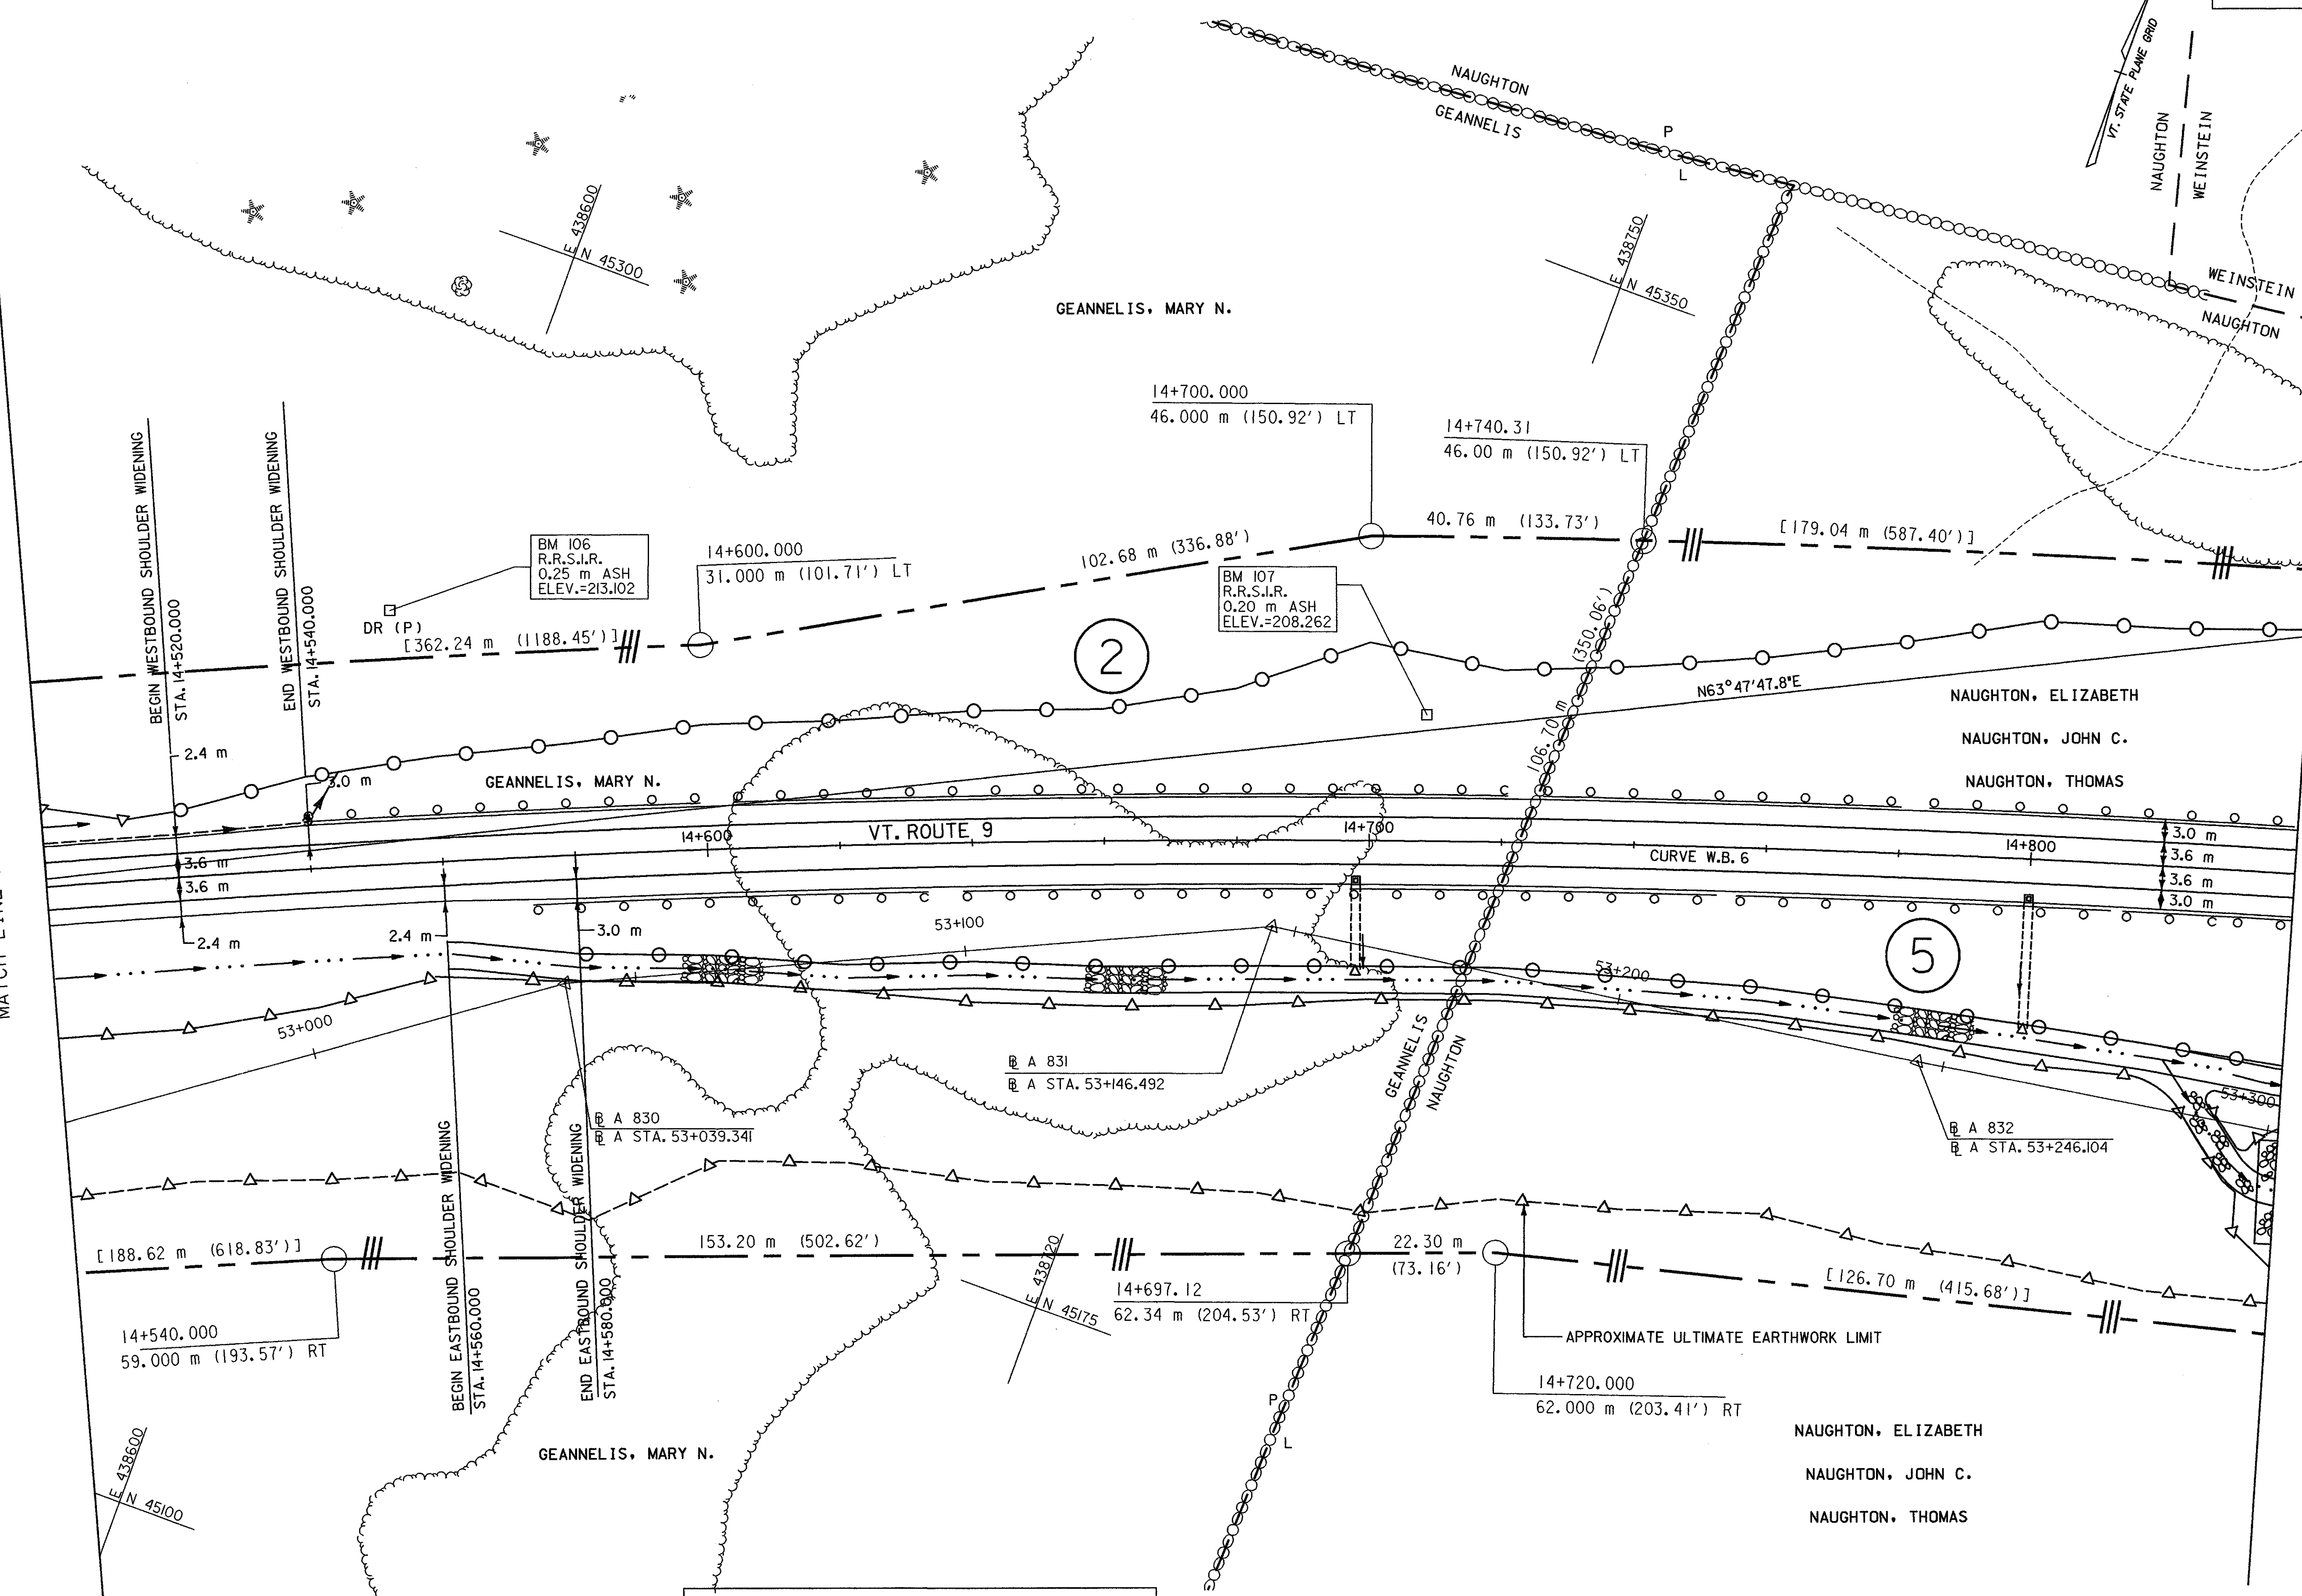

LINES SHOWN ON THIS PLAN AS EXISTING PROPERTY LINES P/L ARE BELIEVED TO BE ACCURATE BUT SHOULD NOT BE RELIED UPON FOR PURPOSES UNRELATED TO THE STATE OF VERMONT'S ACQUISITION OF LAND AND RIGHTS FOR THIS PROJECT.

THIS SHEET TO BE USED FOR RIGHT-OF-WAY INFORMATION ONLY

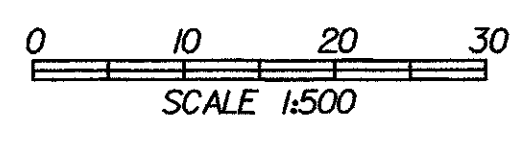

DATUM  
 VERTICAL NAVD 88  
 HORIZONTAL NAD 83 (1992)

PROJECT: BENNINGTON - HOOSICK	PROJECT NO.: D.P.I. 0146 (1)
DESIGN FILE NAME: IPARM FILE NAME: SURVEYED BY: SQUAD LEADER: DHH DWG. NO. ROW-50	PLOT DATE: SURVEY DATE: DRAWN BY: VSE SHEET: 36 OF 473