




ROW SHEET F



WATER AND SEWER SYSTEMS WITHIN AND IMMEDIATELY ADJACENT TO THE PROPOSED ACQUISITION AREAS ARE SHOWN TO THE BEST OF OUR KNOWLEDGE.

BENNINGTON-HOOSICK
D.P.I. 0146(1)

DWG. NO. ROW-C SHEET 45 OF 473
SCALE: 1" = 200' (1" = 60.96 m)

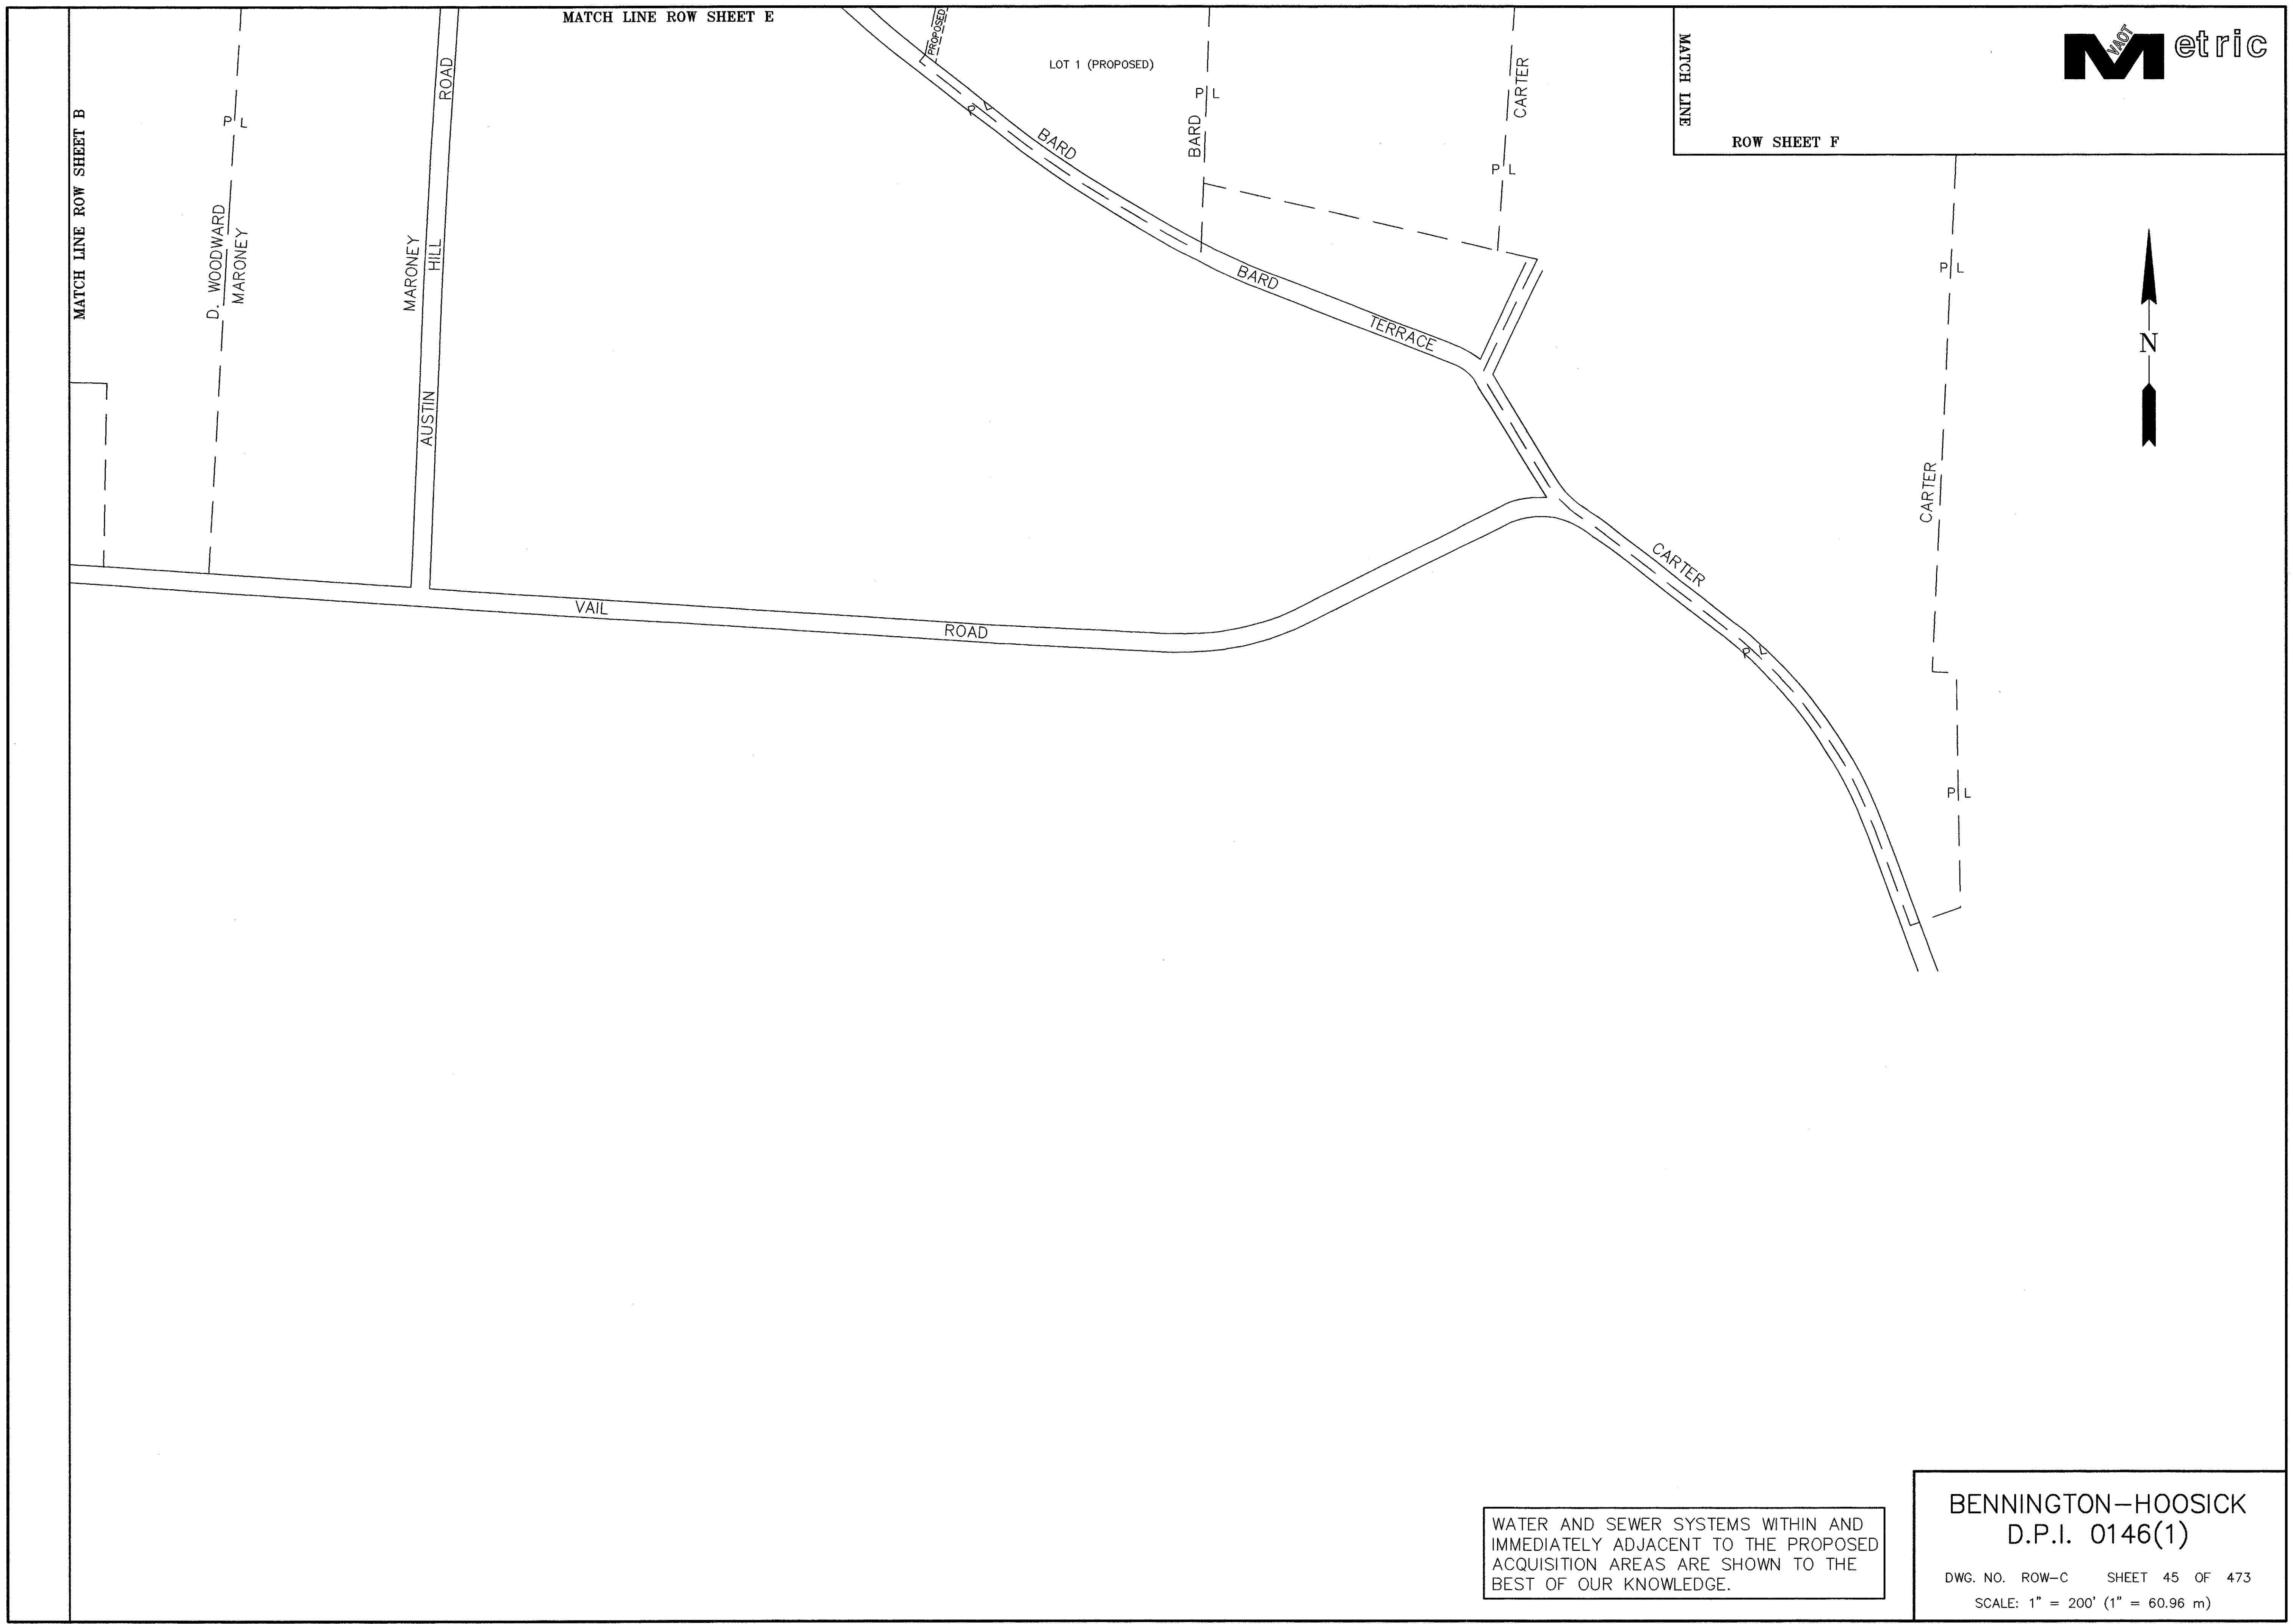

MATCH LINE ROW SHEET E

MATCH LINE ROW SHEET B

D. WOODWARD
MARONEY

MARONEY
HILL
ROAD

AUSTIN

VAIL
ROAD

LOT 1 (PROPOSED)

BARD

BARD

BARD

TERRACE

CARTER

CARTER

CARTER

P.L.

P.L.

PROPOSED