




STATE OF NEW YORK - TOWN OF HOOSICK
STATE OF VERMONT - TOWN OF BENNINGTON

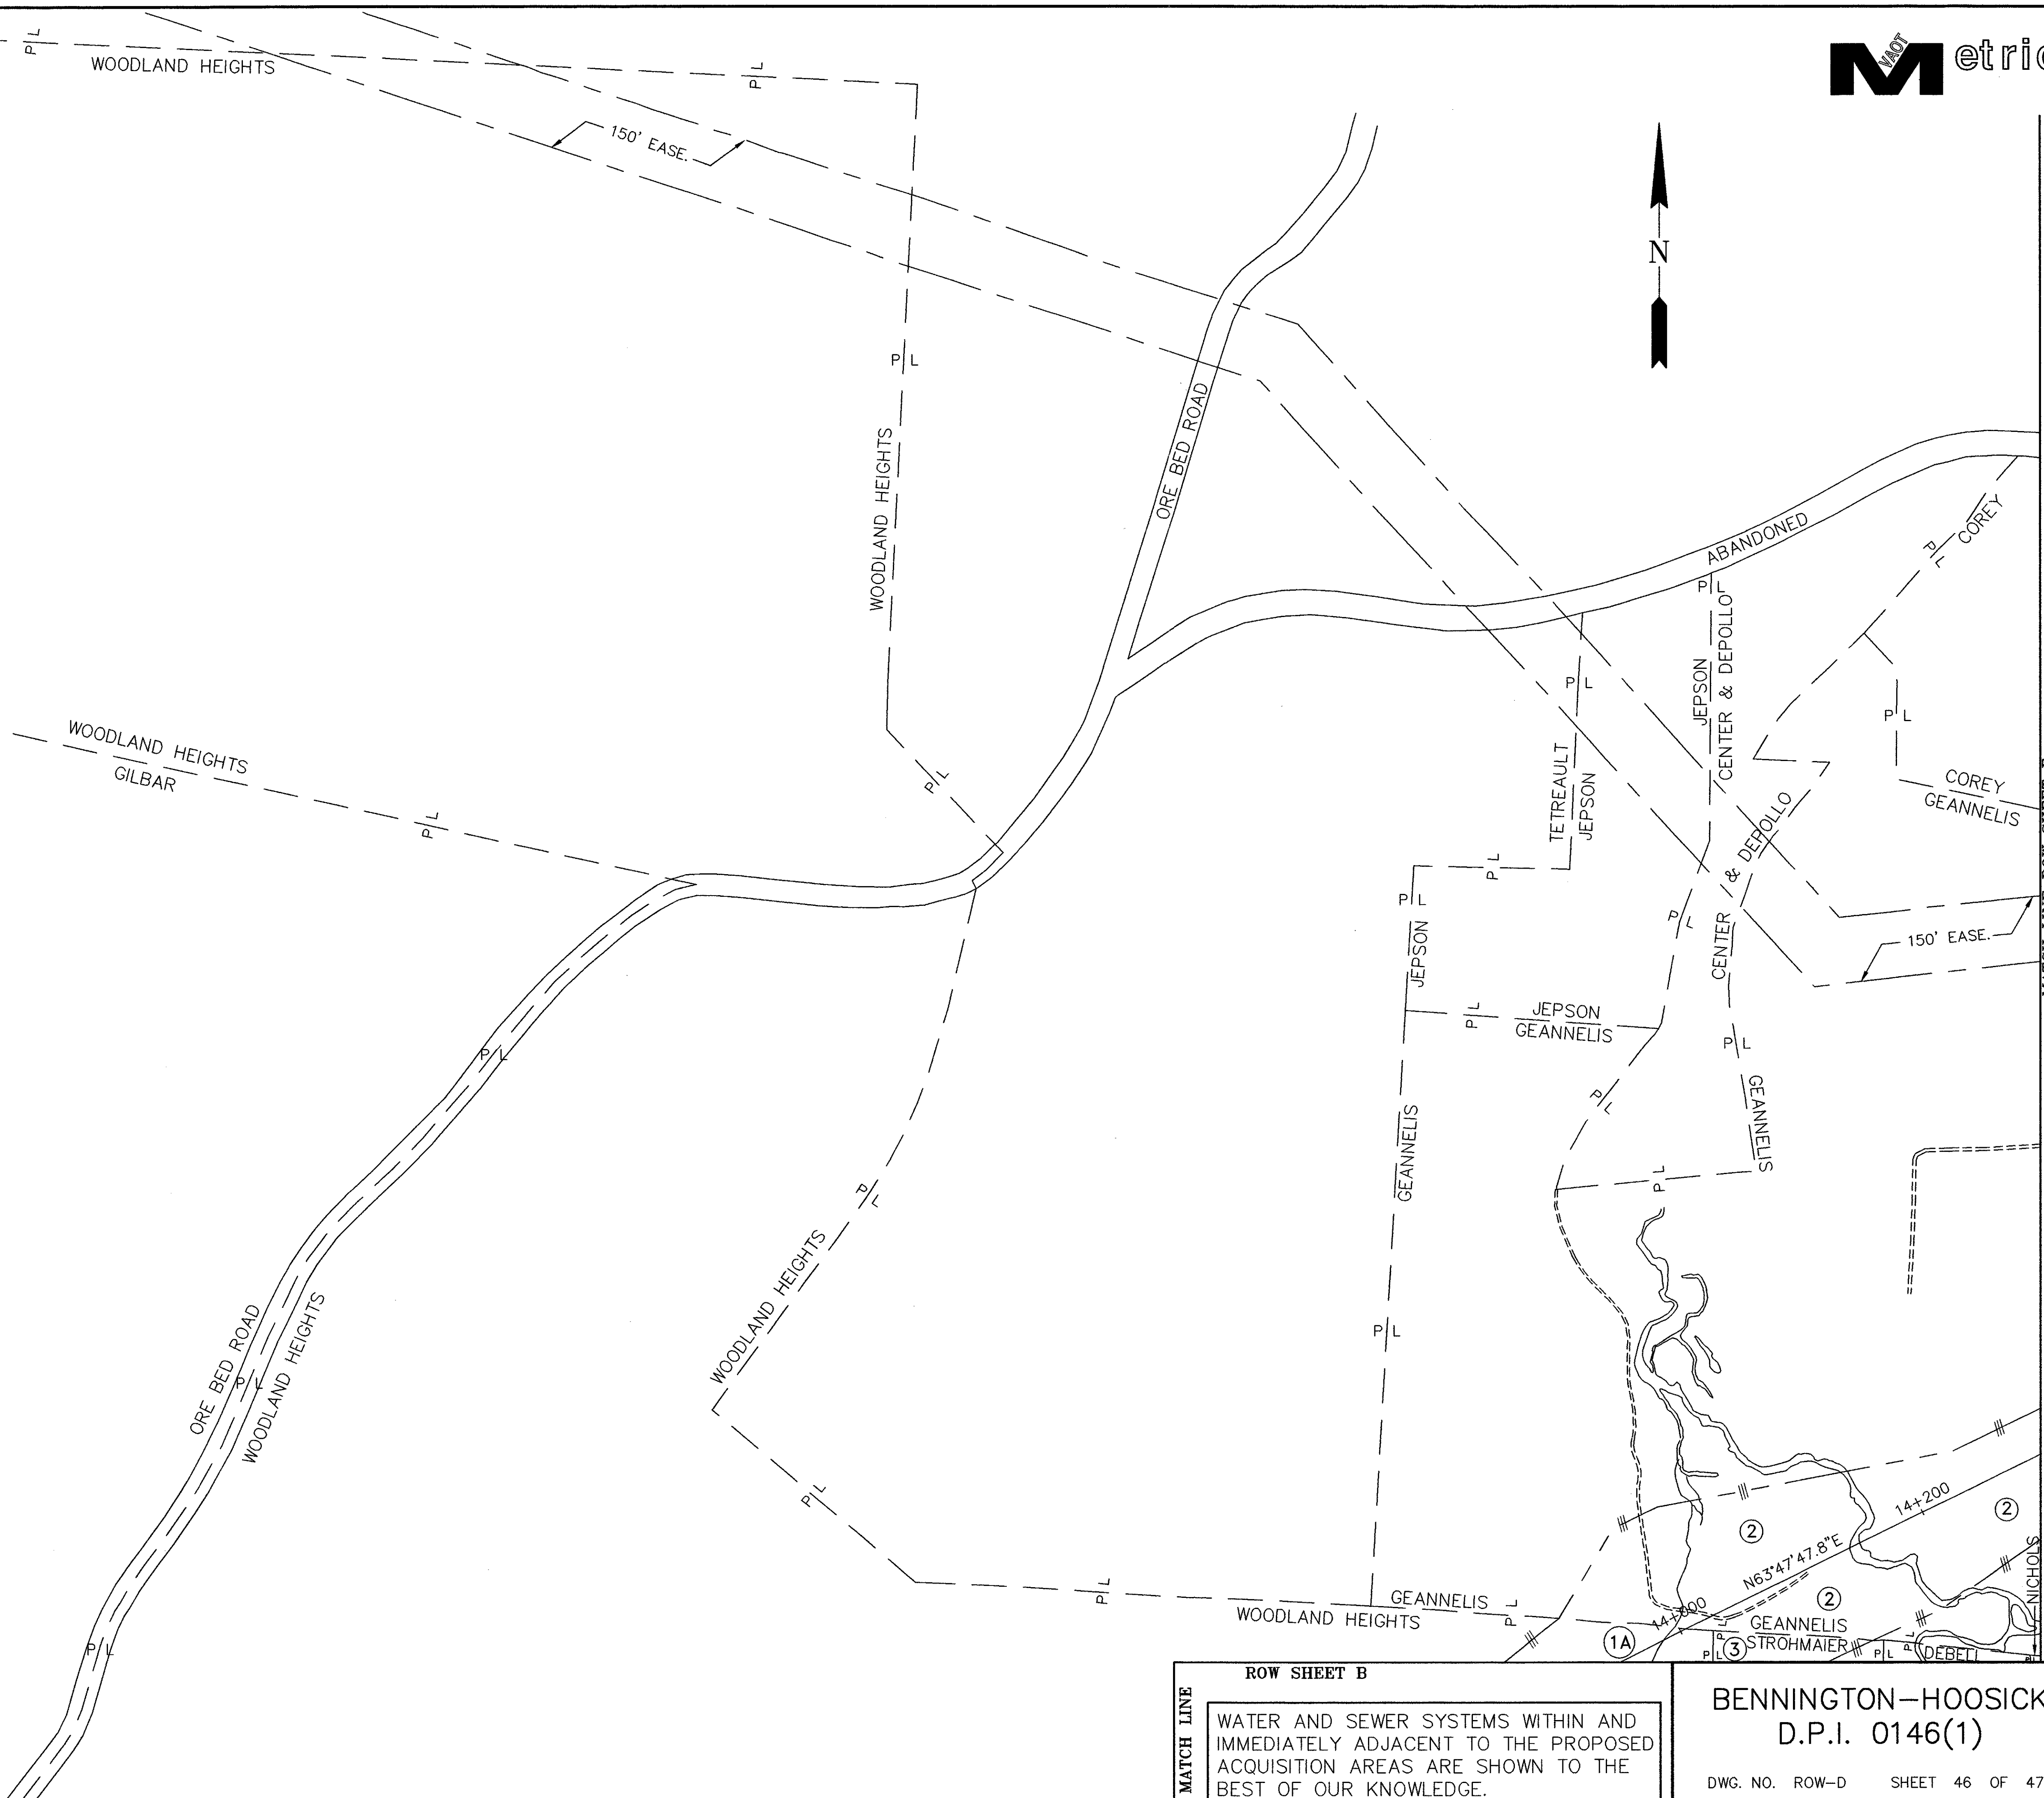

MATCH LINE ROW SHEET A

ROW SHEET B
MATCH LINE
WATER AND SEWER SYSTEMS WITHIN AND IMMEDIATELY ADJACENT TO THE PROPOSED ACQUISITION AREAS ARE SHOWN TO THE BEST OF OUR KNOWLEDGE.

BENNINGTON-HOOSICK
D.P.I. 0146(1)

DWG. NO. ROW-D SHEET 46 OF 473
SCALE: 1" = 200' (1" = 60.96 m)