



TYPICAL SECTIONS - TEMPORARY WEIGH STATION

MATERIAL ITEM	THICKNESS TOLERANCE	THICKNESS	DESCRIPTION
PAVEMENT COURSES (TOTAL DEPTH)	± 5	130	SUPERPAVE BITUMINOUS CONCRETE PAVEMENT (PG 58-28) (50 TYPE III'S, 80 TYPE II'S)
BASE COURSES (TOTAL DEPTH)	± 10	100	BASE COURSE, SUPERPAVE BITUMINOUS CONCRETE (PG 58-28), TYPE 1S
SUBBASE	± 30	600	SUBBASE OF CRUSHED GRAVEL (COARSE GRADED)
SAND BORROW	± 30	400	SAND BORROW
		NOTE:	DESIGN FROST DEPTH - 1200

- NOTES:**
- FOR SLOPES IN SOLID ROCK EXCAVATION AND DRILLING AND BLASTING OF SOLID ROCK SUBGRADE, SEE STANDARD SHEET A-60M.
 - SEE DWG. NO. MD-1 FOR TEMPORARY WEIGH STATION RAISED ISLAND DETAIL SHEET.
 - FOR ADDITIONAL DETAILS REGARDING ULTIMATE EASTBOUND CONSTRUCTION, SEE TYPICAL SECTIONS ON DWG. NOS. TS-1 AND TS-2 AND CROSS SECTIONS.
 - SEE TEMPORARY WEIGH STATION GRADING PLAN, DWG. NO. GP-1 TO GP-5.

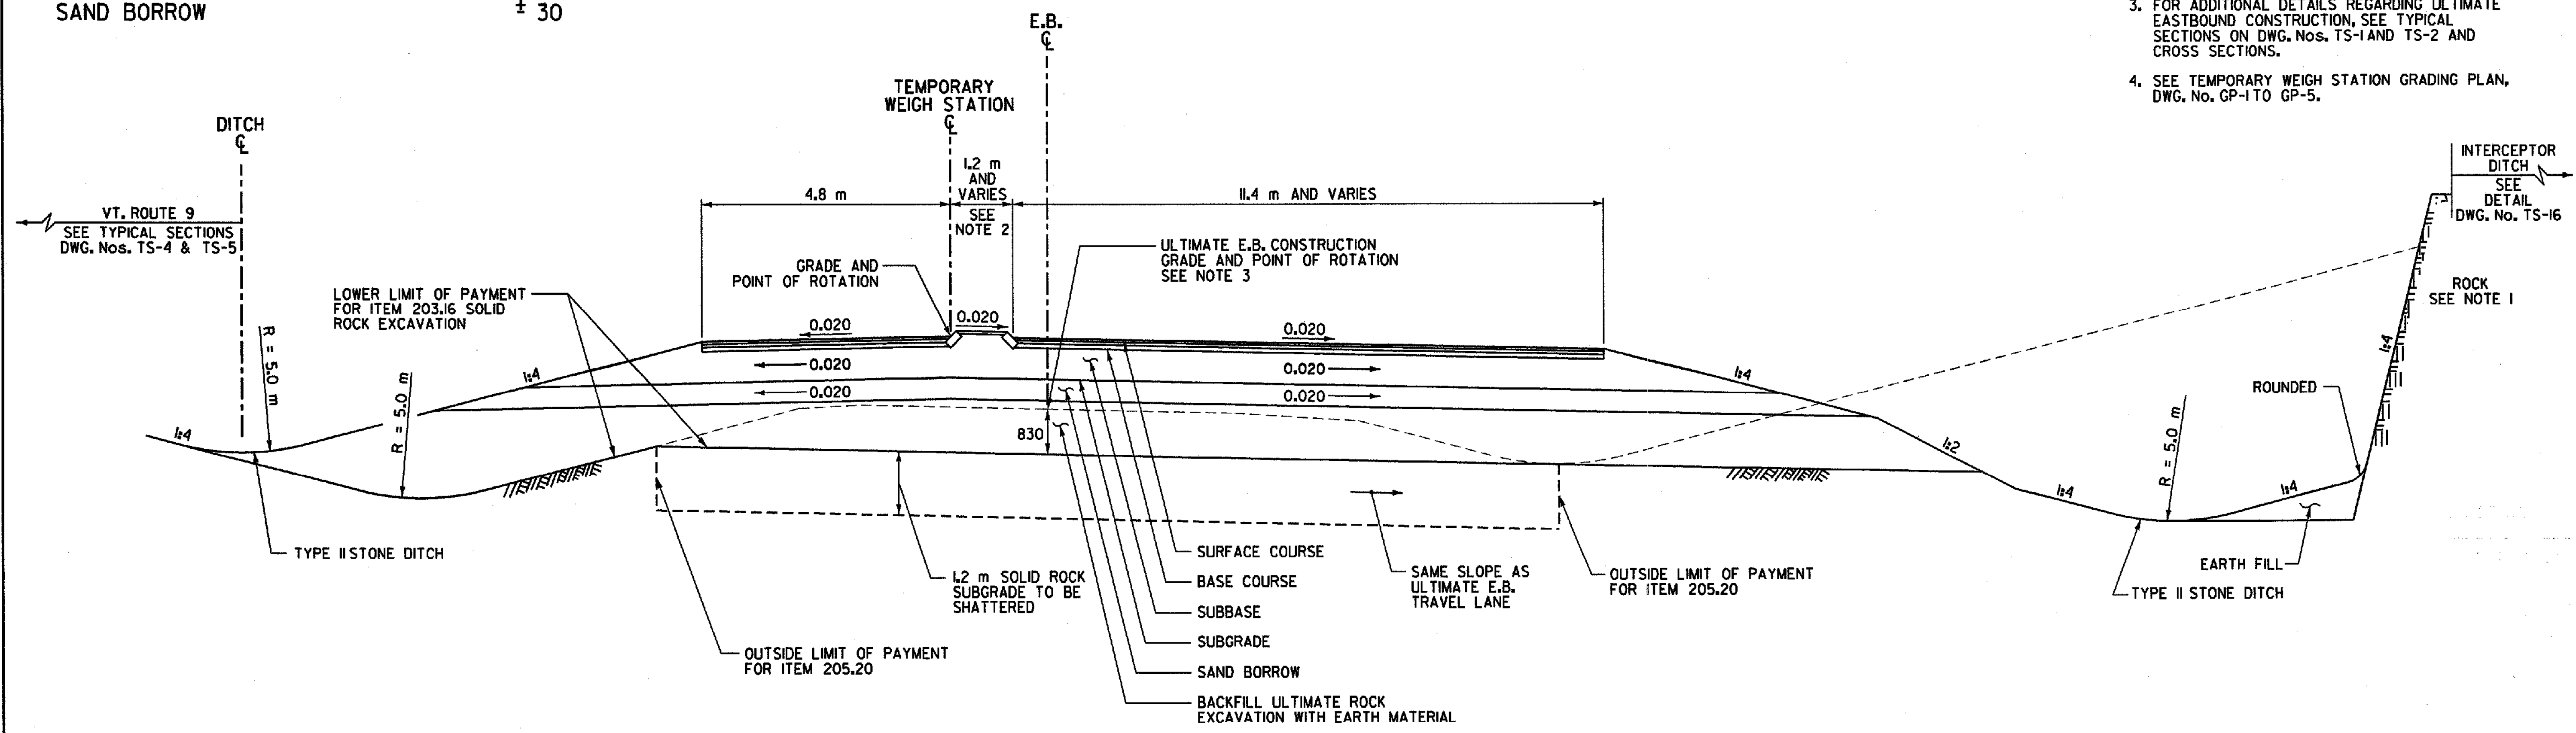

**TEMPORARY WEIGH STATION
STA. 12+900.000 - STA. 13+400.000**

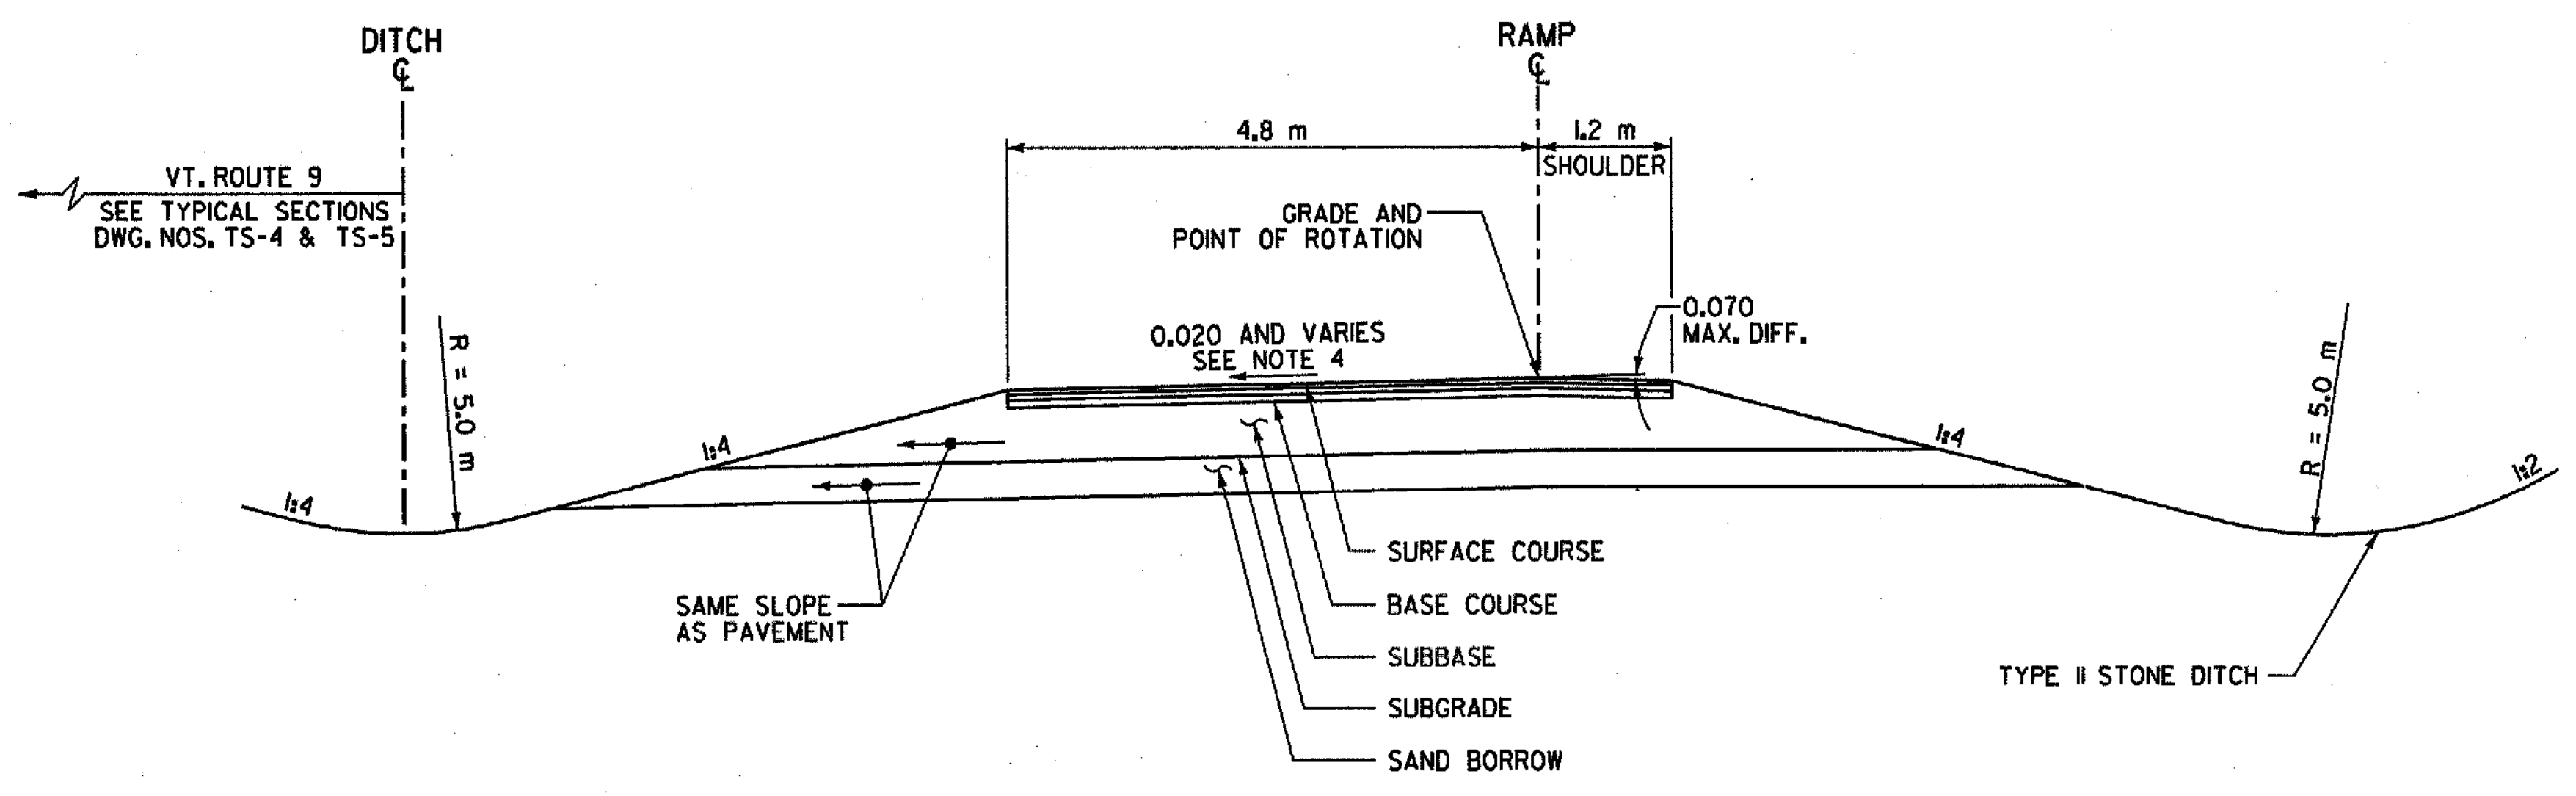

**TEMPORARY WEIGH STATION RAMP
STA. 12+735.000 - STA. 12+900.000
STA. 13+400.000 - STA. 13+540.000**

AS-BUILT NOTE: REFERENCE REVISED PLAN SHEETS 76 - 78, DATED 01/03, FOR CHANGES IN ROCK CUT, SLOPE GRADING AND INTERCEPTOR DITCH LOCATIONS.

RMT 2/1/06

ALL DIMENSIONS IN MILLIMETERS EXCEPT WHERE OTHERWISE INDICATED.

TYPICAL SECTION SHEET	SURVEYED BY	C.H.A. & V.S.E.	DATE	12/93
	DESIGNED BY	D.E.G.	DATE	11/01
	DRAWN BY	J.N.	DATE	11/01
	CHECKED BY	T.P.K.	DATE	11/01
	DESIGN FILE NO.	5116/VAOT/TS-13.DGN		
PROJ. NAME	BENNINGTON - HOOSICK			
PROJ. NO.	P.I.N. 1306.60			
DWG No. TS-13	SHEET 61 OF 473			

FILE NAME = u:\5116\VAOT\CONTRACT3\TS-13.dgn
 DATE/TIME = 10/15/2001
 USER = 664