



TYPICAL SECTIONS - MISCELLANEOUS DETAILS

NOTE:

1. SEE STANDARD SHEET A-60M FOR SLOPES IN SOLID ROCK EXCAVATION.

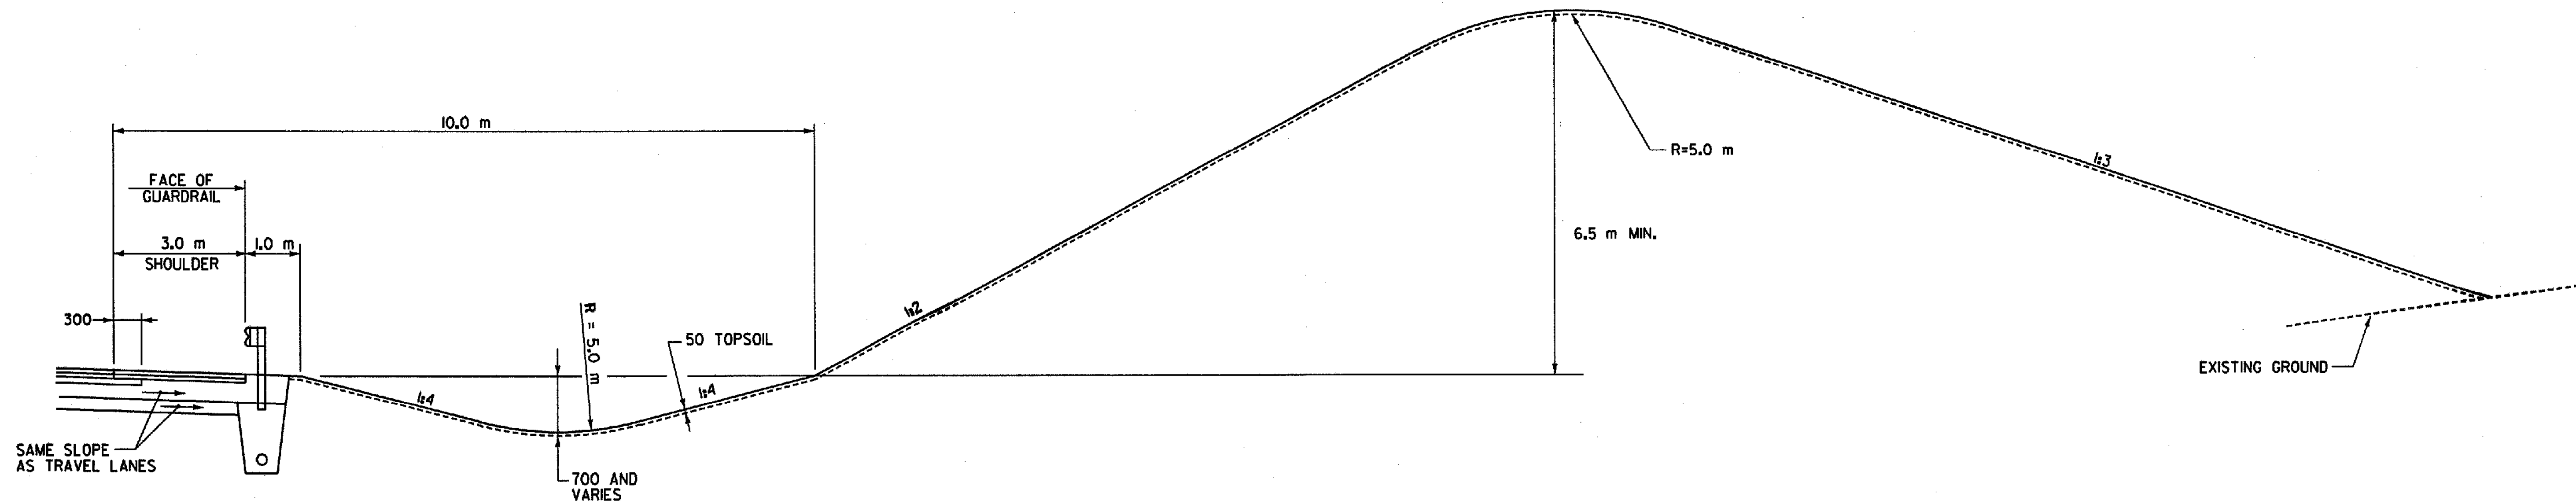

SIGHT BERM DETAIL (SEE AS-BUILT NOTE ON THIS SHEET)
N.T.S.

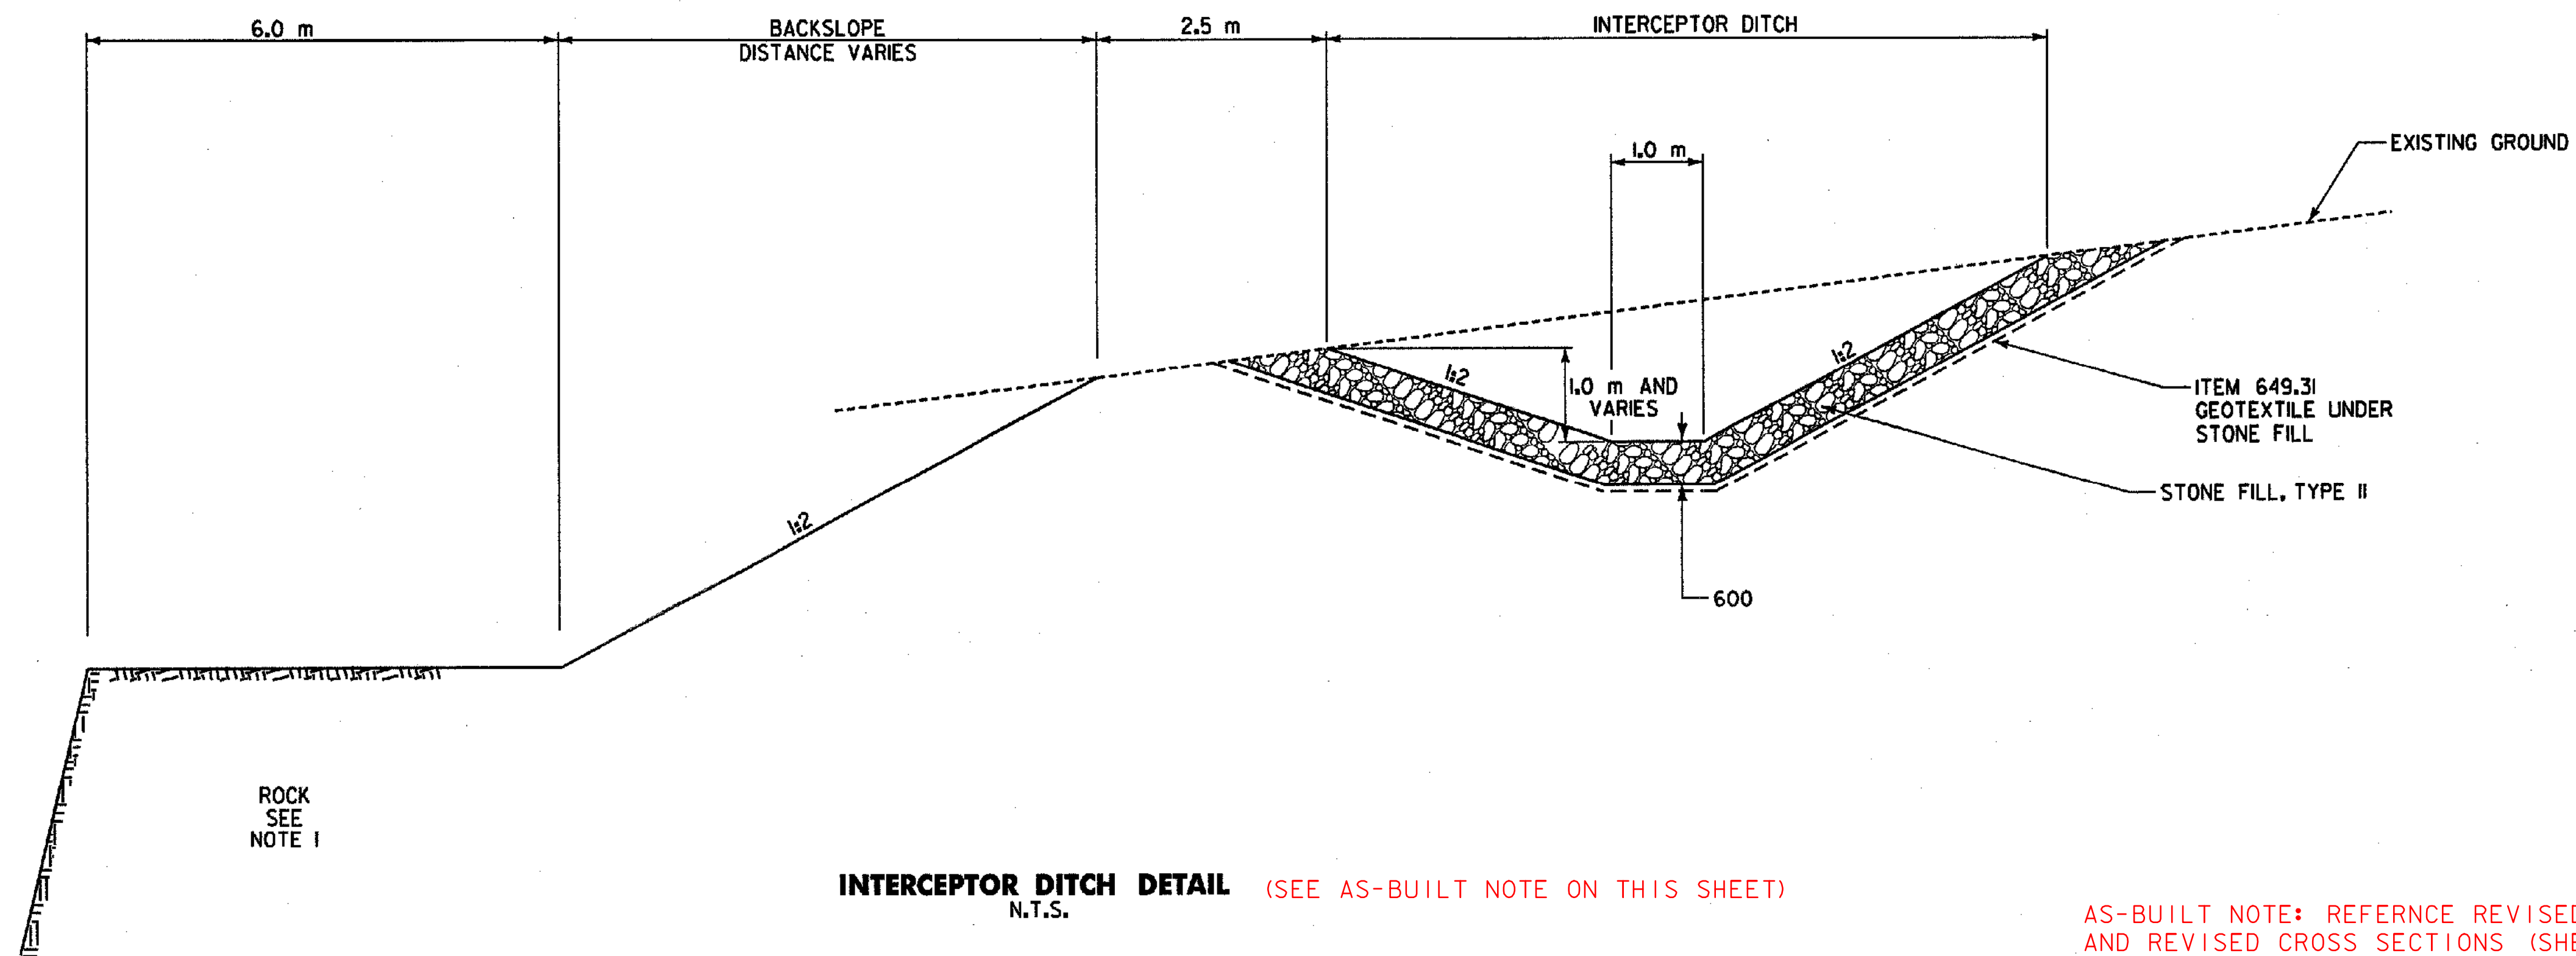

INTERCEPTOR DITCH DETAIL (SEE AS-BUILT NOTE ON THIS SHEET)
N.T.S.

AS-BUILT NOTE: REFERENCE REVISED SIGHT BERM GRADING PLAN AND REVISED CROSS SECTIONS (SHEETS 1 - 8), DATED 01/03 AND REVISED PLAN SHEETS 76 AND 77, DATED 08/02 AND 01/03 FOR CHANGES IN SIGHT BERM AND INTERCEPTOR TRENCH, RESPECTIVELY

RMT 2/1/06

ALL DIMENSIONS IN MILLIMETERS EXCEPT WHERE OTHERWISE INDICATED.

FILE NAME =H:\5116\VAOT\CONTRACT3\TS-16.dgn
DATE/TIME =10/11/2001
USER =GG4

TYPICAL SECTION SHEET

SURVEYED BY	C.H.A. & V.S.E.	DATE	12/93
DESIGNED BY	D.E.G.	DATE	11/01
DRAWN BY	J.N.	DATE	11/01
CHECKED BY	T.P.K.	DATE	11/01
DESIGN FILE NO.	5116/VAOT/TS-16.DGN		
PROJ. NAME	BENNINGTON - HOOSICK D.P.L. 0146(1) C/3		
PROJ. NO.	P.J.N. 1306.60		
DWG No.	TS-16	SHEET	64 OF 473