


FILE NAME = ut\5116\VA01\CONTRACT3\gl.dgn
 DATE/TIME = 10/11/2001
 USER = 664

DATUM	
VERTICAL	NAVD 88
HORIZONTAL	NAD 83 (1992)

END BENNINGTON - HOOSICK D.P.J. 0146(I) C/2
 BEGIN BENNINGTON - HOOSICK D.P.J. 0146(I) C/3
 BEGIN ROADWAY
 STA. 12+130.455

N.Y. ROUTE 7 - CONSTRUCTED BY OTHERS UNDER
 BENNINGTON - HOOSICK D.P.J. 0146(I) C/2 CONTRACT

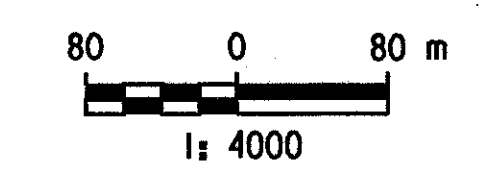

GENERAL PLAN	SURVEYED BY	C.H.A. & V.S.E.	DATE	12/93
	DESIGNED BY	D.E.G.	DATE	11/01
	DRAWN BY	T.J.B.	DATE	11/01
	CHECKED BY	T.P.K.	DATE	11/01
	DESIGN FILE NO.	GLDGN		
PROJ. NAME	BENNINGTON - HOOSICK D.P.J. 0146(I) C/3			
PROJ. NO.	P.I.N. 1306.60			
DWG NO. G-1				SHEET 66 OF 473