


FILE NAME = \\s116\VAOT\CONTRACT3\92.dgn
 DATE/TIME = 10/15/2001
 USER = 664

DATUM	
VERTICAL	NAVD 88
HORIZONTAL	NAD 83 (1992)

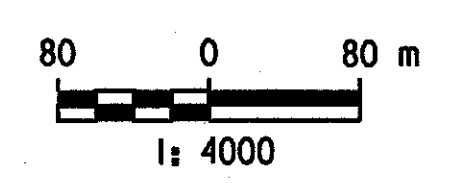

GENERAL PLAN	SURVEYED BY	C.H.A. & V.S.E.	DATE	12/93
	DESIGNED BY	D.E.G.	DATE	11/01
	DRAWN BY	T.J.B.	DATE	11/01
	CHECKED BY	T.P.K.	DATE	11/01
DESIGN FILE NO.	G2.DGN			
PROJ. NAME	BENNINGTON - HOOSICK D.P.I. 0146(1) C/3			
PROJ. NO.	P.I.N. 1306.60			
DWG NO. G-2	SHEET 67 OF 473			