


BASELINE TIES

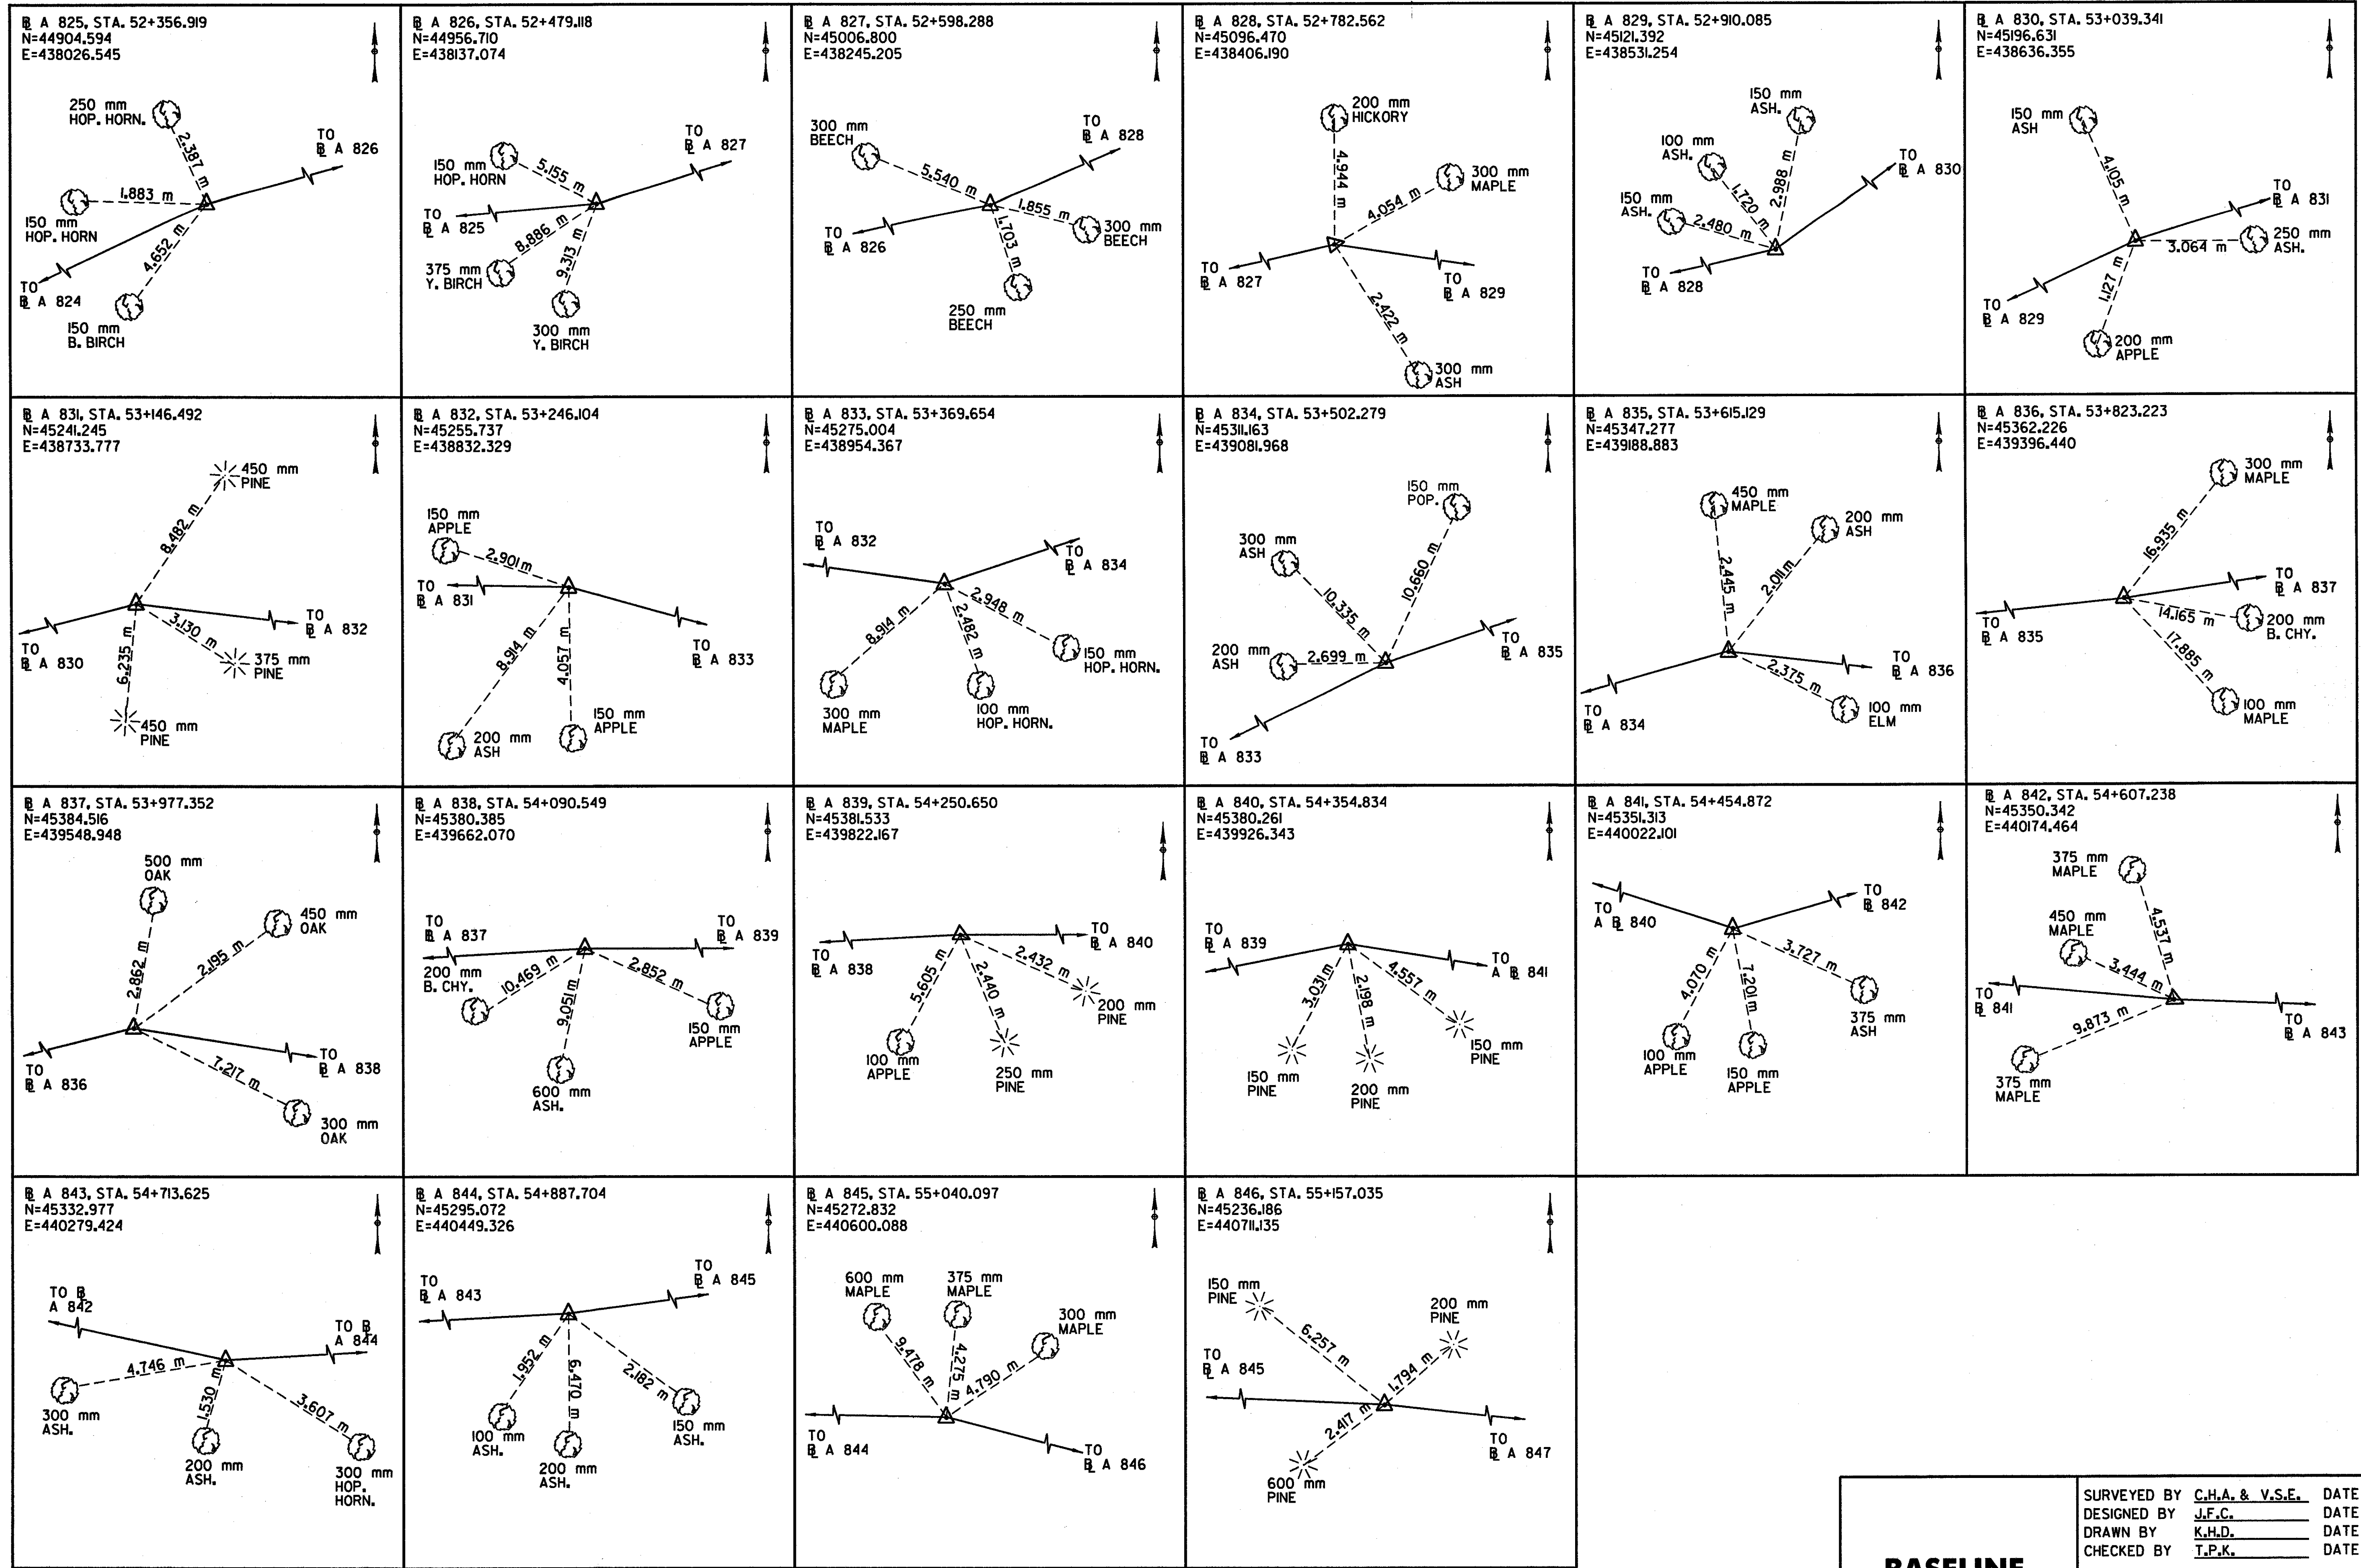

FILE NAME = \\N:\116\VA001\CONTRACT3\bl_tie.dgn
 DATE/TIME = 10/11/2001
 USER = 664

DATUM

VERTICAL	NAVD 88
HORIZONTAL	NAD 83 (1992)

BASELINE TIES

SURVEYED BY	C.H.A. & V.S.E.	DATE	12/93
DESIGNED BY	J.F.C.	DATE	11/01
DRAWN BY	K.H.D.	DATE	11/01
CHECKED BY	T.P.K.	DATE	11/01
DESIGN FILE NO.	/5116/BL-TIE.dgn		
PROJ. NAME	BENNINGTON - HOOSICK D.P.I. 0146(1) C/3		
PROJ. NO.	P.I.N. 1306.60		
DWG NO.	BL-2	SHEET	72 OF 473