


FILE NAME = c:\5116\VAOT\CONTRACT3\layout.dgn
 DATE/TIME = 10/11/2001
 USER = 664

| | |
|------------|---------------|
| DATUM | |
| VERTICAL | NAVD 88 |
| HORIZONTAL | NAD 83 (1992) |

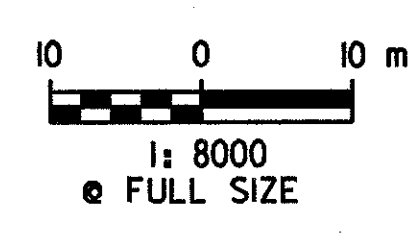

| | | | | |
|------------------------|---|-----------------|------|-------|
| LAYOUT KEY PLAN | SURVEYED BY | C.H.A. & V.S.E. | DATE | 12/93 |
| | DESIGNED BY | D.E.G. | DATE | 11/01 |
| | DRAWN BY | T.J.B. | DATE | 11/01 |
| | CHECKED BY | T.P.K. | DATE | 11/01 |
| DESIGN FILE NO. | | LAYOUT.DGN | | |
| PROJ. NAME | BENNINGTON - HOOSICK D.P.J. 0146(1) C/3 | | | |
| PROJ. NO. | P.I.N. 1306.60 | | | |
| DWG NO. L-1 | SHEET 73 OF 473 | | | |