


FILE NAME = \\S116\VAOT\CONTRACT3\VT\8A.DGN
DATE/TIME = 10/15/2001
USER = 664

DATUM	
VERTICAL	NAVD 88
HORIZONTAL	NAD 83 (1992)

620.25 WOVEN WIRE FENCE WITH STEEL POSTS	
STA. 45+086.488 - STA. 45+099.926	RT (19.3 m)
STA. 45+086.488 - STA. 45+154.659	RT (68.2 m)
STA. 12+130.455 - STA. 12+300.000	RT (166.1 m)
STA. 12+151.987 - STA. 12+175.252	LT (32.9 m)
STA. 12+175.252 - STA. 12+260.000	LT (84.7 m)
STA. 12+260.000 - STA. 12+280.000	LT (25.0 m)
STA. 12+280.000 - STA. 12+420.000	LT (140.0 m)
STA. 12+300.000 - STA. 12+420.000	RT (102.9 m)

620.40 STEEL BRACE FOR WOVEN WIRE FENCE	
STA. 45+086.488	RT (2 EA)
STA. 45+099.926	RT (1 EA)
STA. 12+151.987	LT (1 EA)
STA. 12+175.252	LT (2 EA)
STA. 12+179.000	RT (2 EA)
STA. 12+260.000	LT (2 EA)
STA. 12+280.000	LT (2 EA)
STA. 12+300.000	RT (2 EA)

649.11 GEOTEXTILE FOR ROADBED SUBGRADE SEPARATOR	
STA. 12+130.455 - STA. 12+420.000	(1665 m ²)

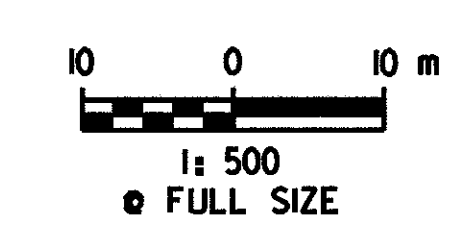

NOTE:
1. ITEM 649.11 GEOTEXTILE FOR ROADBED SUBGRADE SEPARATOR SHALL BE PLACED BY THE CONTRACTOR AS DIRECTED BY THE RESIDENT ENGINEER.

PLAN	SURVEYED BY	C.H.A. & V.S.E.	DATE	12/93
	DESIGNED BY	D.E.G.	DATE	11/01
	DRAWN BY	J.S.L.	DATE	11/01
	CHECKED BY	T.P.K.	DATE	11/01
	DESIGN FILE NO.	/S116/vaot/vtp8a.dgn		
	PROJ. NAME	BENNINGTON - HOOSICK D.P.J. 0146(I) C/3		
PROJ. NO.	P.I.N. 1306.60			
DWG NO. P-1	SHEET 74 OF 473			