


FILE NAME = \\S:\1616\VAOT\CONTRACT3\VTPRF8.DGN  
 DATE/TIME = 10/11/2001  
 USER = 664

DATUM  
 VERTICAL NAVD 88  
 HORIZONTAL NAD 83 (1992)

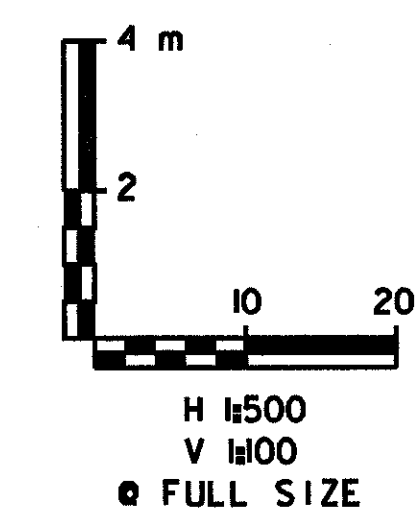

**PROFILE  
 VT. ROUTE 9**

SURVEYED BY C.H.A. & V.S.E. DATE 12/93  
 DESIGNED BY D.E.G. DATE 11/01  
 DRAWN BY J.S.L. DATE 11/01  
 CHECKED BY T.P.K. DATE 11/01  
 DESIGN FILE NO. /5116/vaot/vtprf8  
 PROJ. NAME BENNINGTON - HOOSICK  
 D.P.I. 0146(1) C/3  
 PROJ. NO. P.I.N. 1306.60  
 DWG NO. PF-2 SHEET 89 OF 473