


FILE NAME = \\5116\VA01\CONTRACT3\VT\PRF9.DGN
 DATE/TIME = 10/11/2001
 USER = 664

DATUM	
VERTICAL	NAVD 88
HORIZONTAL	NAD 83 (1992)

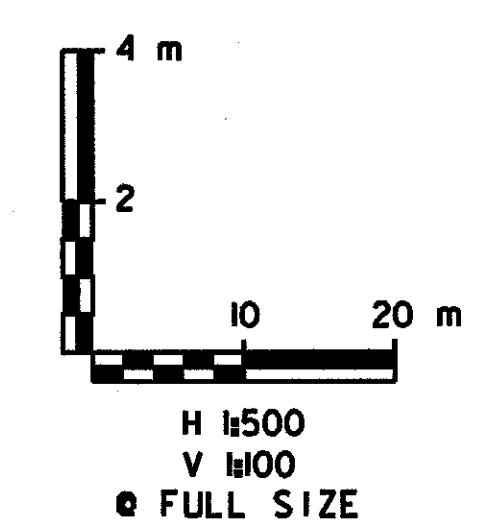

**PROFILE
VT. ROUTE 9**

SURVEYED BY	C.H.A. & V.S.E.	DATE	12/93
DESIGNED BY	D.E.G.	DATE	11/01
DRAWN BY	J.S.L.	DATE	11/01
CHECKED BY	T.P.K.	DATE	11/01

DESIGN FILE NO. /5116/prf9.dgn

PROJ. NAME BENNINGTON - HOOSICK
D.P.L. 0146(I) C/3

PROJ. NO. P.I.N. 1306.60

DWG NO. PF-3 SHEET 90 OF 473