


FILE NAME = \\5116\VAOT\CONTRACT3\VT\PRF10.DGN
 DATE/TIME = 10/11/2001
 USER = 664

DATUM	
VERTICAL	NAVD 88
HORIZONTAL	NAD 83 (1992)

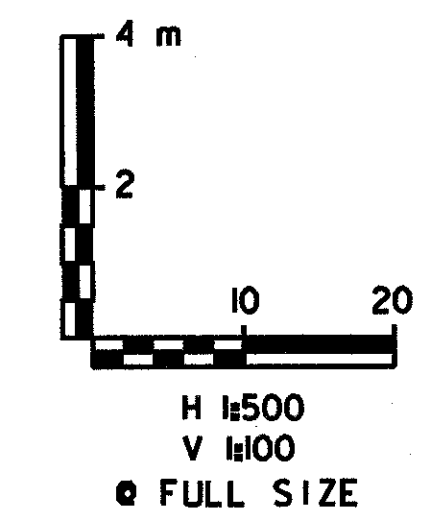

PROFILE VT. ROUTE 9		SURVEYED BY	C.H.A. & V.S.E.	DATE	12/93
		DESIGNED BY	D.E.G.	DATE	11/01
		DRAWN BY	J.S.L.	DATE	11/01
		CHECKED BY	T.P.K.	DATE	11/01
DESIGN FILE NO.		/516/prf10.dgn			
PROJ. NAME		BENNINGTON - HOOSICK D.P.J. 01460) C/3			
PROJ. NO.		P.I.N. 1306.60			
DWG NO. PF-4		SHEET 91 OF 473			