

LEVEL
+0.080
+0.060
+0.040
+0.020
0.000
-0.020
-0.040
-0.060
-0.080

MATCH LINE STA. 13+360.000 DWG. PF-4

MATCH LINE STA. 13+710.000 DWG. PF-6


e = +0.021 LEFT E.O.P.
GRADE
e = -0.021 RIGHT E.O.P.

GRADE
e = -0.020 LEFT AND RIGHT E.O.P.

P.I.
STA. 13+538.666

FILE NAME = H:\5116\VAOT\CONTRACT3\VT\PRF11.DGN
DATE/TIME = 10/11/2001
USER = 664

DATUM
VERTICAL NAVD 88
HORIZONTAL NAD 83 (1992)

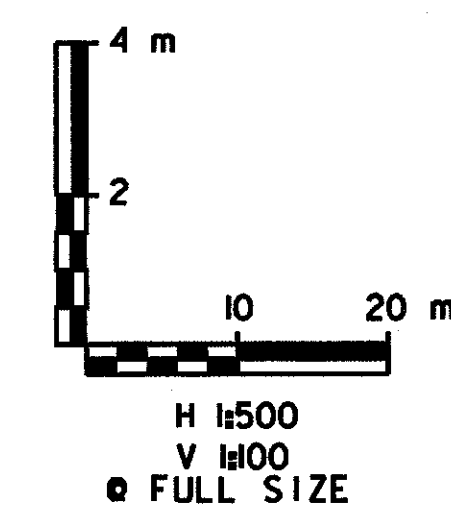

PROFILE VT. ROUTE 9

SURVEYED BY C.H.A. & V.S.E. DATE 12/93
 DESIGNED BY D.E.G. DATE 11/01
 DRAWN BY J.S.L. DATE 11/01
 CHECKED BY T.P.K. DATE 11/01

DESIGN FILE NO. /5116/pr.fil.dgn

PROJ. NAME BENNINGTON - HOOSICK
D.P.I. 01461) C/3
 PROJ. NO. P.I.N. 1306.60
 DWG NO. PF-5 SHEET 92 OF 473