


DATUM
 VERTICAL NAVD 88
 HORIZONTAL NAD 83 (1992)

PROFILE VT. ROUTE 9

SURVEYED BY	C.H.A. & V.S.E.	DATE	12/93
DESIGNED BY	D.E.G.	DATE	11/01
DRAWN BY	J.S.L.	DATE	11/01
CHECKED BY	T.P.K.	DATE	11/01

DESIGN FILE NO. /5116/prf14.dgn
 PROJ. NAME BENNINGTON - HOOSICK
 D.P.I. 0146(1) C/3
 PROJ. NO. P.I.N. 1306.60
 DWG NO. PF-8 SHEET 95 OF 473

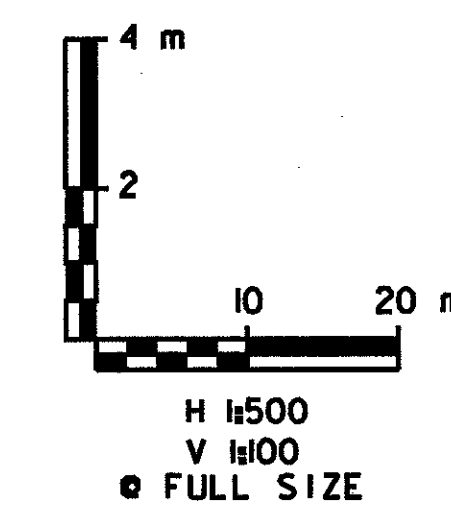

FILE NAME = I:\5116\VAOT\CONTRACT3\VTPRF14.DGN
 DATE/TIME = 09/11/2001
 USER = 684