


FILE NAME = \\S116\VAOT\CONTRACT3\VT\PRF15.DGN
 DATE/TIME = 10/11/2001
 USER = 664

DATUM
 VERTICAL NAVD 88
 HORIZONTAL NAD 83 (1992)

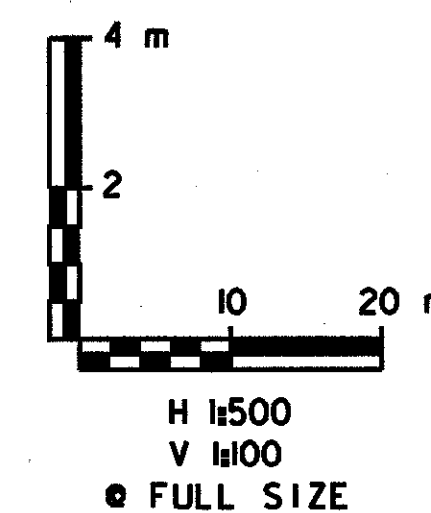

<h3>PROFILE VT. ROUTE 9</h3>		SURVEYED BY C.H.A. & V.S.E. DATE 12/93
		DESIGNED BY D.E.G. DATE 11/01
		DRAWN BY J.S.L. DATE 11/01
		CHECKED BY T.P.K. DATE 11/01
DESIGN FILE NO. /5116/pr f15.dgn		PROJ. NAME BENNINGTON - HOOSICK D.P.J. 0146(I) C/3
		PROJ. NO. P.I.N. 1306.60
		DWG NO. PF-9 SHEET 96 OF 473