


LEVEL
+0.080
+0.060
+0.040
+0.020
GRADE
-0.020
-0.040
-0.060
-0.080

e = +0.020 LEFT E.O.P.
GRADE
e = -0.020 RIGHT E.O.P.

FILE NAME = \\s116\VAOT\CONTRACTS\VT\PRF17.DGN
DATE/TIME = 10/11/2001
USER = 664

DATUM
VERTICAL NAVD 88
HORIZONTAL NAD 83 (1992)

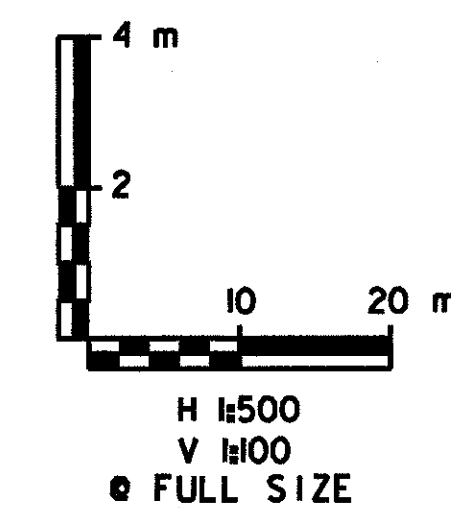

**PROFILE
VT. ROUTE 9**

SURVEYED BY	C.H.A. & V.S.E.	DATE	12/93
DESIGNED BY	D.E.G.	DATE	11/01
DRAWN BY	J.S.L.	DATE	11/01
CHECKED BY	T.P.K.	DATE	11/01

DESIGN FILE NO. /5116/prf17.dgn

PROJ. NAME BENNINGTON - HOOSICK
D.P.I. 0146(I) C/3

PROJ. NO. P.I.N. 1306.60

DWG NO. PF-11 SHEET 98 OF 473