

MATCH LINE STA. 15+870.000 DWG. PF-11


MATCH LINE STA. 16+170.000 DWG. PF-13

P.V.I. STA. 15+987.570
 ELEV. = 226.930
 L.V.C. = 660.000 m
 M.O. = -4.777 m
 S.S.D. = 215 m
 K = 114

LEVEL
 +0.080
 +0.060
 +0.040
 +0.020
 GRADE
 e = +0.020 LEFT E.O.P.
 e = -0.020 RIGHT E.O.P.
 -0.020
 -0.040
 -0.060
 -0.080

FILE NAME = \\VA01\CONTRACT3\VT\PRF18.DGN
 DATE/TIME = 10/11/2001
 USER = 664

DATUM
 VERTICAL NAVD 88
 HORIZONTAL NAD 83 (1992)

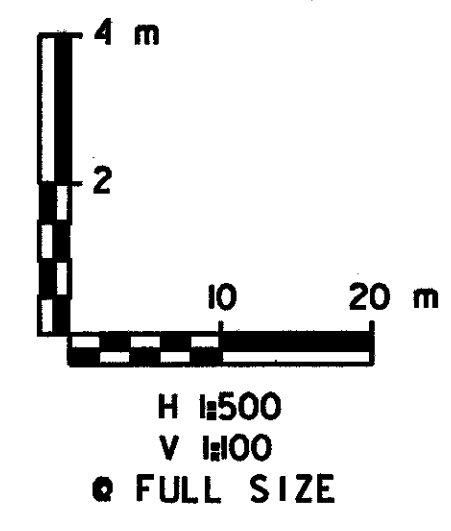

PROFILE VT. ROUTE 9

SURVEYED BY	C.H.A. & V.S.E.	DATE	12/93
DESIGNED BY	D.E.G.	DATE	11/01
DRAWN BY	J.S.L.	DATE	11/01
CHECKED BY	T.P.K.	DATE	11/01
DESIGN FILE NO.	/5116/prf18.dgn		
PROJ. NAME	BENNINGTON - HOOSICK D.P.L. 0146(1) C/3		
PROJ. NO.	P.L.N. 1306.60		
DWG. NO.	PF-12	SHEET	99 OF 473