



MATCH LINE STA. 16+170.000 DWG. PF-12

MATCH LINE STA. 16+490.000 DWG. PF-14

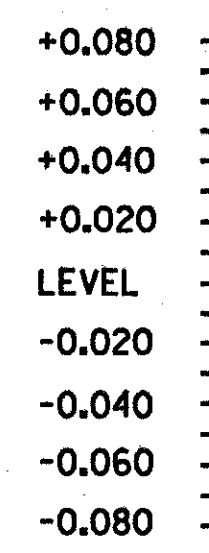

FILE NAME = \\5116\VAOT\CONTRACT3\VT\PRF19.DGN
DATE/TIME = 10/11/2001
USER = 664

DATUM	
VERTICAL	NAVD 88
HORIZONTAL	NAD 83 (1992)

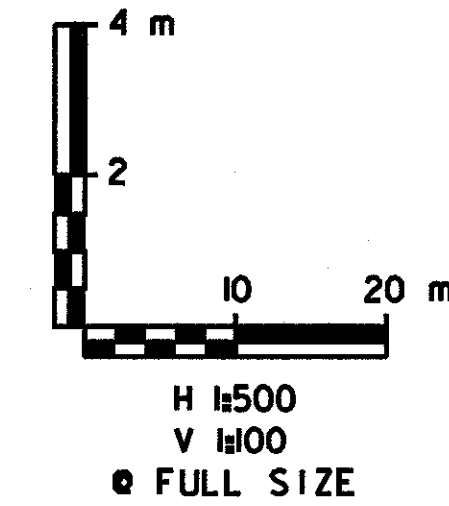

PROFILE VT. ROUTE 9		
SURVEYED BY	C.H.A. & V.S.E.	DATE 12/93
DESIGNED BY	D.E.G.	DATE 11/01
DRAWN BY	J.S.L.	DATE 11/01
CHECKED BY	T.P.K.	DATE 11/01
DESIGN FILE NO.	/5116/pr-f19.dgn	
PROJ. NAME	BENNINGTON - HOOSICK D.P.J. 0146(i) C/3	
PROJ. NO.	P.I.N. 1306.60	
DWG NO. PF-13	SHEET 100 OF 473	