


FILE NAME = \\5116\VAOT\CONTRACT3\VT\PRF20.DGN
 DATE/TIME = 10/11/2001
 USER = 664

DATUM	
VERTICAL	NAVD 88
HORIZONTAL	NAD 83 (1992)

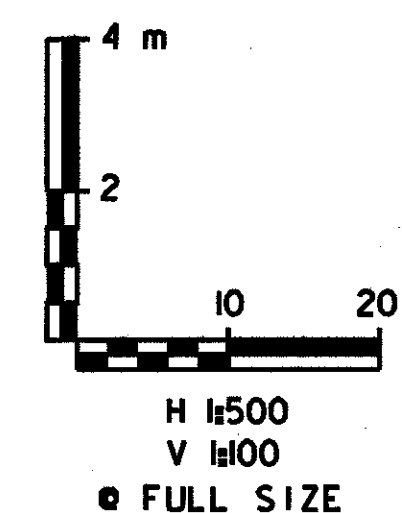

PROFILE VT. ROUTE 9	SURVEYED BY	C.H.A. & V.S.E.	DATE	12/93
	DESIGNED BY	D.E.G.	DATE	11/01
	DRAWN BY	J.S.L.	DATE	11/01
	CHECKED BY	T.P.K.	DATE	11/01
DESIGN FILE NO. /5116/pr-f20.dgn				
PROJ. NAME BENNINGTON - HOOSICK D.P.L. 0146(I) C/3				
PROJ. NO. P.L.N. 1306.60				
DWG NO. PF-14 SHEET 101 OF 473				