


FILE NAME = c:\5116\VAOT\CONTRACT3\VTGP1.dgn
 DATE/TIME = 10/11/2001
 USER = 884

DATUM	
VERTICAL	NAVD 88
HORIZONTAL	NAD 83 (1992)

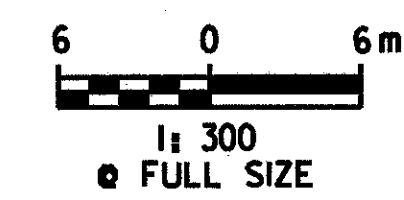

**TEMPORARY
WEIGH STATION
GRADING
PLAN**

SURVEYED BY	C.H.A. & V.S.E.	DATE	12/93
DESIGNED BY	D.E.G.	DATE	11/01
DRAWN BY	C.A.K.	DATE	11/01
CHECKED BY	T.P.K.	DATE	11/01
DESIGN FILE NO.	/5116/vaot/c/3/vtgp1.dgn		
PROJ. NAME	BENNINGTON - HOOSICK D.P.L. 0146(1) C/3		
PROJ. NO.	P.L.N. 1306.60		
DWG NO.	GP-1	SHEET	102 OF 473