


FILE NAME = \A\5116\VAOT\CONTRACT3\VTGP2.dgn
 DATE / TIME = 10/11/2001
 USER = 864

DATUM	
VERTICAL	NAVD 88
HORIZONTAL	NAD 83 (1992)

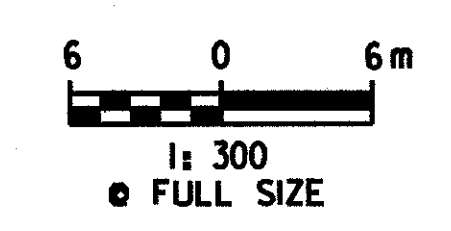

TEMPORARY WEIGH STATION GRADING PLAN	SURVEYED BY	C.H.A. & V.S.E.	DATE	12/93
	DESIGNED BY	D.E.G.	DATE	11/01
	DRAWN BY	C.A.K.	DATE	11/01
	CHECKED BY	T.P.K.	DATE	11/01
DESIGN FILE NO. /5116/vaot/c/3/vtgp1.dgn				
PROJ. NAME BENNINGTON - HOOSICK				
D.P.I. 0146(1) C/3				
PROJ. NO. P.I.N. 1306.60				
DWG NO. GP-2 SHEET 103 OF 473				