


FILE NAME = w:\5116\VAOT\CONTRACT3\VTGP4.dgn
 DATE/TIME = 10/11/2001
 USER = 664

| | |
|------------|--------------|
| DATUM | |
| VERTICAL | NAVD 88 |
| HORIZONTAL | NAD 83 (992) |

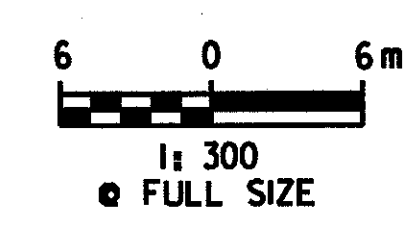

**TEMPORARY
WEIGH STATION
GRADING
PLAN**

| | | | |
|--|-----------------|------------------|-------|
| SURVEYED BY | C.H.A. & V.S.E. | DATE | 12/93 |
| DESIGNED BY | D.E.G. | DATE | 11/01 |
| DRAWN BY | C.A.K. | DATE | 11/01 |
| CHECKED BY | T.P.K. | DATE | 11/01 |
| DESIGN FILE NO. /5116/vaot/c/3/vtgp4.dgn | | | |
| PROJ. NAME BENNINGTON - HOOSICK | | | |
| D.P.I. 0146(i) C/3 | | | |
| PROJ. NO. P.I.N. 1306.60 | | | |
| DWG NO. GP-4 | | SHEET 105 OF 473 | |